


DUNHAM SURVEYING, S.C.
SURVEYING & SUBDIVIDING
DELAVER, WISCONSIN 53115

N

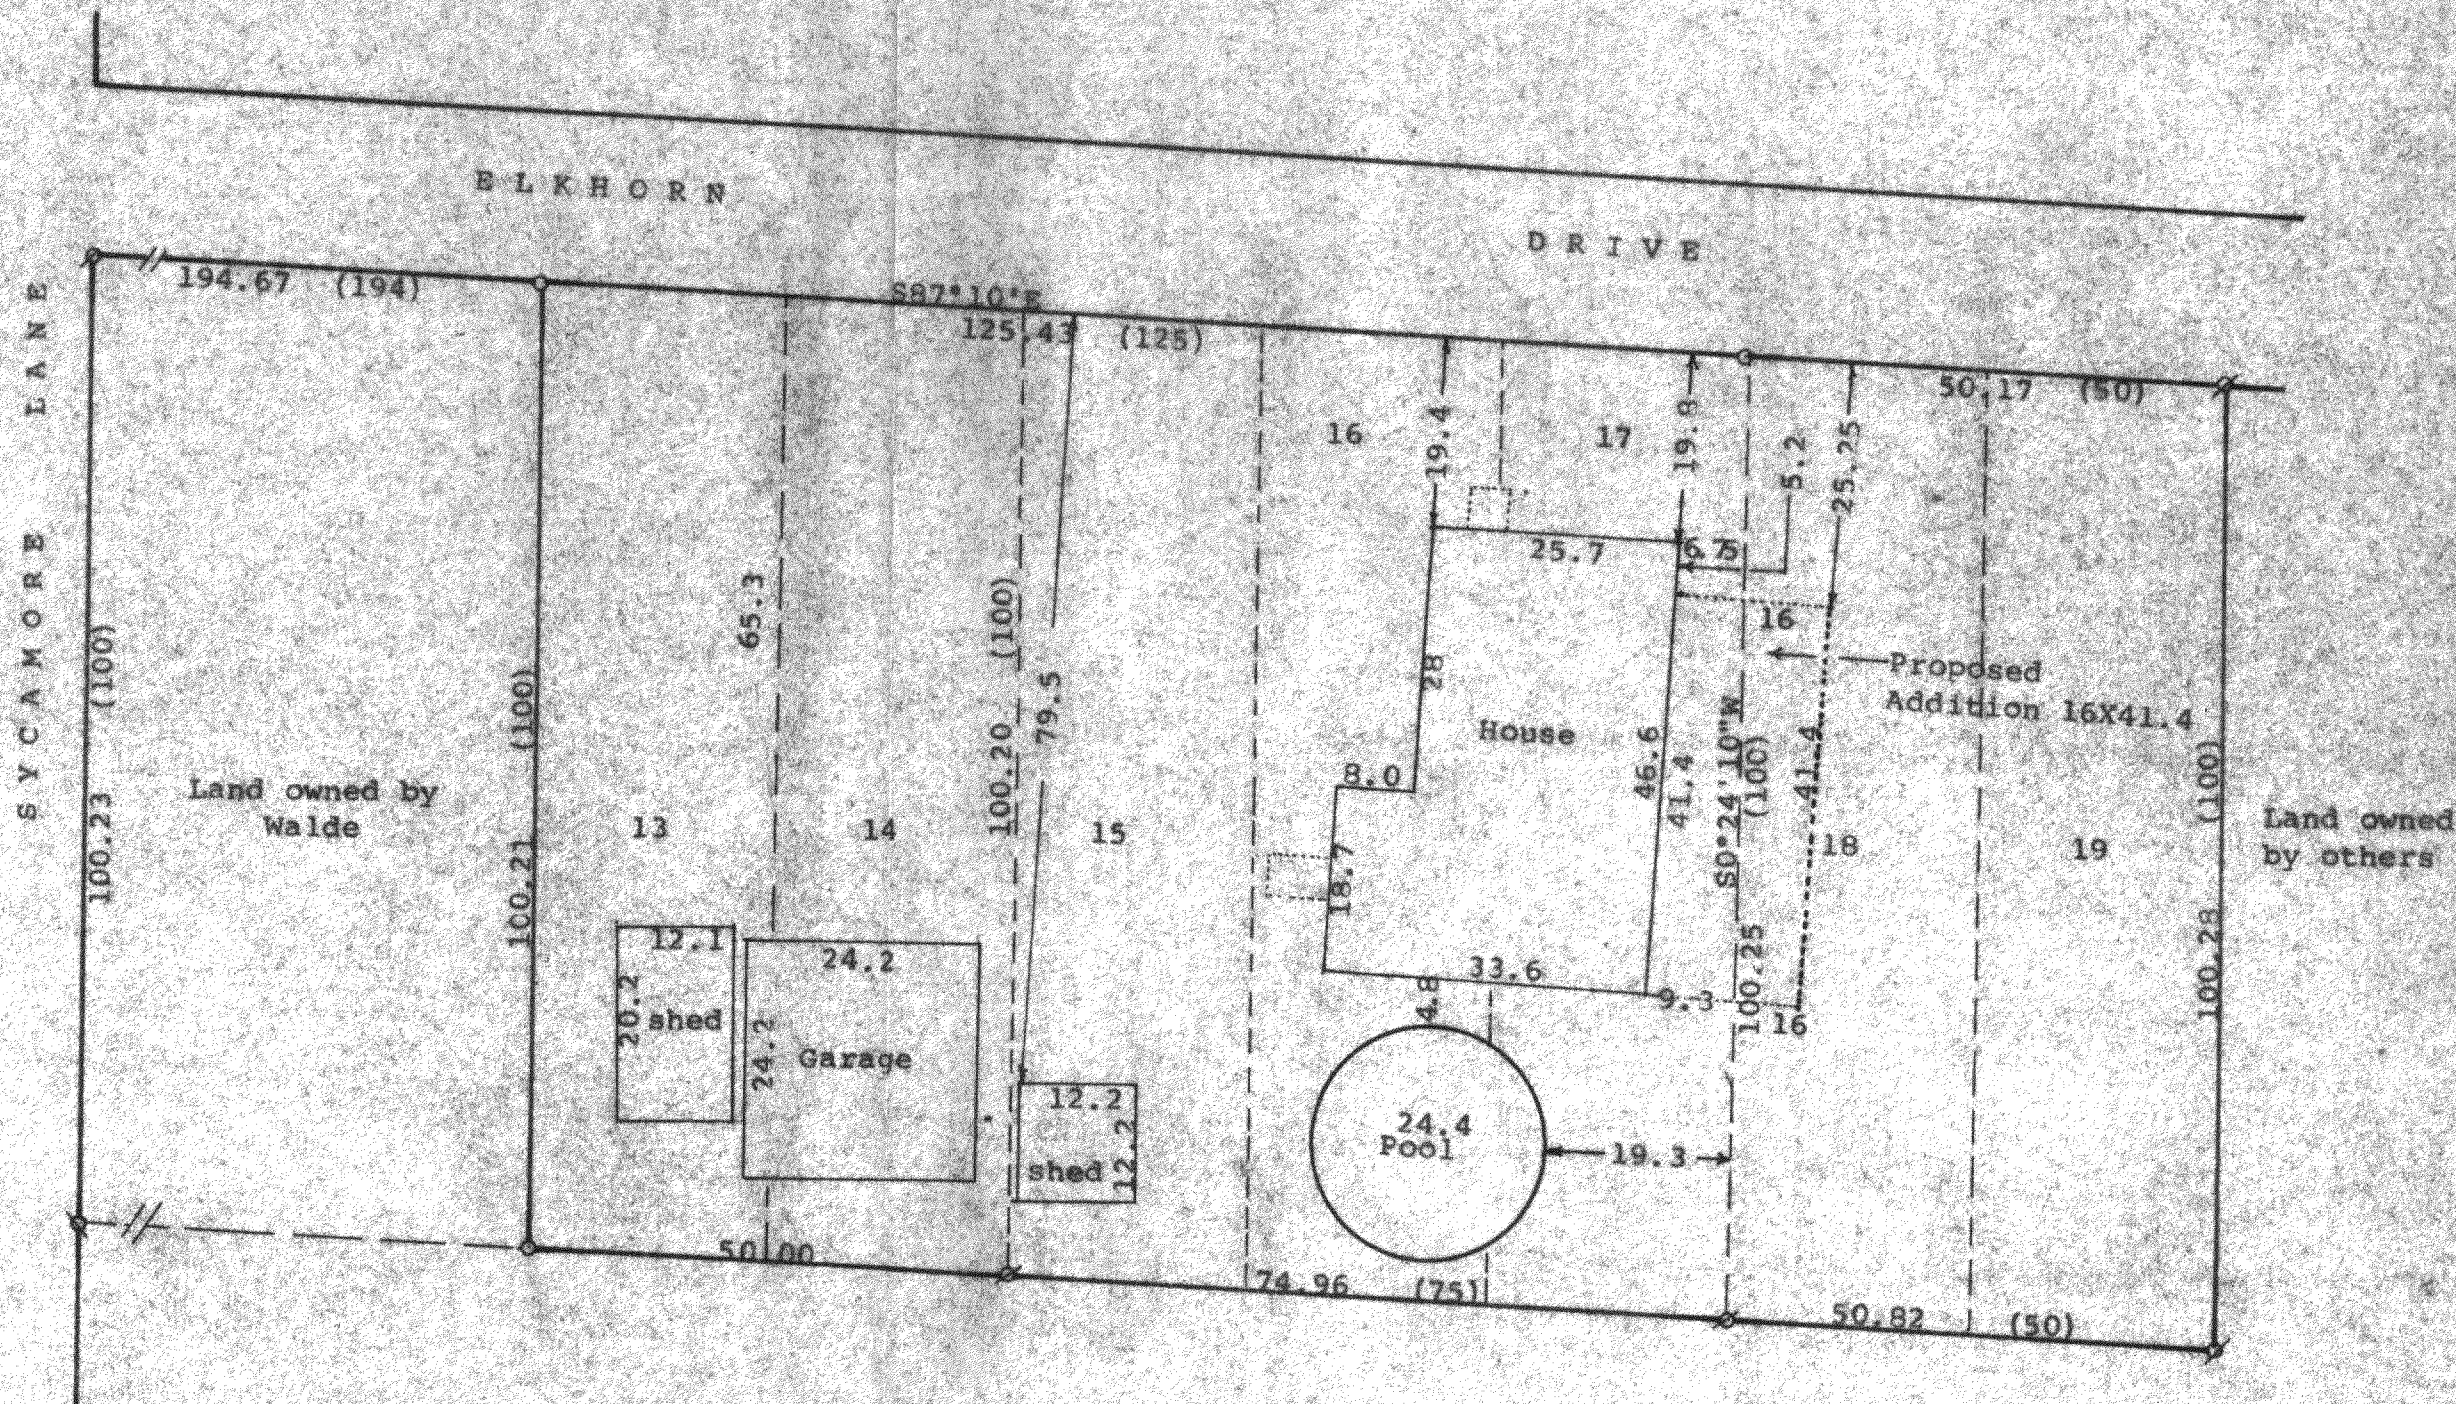

Scale - 1" = 20'
 ♂ = 1" Iron Pipe Found
 ♀ = 1 1/4" Iron Pipe Found
 ○ = 3/4" Iron Pipe Set
 Bearings referenced to the south
 line of Elkhorn Drive with the
 assumed bearing of S87°10'E
 Survey ordered by:
 Carl Walde
 W5423 Elkhorn Drive,
 Elkhorn, WI 53121
 (0.00) = recorded distance



STATE OF WISCONSIN) SS
 COUNTY OF WALWORTH)

I, George T. Dunham, Surveyor, certify that I have surveyed the
 property described as follows:

Lots 13-19 inclusive in Block 87 of Lake Wandawega Subdivision,
 located in Section 2, T 3 N, R 16 E, Walworth County, Wisconsin,
 and that the plat shown hereon is a correct representation thereof and shows
 the size and location of the property, its exterior boundaries, the location
 of all visible structures and dimensions of all principal buildings thereon,
 apparent easements, roadways and visible encroachments, if any, and that I
 have surveyed the property hereon described, according to the official records,
 to the best of my knowledge and belief.
 August 15, 1996

Revised Sept. 3, 1996 to show
 proposed addition to house

George T. Dunham
 George T. Dunham, Surveyor

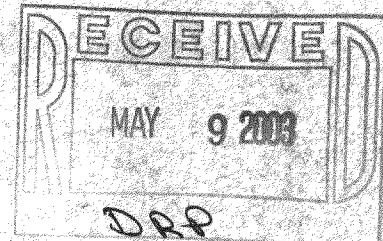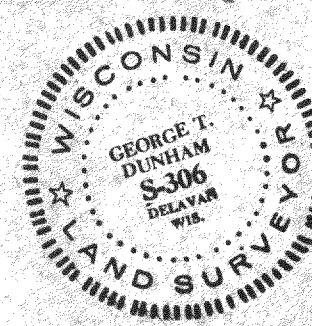

GLW-136
 GLW-137

316-1479