

ABERNATHY and ASSOCIATES

Kenneth E. Abernathy Jr.

Wisconsin Registered Land Surveyor S-1594

W4056 BRAY RD.
ELKHORN, WI. 53121
PHONE: (262) 723-4260 (OFFICE)
(262) 723-7209 (FAX)
Email: abernathy@elknet.net

PLAT OF SURVEY



LOTS 1, 2 AND THE SOUTH 1/2 OF LOT 5 OF BLOCK 62
INTERLAKEN SUBDIVISION, LOCATED IN SECTION 11
TOWN 3 NORTH, RANGE 16 EAST, TOWN OF SUGAR CREEK
WALWORTH COUNTY, WISCONSIN.

Legend

- FOUND IRON PIPE
- FOUND IRON ROD
- ⊠ FOUND BRASS CAPPED MONUMENT
- FOUND CONCRETE MONUMENT
- + CHISEL CUT IN CONCRETE
- SET IRON ROD, 24" LONG, WEIGHING 1.5 LBS./LINEAL FT., 3/4" DIA.
- SET IRON ROD, 30" LONG, WEIGHING 4.5 LBS./LINEAL FT., 1-11/16" DIA.
- (x x) RECORDED AS DIMENSION
- x — x — EXISTING FENCE

Bearings are based on a previous Plat of Survey

SCALE: 1" = 30 FEET

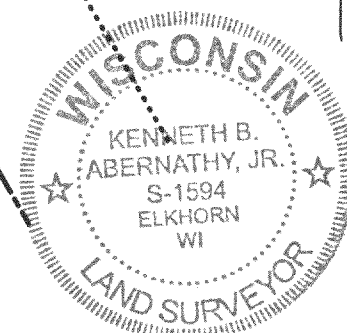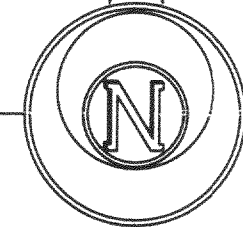

"I hereby certify that the above described property has been surveyed by me or under my direction and that the above map is a true representation thereof and shows the size and location of the property, its exterior boundaries, the location of all visible structures and dimensions of all principal buildings thereon, boundary fences, apparent easements, roadways and visible encroachments, if any."
"This survey is made for the use of the present owners of the property, and also those who purchase, mortgage, or guarantee the title thereto within one year from the date hereof."


Kenneth B. Abernathy, Jr.

KENNETH B. ABERNATHY, JR.
WISCONSIN REGISTERED LAND SURVEYOR,
S-1594
Date: Mar. 19, 2003 Job No. 03.306

Revised 7/01/03 - Foundation located As Built

Ordered by: Schauder Building, Inc.
4115 North U.S. Highway 51
Janesville, Wi. 53545-9674


Owners: Chuck and Barb Myers
681 N. Sandy Lane
Elkhorn, Wi. 53121

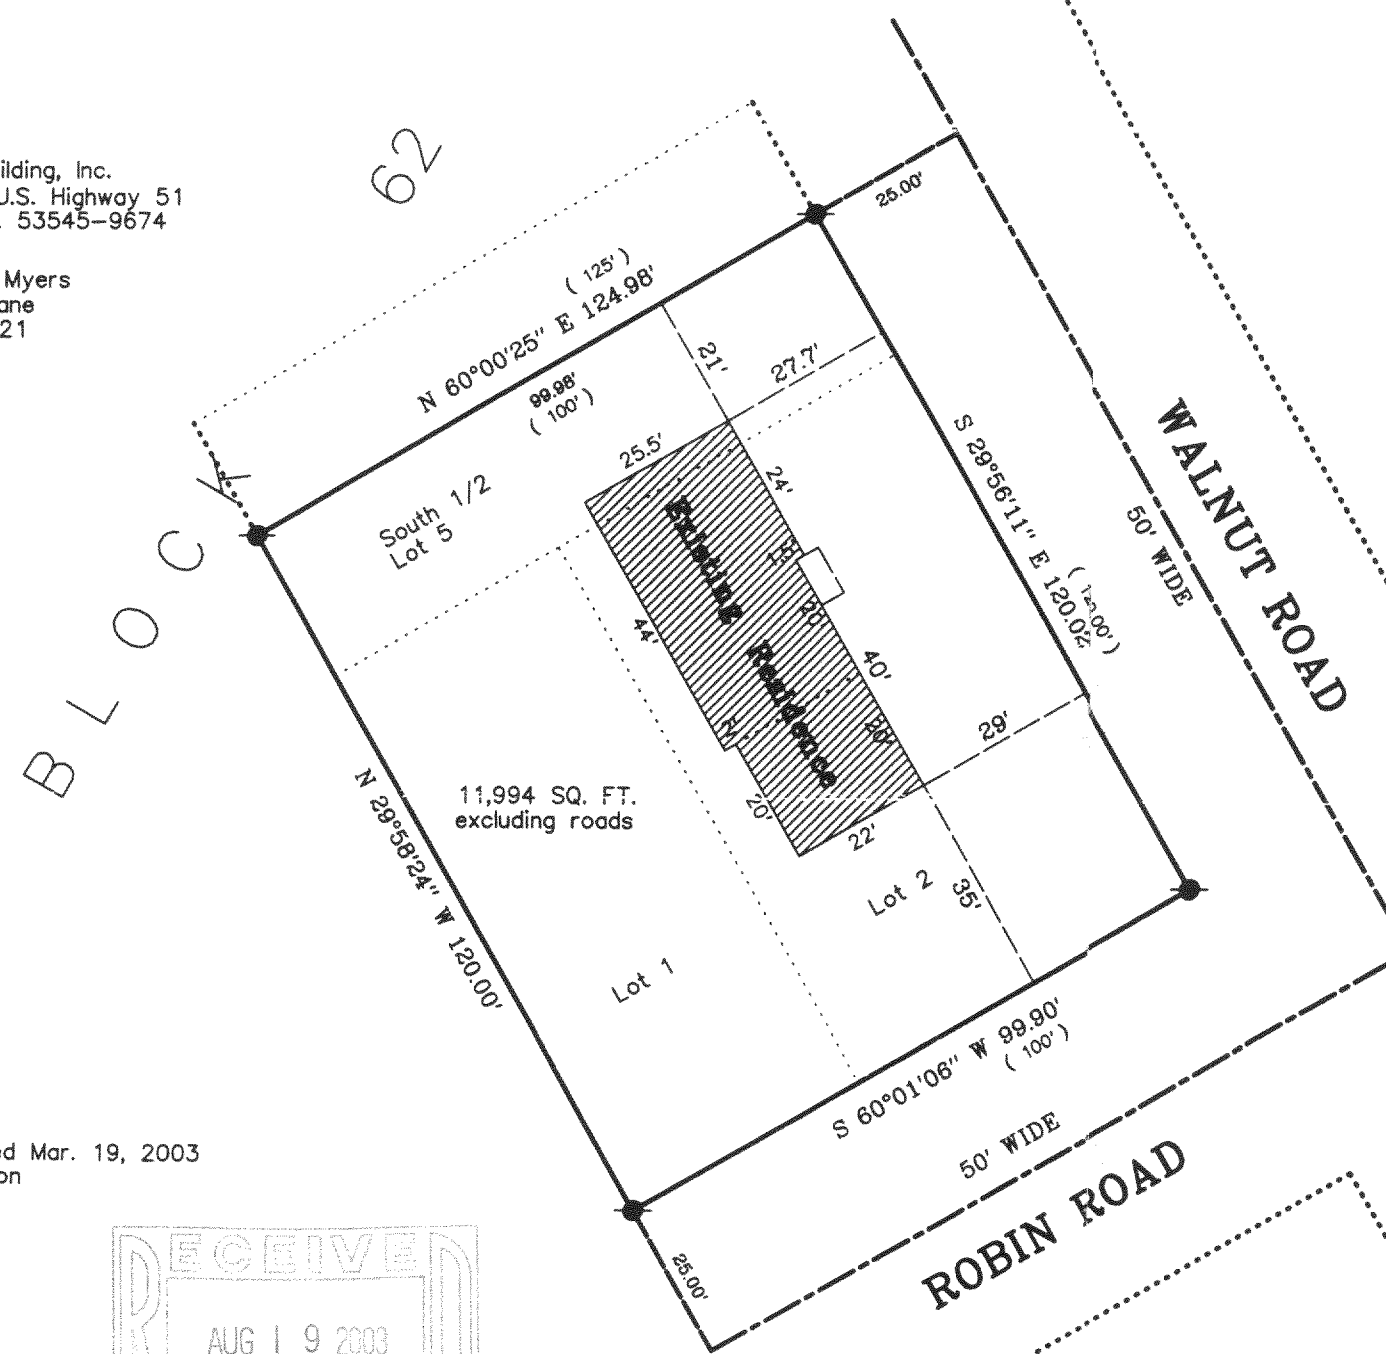

11,994 SQ. FT. excluding roads

NOTES

See previous plat dated Mar. 19, 2003 for stakeout information

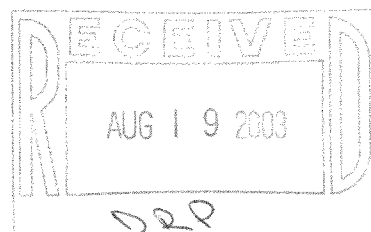

GI-560

316-1534