



Plat of Survey

of
Lots 1 through 9 and Lots 39 through 42 all in Block 2 of Interlaken,
 a subdivision located in the Southwest 1/4 of Section 11,
 Town 3 North, Range 16 East, Town of Sugar Creek,
 Walworth County, Wisconsin.

Surveyed for: **Whispering Oaks Realty, LLC**
 P.O. Box 16
 Elkhorn, Wisconsin. 53121

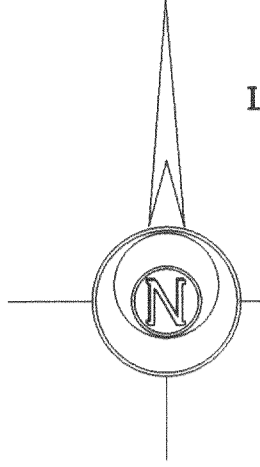


Bearings reference to
 the Map of Interlaken.

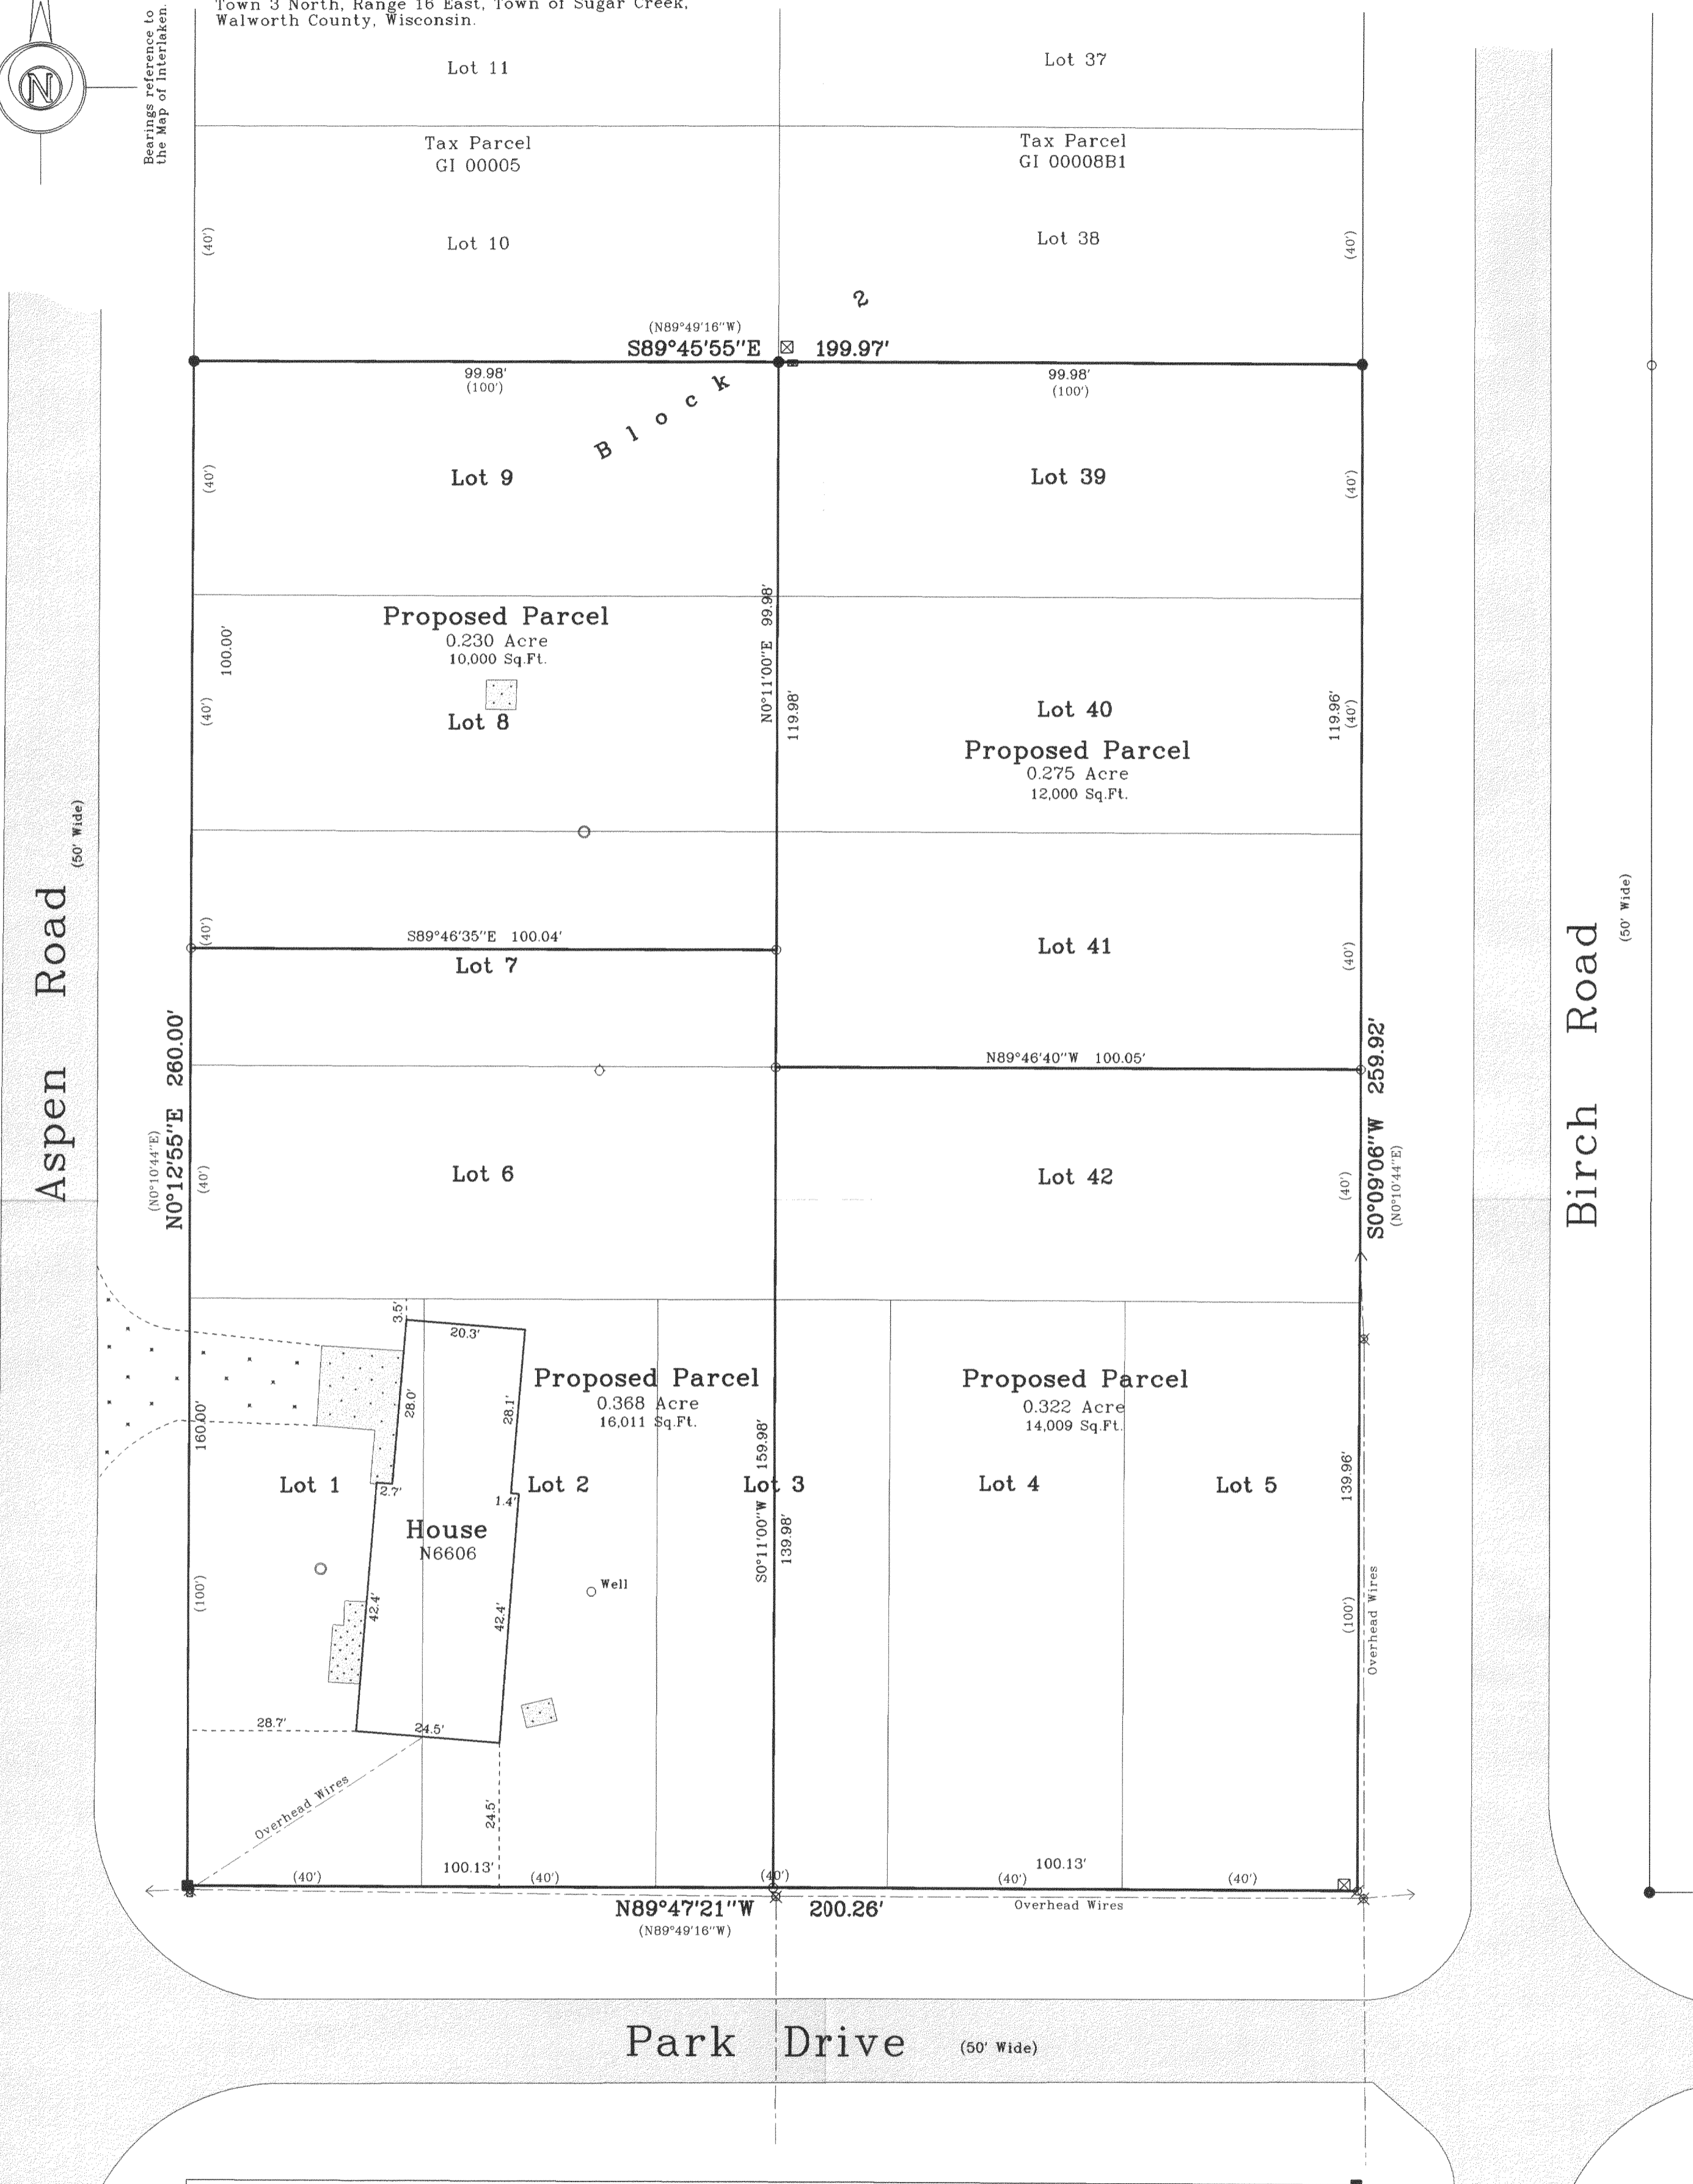

Copyright © 2003 by Jensen & Olson Land Surveying, LLC.
 All rights reserved. No part of this survey plat may be reproduced or transmitted in any form by any means - graphic, electronic, or mechanical, including photocopying, tracing, or information storage and retrieval systems - without permission in writing from Douglas G. Olson, Jensen & Olson Land Surveying, LLC.

I, Douglas G. Olson, Wisconsin Registered Land Surveyor, do hereby certify that this survey was performed by me or under my direction in full compliance with the owner's/agent's instructions and Chapter A-E 7 of the Wisconsin Administrative Code "Minimum Standards for Property Surveys" and that this map is an accurate representation thereof to the best of my knowledge and belief.

Douglas G. Olson
 Wisconsin Registered Land Surveyor - 2093

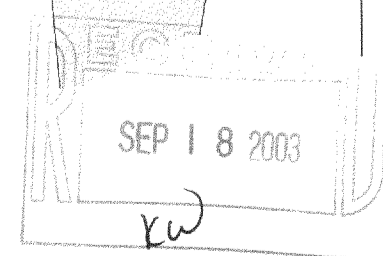

2003.092	Sheet 1 of 1 Sheets	Legend Found Concrete Monument Set spike Set Rod, 3/4" dia. Found Iron Rod, 3/4" dia. Recorded Information Concrete Cover Vent Utility Pole Utility Pedestal Asphalt Surface Concrete Surface Gravel	Jensen & Olson Land Surveying, LLC 45 South Wisconsin Street P.O. Box 322 Elkhorn, Wisconsin. 53121 Telephone (262) 723-3434 Facsimile (262) 723-8044	Scale in Feet 1" = 20' 	Survey Date: June 19, 2003.
	Job Reference Number 2003.092				Revisions: No. 1 - Proposed Parcels No. 2 - Set rods.