



ORDERED BY
JUDY ROCKWELL

PLAT OF SURVEY

J.K. SURVEYING INC.
N3705 WILLOWBEND LANE
LAKE GENEVA, WI, 53147
262-248-3697

- OF -

LOTS 11, 12, 13, 14 AND THE EASTERLY 1/2 OF THE RESERVE LOT
FOR BLOCK 7 ALL IN BLOCK 7, OF INTERLAKEN SUBDIVISION,
TOWN OF SUGAR CREEK, WALWORTH COUNTY, WISCONSIN.

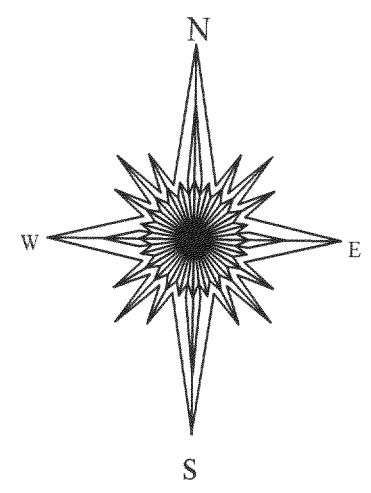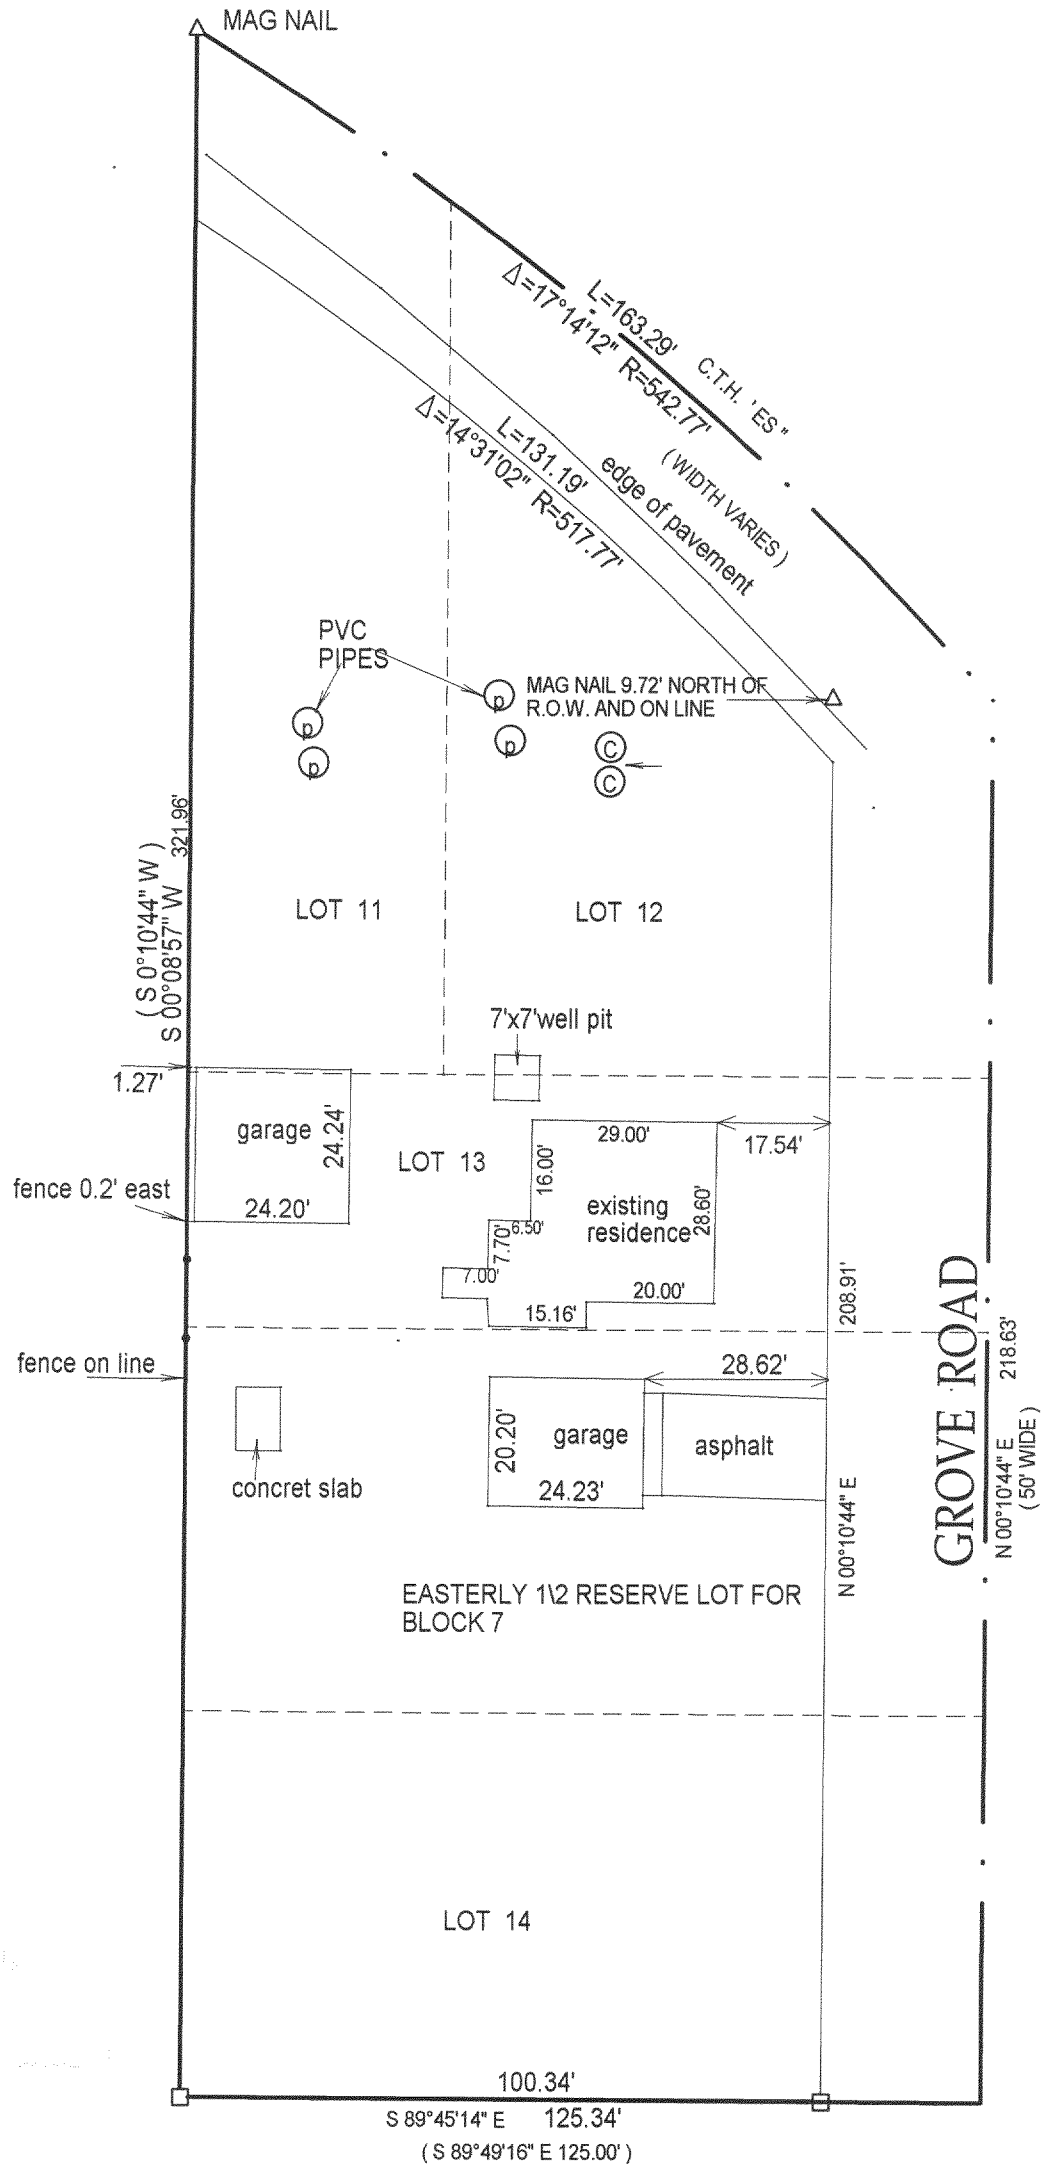

007-3205
DRD

- () = recorded as
- = found iron bar
- = found iron pipe
- = set iron pipe
- = set iron bar

COMPARE LEGAL DESCRIPTION ABOVE AND DRAWING WITH DEED. FOR BUILDING RESTRICTIONS AND EASEMENTS NOT SHOWN, REFER TO DEED, ABSTRACT SOURCES AND LOCAL MUNICIPAL CODES. NOTIFY THE SURVEYOR IMMEDIATELY OF ANY DISCREPANCY.


SCALE 1" = 30'

JOB # 03-414

TAX ID #
GI 00072 A&B
GI 0073

"I hereby certify that I have surveyed the above described property and that the above map is a true representation thereof and shows the size and location of all visible structures, apparent easements and encroachments if any."
This survey is made for the present owners of the property, and those who purchase, mortgage, or guarantee the title thereto, within one year from the date hereof.

DATED THIS 22 TH, DAY OF JULY 20 03

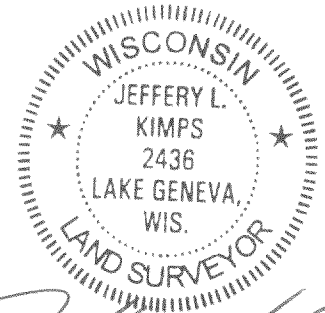

Jeffrey L. Kimps
JEFFREY L. KIMPS S - 2436
Wisconsin Registered Land Surveyor
(original if signed in red)

61-73
61-72A
61-72B

316-1548