


# PLAT OF SURVEY

PREPARED FOR : TOM MARTIN  
KEEFE REAL ESTATE INC.  
980-A N. WISCONSIN ST.  
ELKHORN WI. 53121

J.K. SURVEYING INC.  
N3705 WILLOWBEND LANE  
LAKE GENEVA, WI, 53147  
262-248-3697

- OF -  
LOTS 4,5 AND 6 IN BLOCK 7, LAKE WANDAWEGA HIGHLANS, A SUBDIVISION LOCATED  
IN TOWN 3 NORTH , RANGE 16 EAST, TOWN OF SUGAR CREEK, WALWORTH COUNTY,  
WISCONSIN.

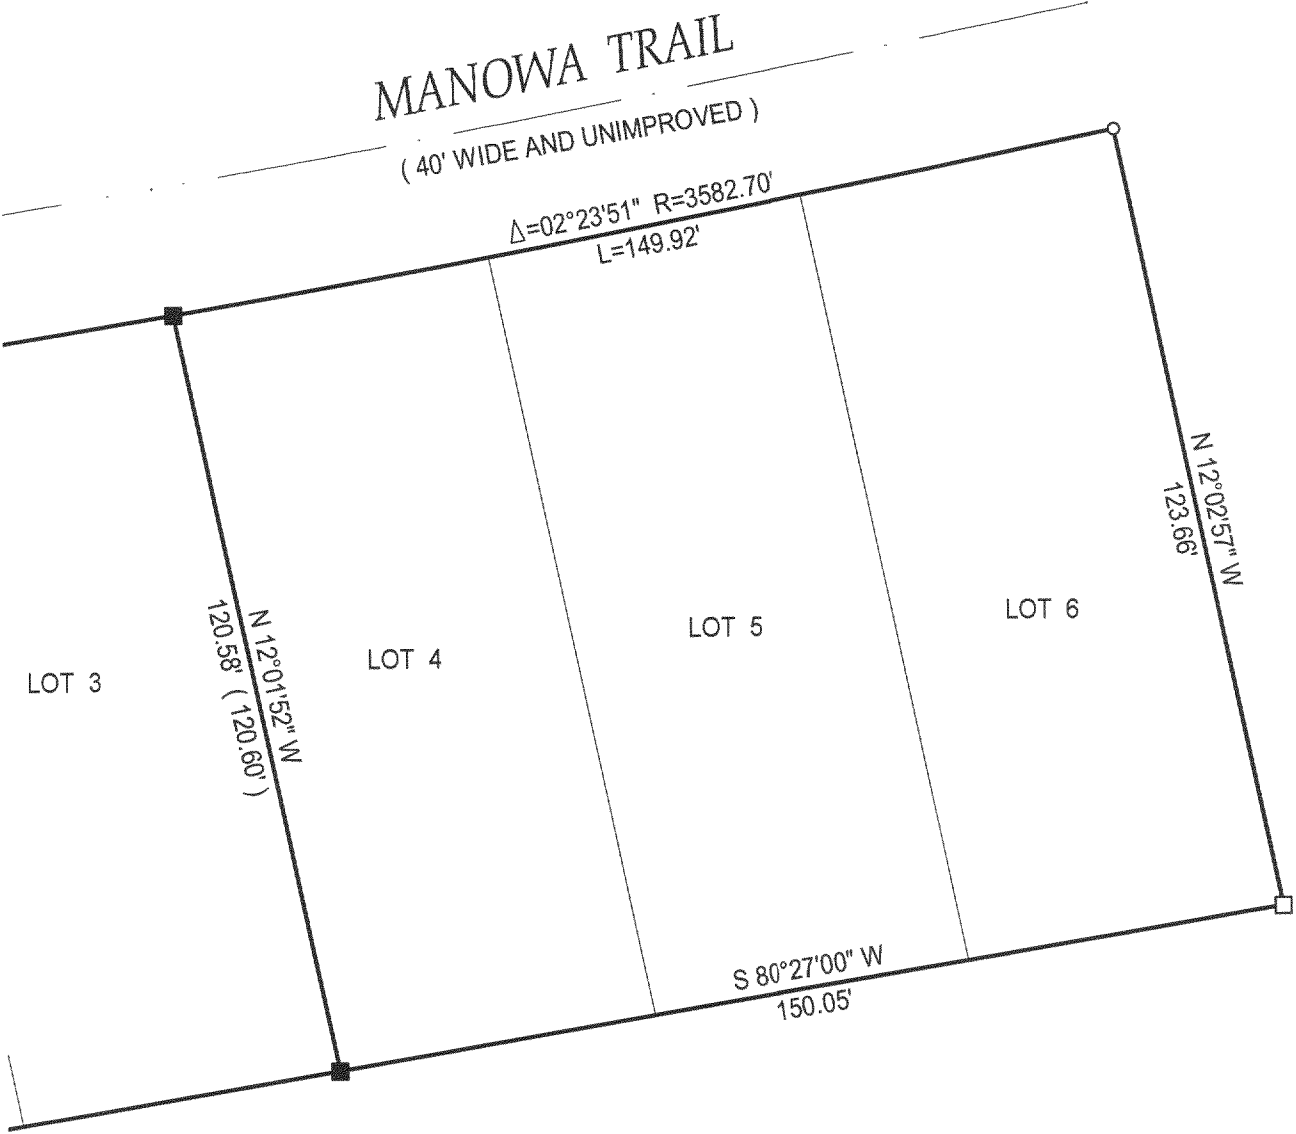


SOUTH LINE OF BLOCK 7 ASSUMED N 80°27' E

COMPARE LEGAL DESCRIPTION ABOVE AND DRAWING WITH DEED. FOR BUILDING RESTRICTIONS AND  
EASEMENTS NOT SHOWN, REFER TO DEED, ABSTRACT SOURCES AND LOCAL MUNICIPAL CODES. NOTIFY  
THE SURVEYOR IMMEDIATELY OF ANY DISCREPANCY.

"I hereby certify that I have surveyed the above described property and that  
the above map is a true representation thereof and shows the size and  
location of all visible structures, apparent easements and encroachments  
if any."

This survey is made for the present owners of the property, and those who  
purchase, mortgage, or guarantee the title thereto, within one year from  
the date hereof. DATED THIS 13 TH, DAY OF AUGUST 20 03 .

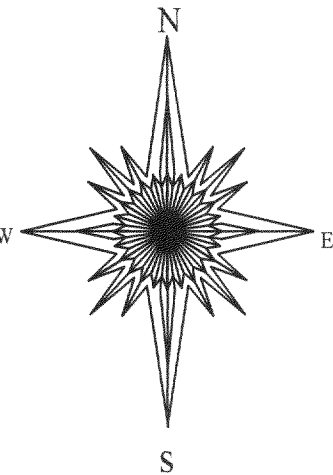

- ( ) = recorded as
- = found iron bar
- = found iron pipe
- = set iron pipe
- = set iron bar


SCALE 1" = 30'

JOB # 03-459

TAX ID # GWH-00080-  
GWH-81

OCT - 3 2003

DRD

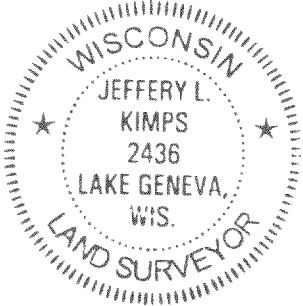

*Jeffrey L. Kimps*  
JEFFREY L KIMPS S - 2436  
Wisconsin Registered Land Surveyor  
( original if signed in red )

316-1558