FARRIS, HANSEN & ASSOCIATES, INC.

ENGINEERING - ARCHITECTURE - SURVEYING 7 RIDGWAY COURT - P.O. BOX 437, ELKHORN, WISCONSIN, 53121

PHONE: (262) 723-2098

FAX: (262) 723-5886

PLAT OF SURVEY

LOTS 7, 8, 23, & 24 OF BLOCK 74 OF THE FIFTH MAP OF INTERLAKEN

LOCATED IN THE NW 1/4 OF SECTION 14, TOWN 3 NORTH, RANGE 16 EAST, TOWN OF SUGAR CREEK, WALWORTH COUNTY, WISCONSIN

- WORK ORDERED BY -RICHARD HOWARTH 850 N. WISCONSIN STREET ELKHORN, WI. 53121


LEGEND

- O = FOUND IRON PIPE STAKE
- = SET IRON REBAR STAKE, 3/4" DIA. \times 24" \times 1.50 lbs./ft.

(XXX) = RECORDED AS

EVERGREEN ROAD 50' WIDE R.O.W.

(66' WIDE AFTER FUTURE R.O.W. DEDICATION)

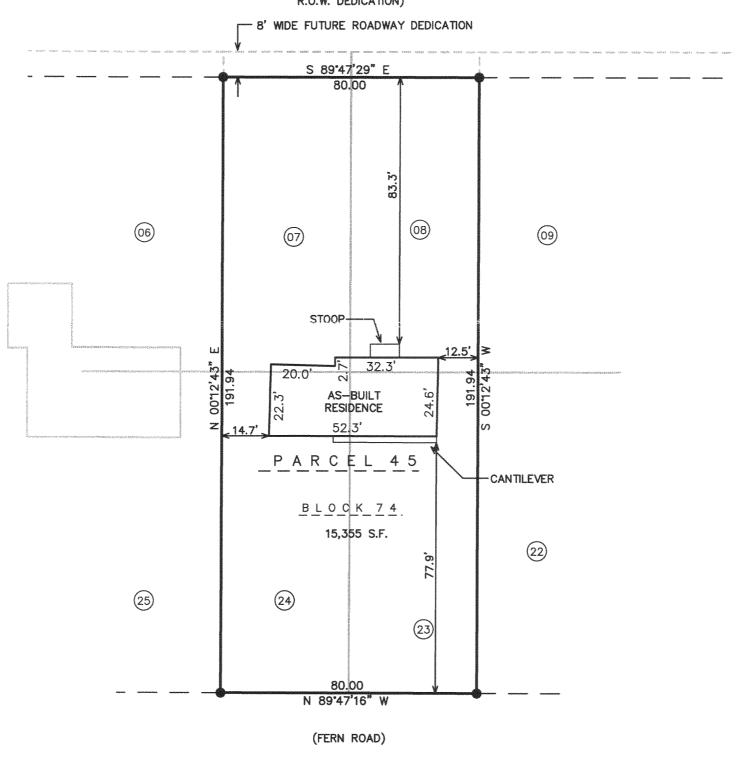

100 100 50 90 80 70 60 MAP SCALE IN FEET ORIGINAL 1" = 30'

NOTE: COPIES OF THIS MAP TO WHICH THE FOLLOWING CERTIFICATE WILL APPLY SHOW THE SURVEYOR'S ORIGINAL SEAL AND SIGNATURE IN RED INK. COPIES BY ANY OTHER MEANS MAY HAVE ALTERATIONS WHICH DO NOT REPRESENT THE SURVEYOR'S WORK PRODUCT.

I HEREBY CERTIFY THAT THE ABOVE DESCRIBED PROPERTY HAS BEEN SURVEYED UNDER MY DIRECTION AND THAT THE ABOVE MAP IS A TRUE REPRESENTATION THEREOF AND SHOWS THE SIZE AND LOCATION OF THE PROPERTY AND ITS EXTERIOR BOUNDARIES. THIS SURVEY IS MADE FOR THE USE OF THE PRESENT OWNERS OF THE PROPERTY, AND ALSO THOSE WHO PURCHASE, MORTGAGE, OR GUARANTEE THE TITLE THERETO WITHIN ONE YEAR FROM THE DATE

REVISED 10/29/2003 TO SHOW SIZE & LOCATION OF AS-BUILT RESIDENCE

APRIL 29, 2003 DATED

PROJECT: 5015.45

PETER S. GORDON R.L.S. 2101

ASSIGNED

DATE: 08/12/02 SHEET: 1 OF 1

NOV 2 0 200