




# Plat of Survey

of  
**Lots 39, 40 and 41 in  
 Block 2 of Interlaken,**  
 a subdivision located in the Southwest 1/4 of Section 11,  
 Town 3 North, Range 16 East, Town of Sugar Creek,  
 Walworth County, Wisconsin.

Surveyed for: **Whispering Oaks Realty, LLC**  
 P.O. Box 16  
 Elkhorn, Wisconsin. 53121

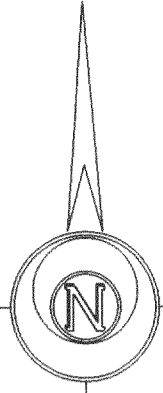

Bearings reference to  
 the Map of Interlaken.

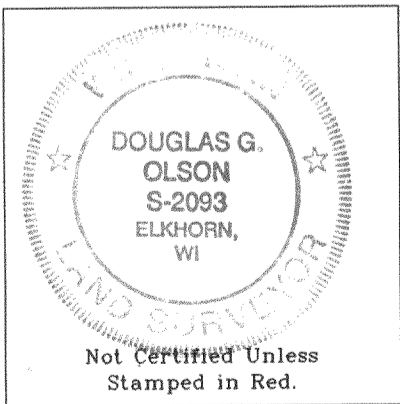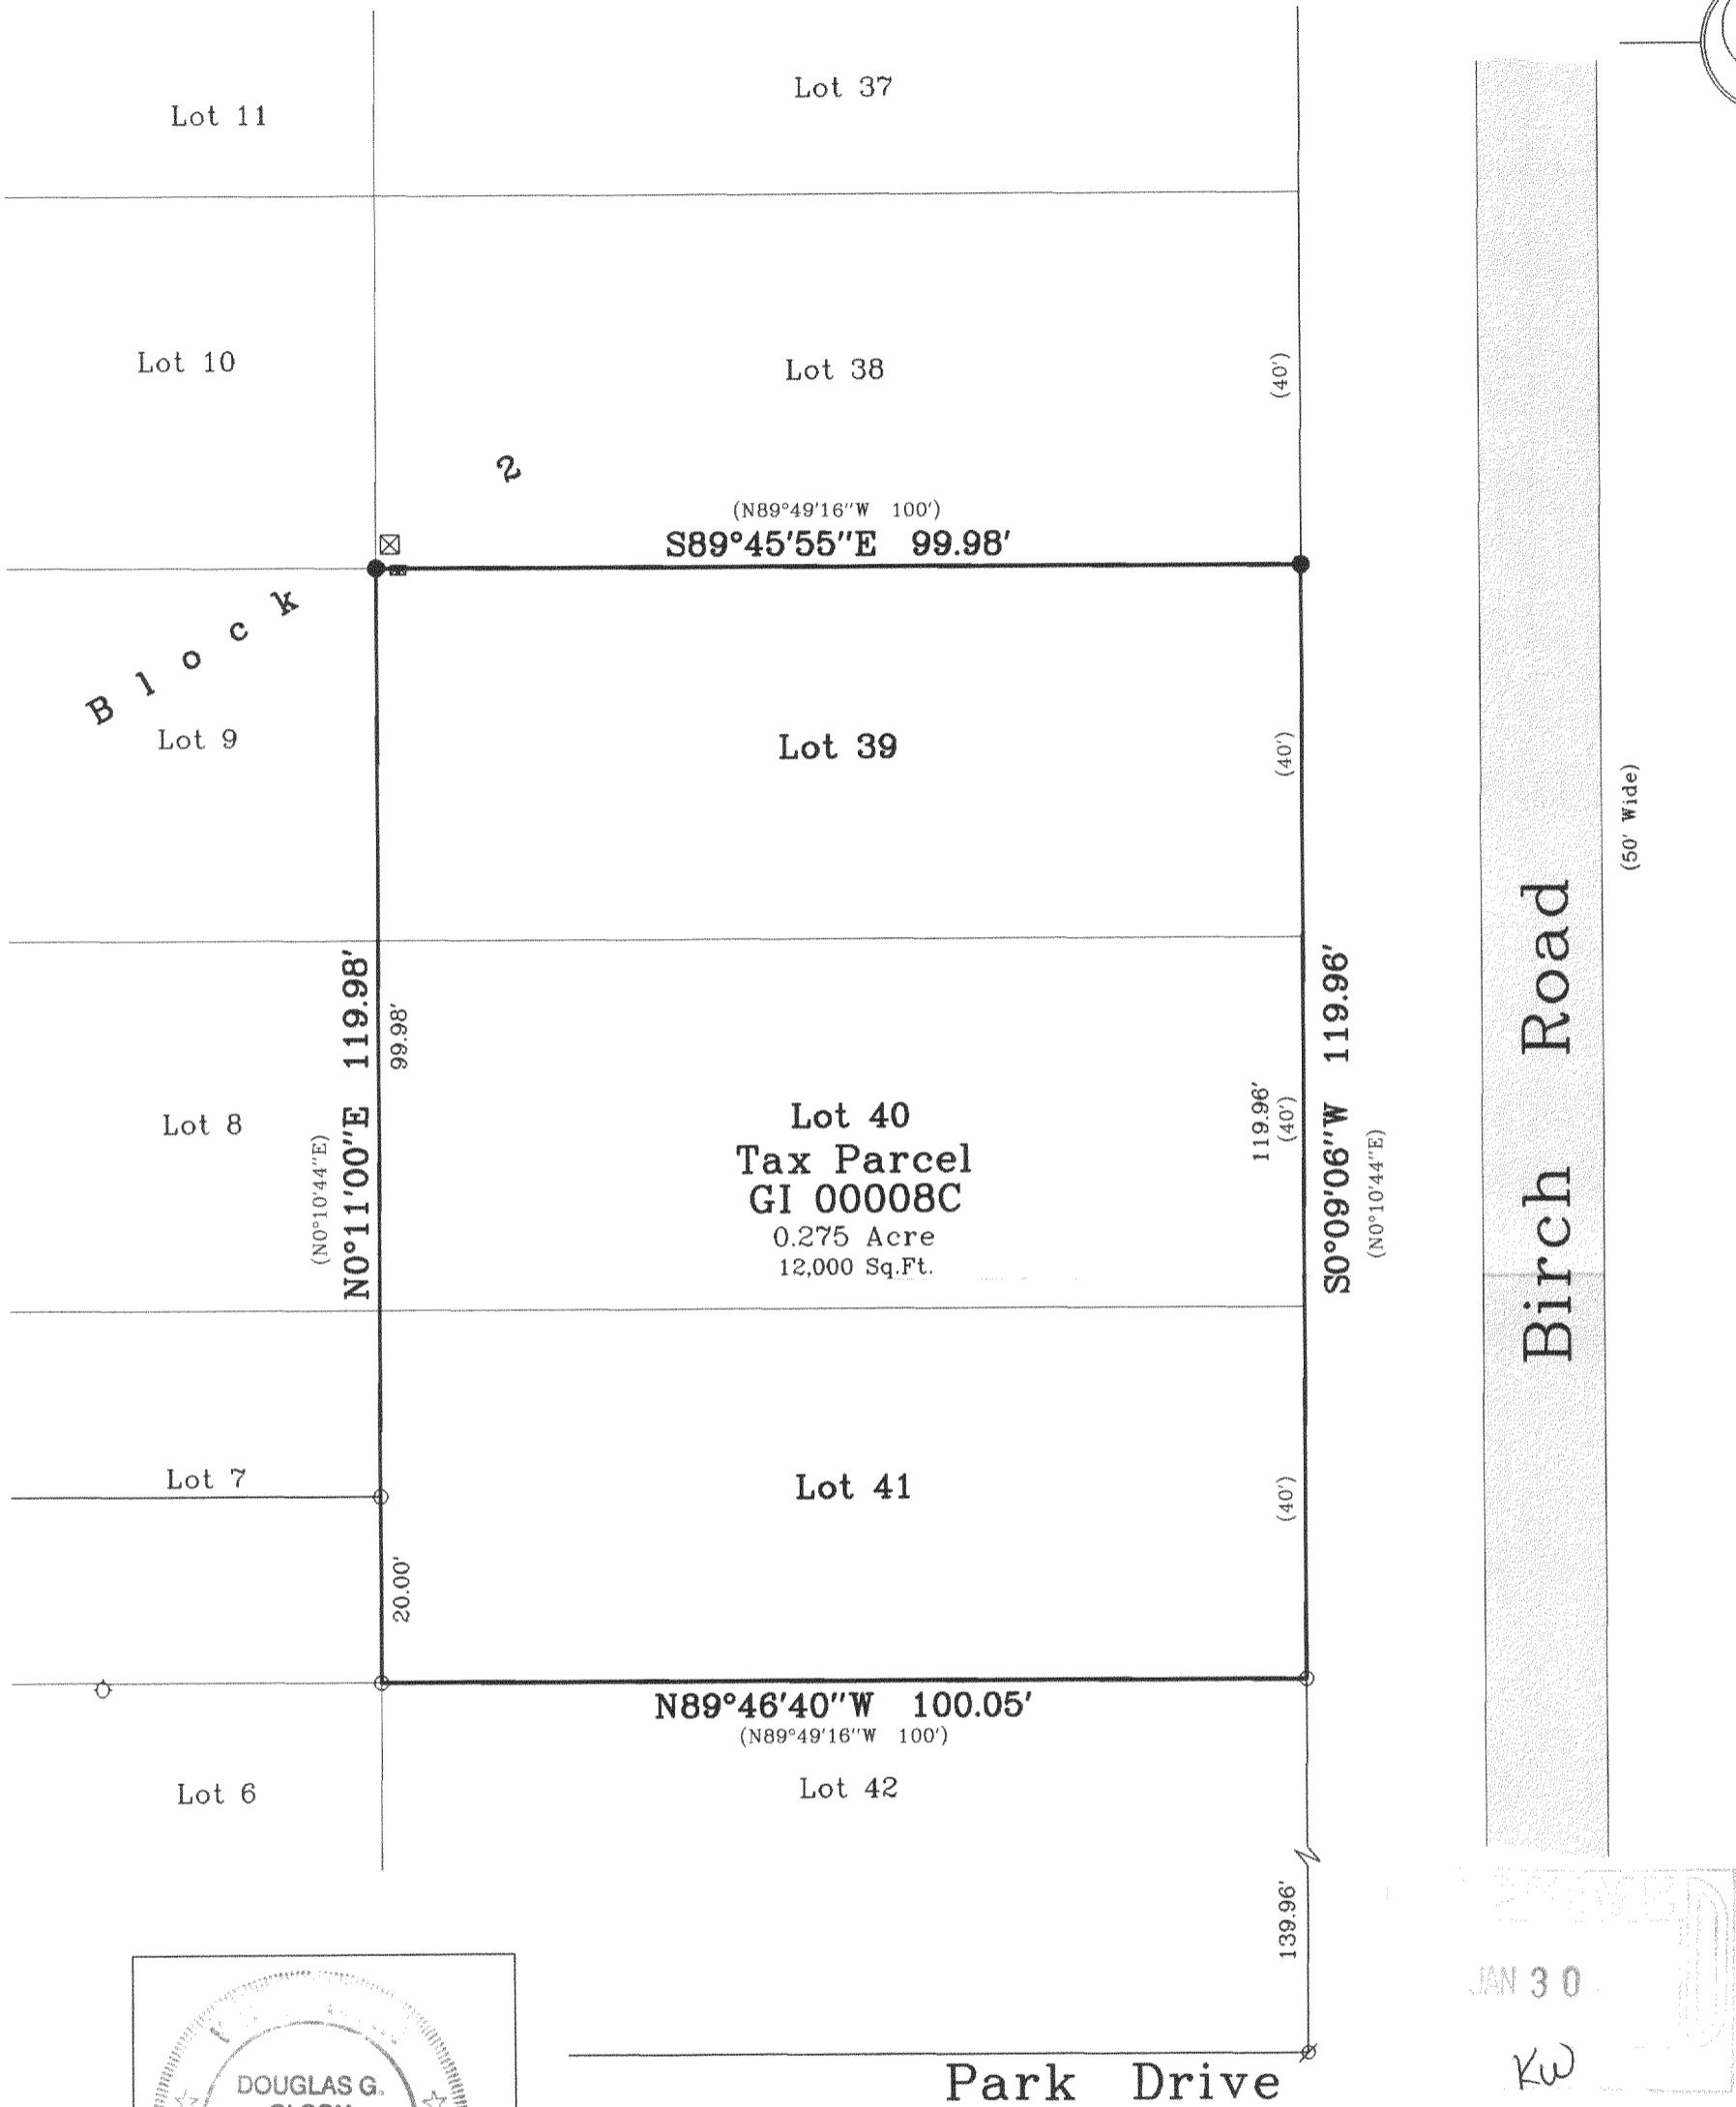

- Notes:
- 1) This survey plat is not certified unless signed and sealed in red ink.
  - 2) This survey is subject to Wisconsin lien laws. This Plat of Survey is the notice of intent to file lien. Lien waiver required.

Copyright © 2003 by Jensen & Olson Land Surveying, LLC.

All rights reserved. No part of this survey plat may be reproduced or transmitted in any form by any means - graphic, electronic, or mechanical, including photocopying, tracing, or information storage and retrieval systems - without permission in writing from Douglas G. Olson, Jensen & Olson Land Surveying, LLC.

I, Douglas G. Olson, Wisconsin Registered Land Surveyor, do hereby certify that this survey was performed by me or under my direction in full compliance with the owner's/agent's instructions and Chapter A-E 7 of the Wisconsin Administrative Code "Minimum Standards for Property Surveys"; and that this map is an accurate representation thereof to the best of my knowledge and belief.

Douglas G. Olson  
 Wisconsin Registered Land Surveyor - 2093

## Legend

- Found Concrete Monument
- ⊗ Set spike ○ Set Rod, 3/4" dia.
- Found Iron Rod, 3/4" dia.
- ( ) Recorded Information
- Concrete Cover ○ Vent
- ⊗ Utility Pole ⊗ Utility Pedestal
- ▨ Asphalt Surface
- ▨ Concrete Surface
- ▨ Gravel

## Jensen & Olson Land Surveying, LLC

45 South Wisconsin Street P.O. Box 322  
 Elkhorn, Wisconsin. 53121  
 Telephone: (262) 723-3434  
 Facsimile: (262) 723-8044

Scale: 1" = 20'



Survey date: June 19, 2003.  
 Revisions:

Sheet 1 of 1 Sheets.

Job Reference Number:

GI-8C

316-1581

2003.092