ABERNATHY and ASSOCIATES

Kenneth B. Abernathy Jr.

Wisconsin Registered Land Surveyor S-1594

W4056 BRAY RD. ELKHORN, WI. 53121 PHONE: (262) 723-4260 (OFFICE) (262) 723-7209 (FAX) Email: abernathy@elknet.net

PLAT OF SURVEY

LOTS 6 THRU 8 OF BLOCK 35 OF THE THIRD MAP OF INTERLAKEN SUBDIVISION, LOCATED IN SECTION 11, TOWN 3 NORTH, RANGE 16 EAST, TOWN OF SUGAR CREEK, WALWORTH COUNTY, WISCONSIN.


OWNER: ROSS HANSON

N7694 RENDELL DR. ELKHORN, WI. 53121

SURVEYOR'S COMMENTS

SEVERAL CONCRETE MONUMENTS WERE FOUND IN THE COURSE OF THIS SURVEY. THIS FIRM HAS ELECTED TO RECOGNIZE ALL OF THEM. HOWEVER, I HAVE USED THOSE AT POINTS MARKED "A" AND "B" TO DETERMINE THE EXTERIOR OF LOTS 6-8 OF BLOCK 35.

PARCEL CONTAINS 12,005 S.F. (0.27 AC.)

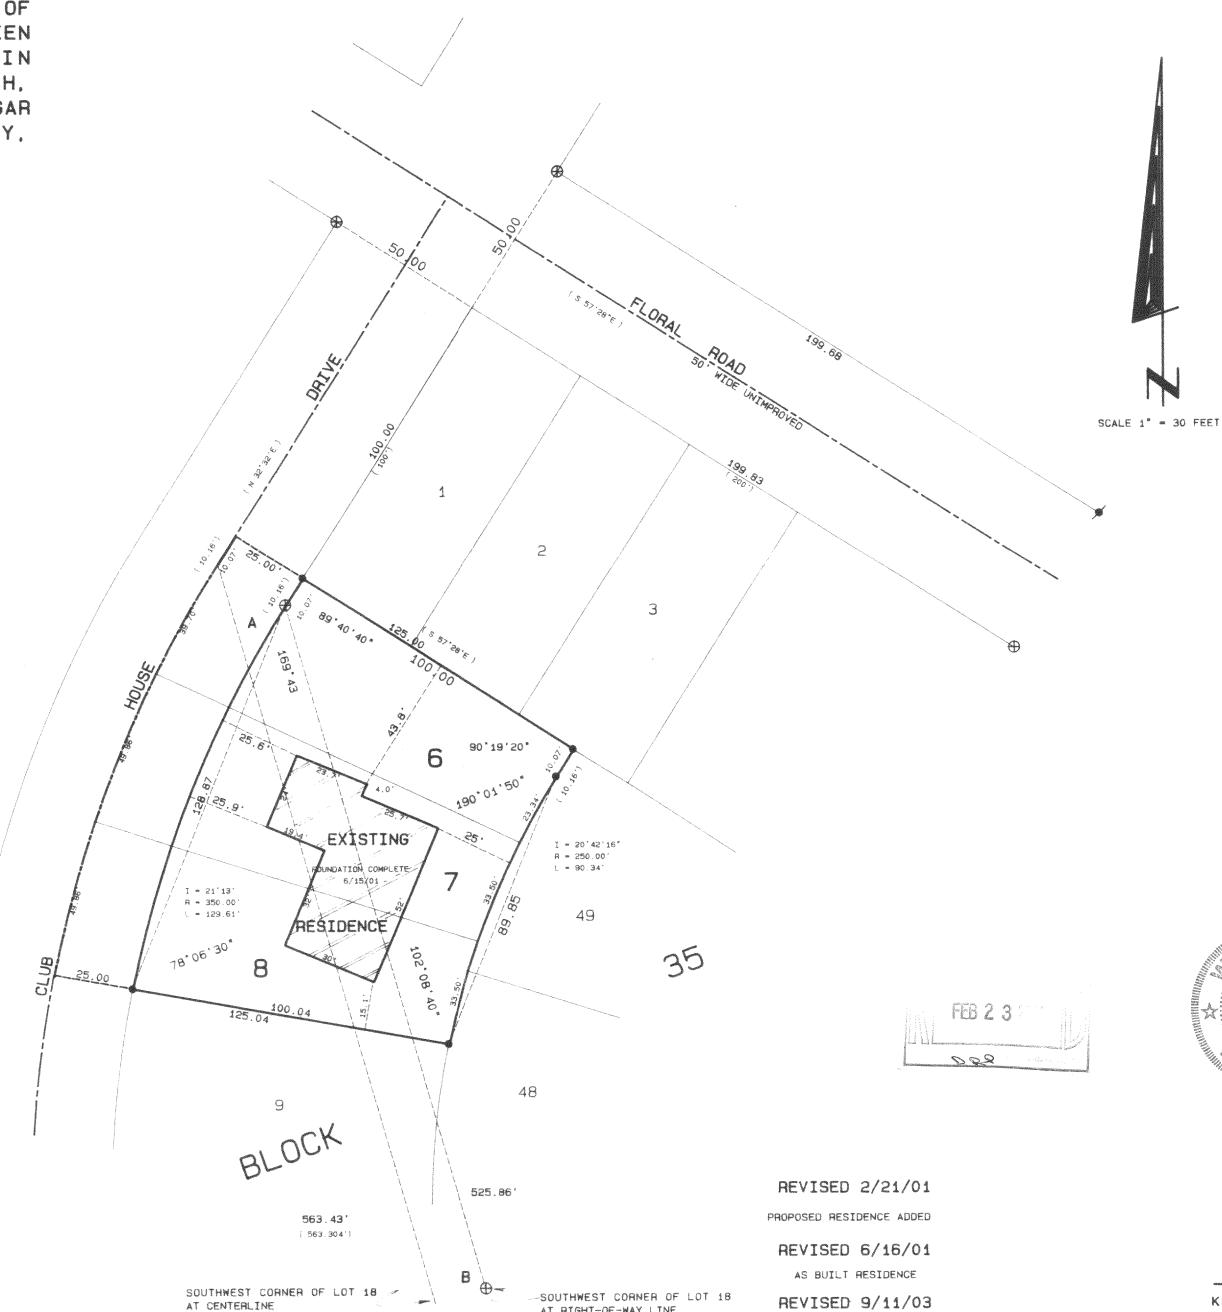

AT RIGHT-OF-WAY LINE

REVISED EXTERIOR OF PARCEL

Legend

P FOUND IRON PIPE

FOUND IRON ROD

TOUND BRASS CAPPED MONUMENT

* FOUND CONCRETE MONUMENT

+ CHISEL CUT IN CONCRETE

SET IRON ROD, 24" LONG, WEIGHING 1.5 LBS./LINEAL FT., 3/4" DIA.

SET IRON ROD, 30" LONG, WEIGHING 4.5 LBS./LINEAL FT., 1-11/16" DIA.

(xx) RECORDED AS DIMENSION



SCALE: 1"= 30 FEET

I hereby certify that the above described property has been surveyed by me or under my direction and that the above map is a frue representation thereof and shows the size and focation of the property its exterior boundaries, the location of all visible structures and dimensions of all principal buildings thereon, boundary ferices, apparent easements, roadways and visible encroachments, if any This survey is made for the use of the present owners of the property,

and also those who purchase mortgage, or guarantee the

KENNETH B. ABERNATHY, JR WISCONSIN REGISTERED LAND SURVEYOR,

Date: DEC. 5, 2000