

ABERNATHY and ASSOCIATES

Kenneth B. Abernathy Jr.

Wisconsin Registered Land Surveyor

S-1594

W4056 BRAY RD.


ELKHORN, WI. 53121

PHONE: (262) 723-4260 (OFFICE)
(262) 723-7209 (FAX)

Email: abernathy@elknet.net

LOTS 45 - 48 INCLUSIVE OF BLOCK 94 and
LOTS 3 - 5 INCLUSIVE OF BLOCK 100 OF LAKE
WANDAWEGA SUBDIVISION, LOCATED IN TOWN
3 NORTH, RANGE 16 EAST, WALWORTH
COUNTY, WISCONSIN



PLAT OF SURVEY

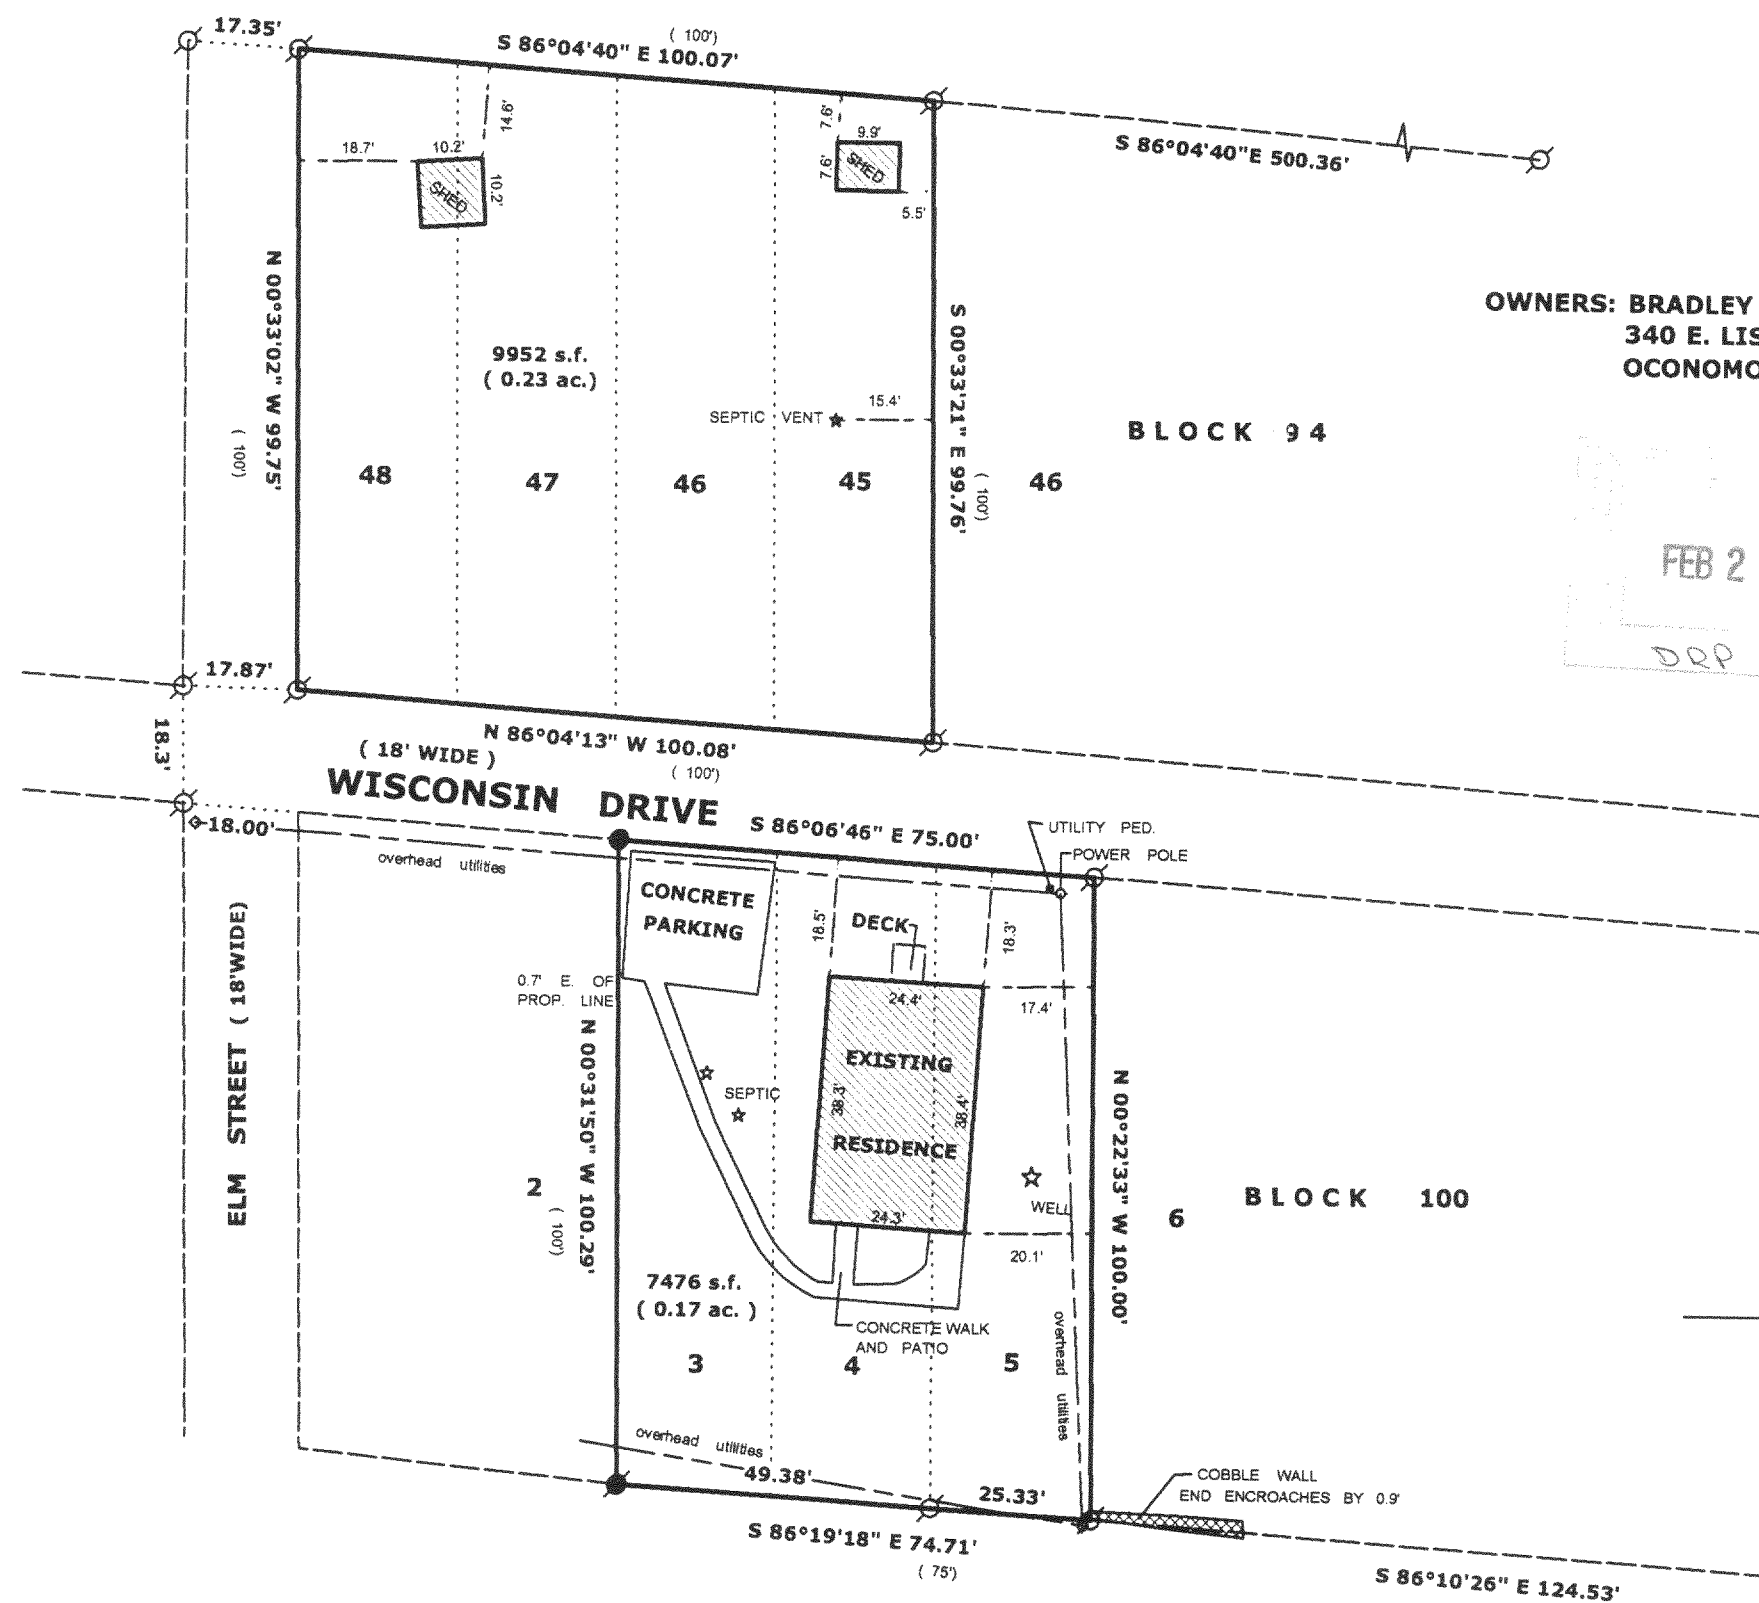

OWNERS: BRADLEY AND JEAN GAMROTH
340 E. LISBON RD.
OCONOMOWOC, WI. 53066

Legend

- FOUND IRON PIPE
- FOUND IRON ROD
- ⊠ FOUND BRASS CAPPED MONUMENT
- FOUND CONCRETE MONUMENT
- + CHISEL CUT IN CONCRETE
- SET IRON ROD, 24" LONG, WEIGHING 1.5 LBS./LINEAL FT., 3/4" DIA.
- SET IRON ROD, 30" LONG, WEIGHING 4.5 LBS./LINEAL FT., 1-11/16" DIA.
- (x x) RECORDED AS DIMENSION
- x — x — EXISTING FENCE

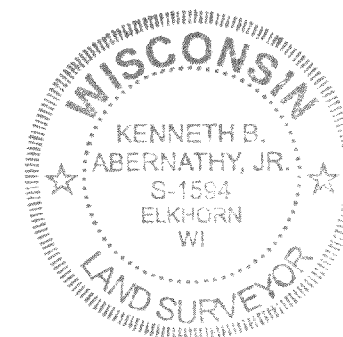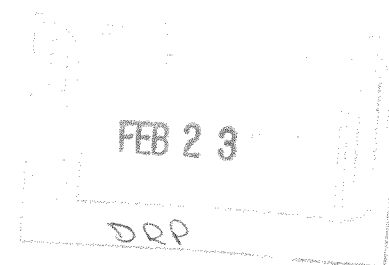

SCALE: 1" = 30 FEET

"I hereby certify that the above described property has been surveyed by me or under my direction and that the above map is a true representation thereof and shows the size and location of the property, its exterior boundaries, the location of all visible structures and dimensions of all principal buildings thereon, boundary fences, apparent easements, roadways and visible encroachments, if any."

"This survey is made for the use of the present owners of the property, and also those who purchase, mortgage, or guarantee the title thereto within one year from the date hereof."

Kenneth B. Abernathy, Jr.

KENNETH B. ABERNATHY, JR.
WISCONSIN REGISTERED LAND SURVEYOR,
S-1594

Date: SEPT. 17, 2003 Job No. 03.910

BEARINGS ARE BASED ON
PREVIOUS SURVEYS OF
RECORD

GLW-177
GLW-203

316-1605