

DESCRIPTION:  
 THE NE 1/2 OF LOT 3 AND ALL OF LOTS 4, 5, & 6 ALL IN BLOCK 52 OF THE 4<sup>TH</sup> MAP OF INTERLAKEN A SUBDIVISION LOCATED IN SECTION 11, T3N, R16E, WALWORTH COUNTY, WIS. DESCRIBED MORE PARTICULARLY AS FOLLOWS: COMMENCING AT A CONCRETE MONUMENT AT THE NE CORNER OF SAID BLOCK 52, THENCE S 18°55' W ALONG THE W'LY LINE OF NYMPH ROAD 156.42 FEET, THENCE N 71°05' W 100.00 FEET, THENCE N 18°55' E 137.53 FEET TO AN IRON PIPE IN THE S'LY LINE OF ELFIN PLACE, THENCE S 81°47' E ALONG SAID ROAD LINE 101.76 FEET TO THE PLACE OF BEGINNING.


CERTIFICATE:  
 I, JOSEPH M. BIAGI, SURVEYOR, DO HEREBY CERTIFY THAT I HAVE SURVEYED THE LANDS HEREON DESCRIBED

SIGNED:  
 OCTOBER 28, 1974


LEGEND  
 ○ IRON PIPE SET 1"X24"  
 □ CONCRETE MONUMENT

REVISED:  
 DEC 9, 1974  
 JOSEPH M. BIAGI RLS #12

*Joseph M. Biagi*  
 JOSEPH M. BIAGI RLS #12

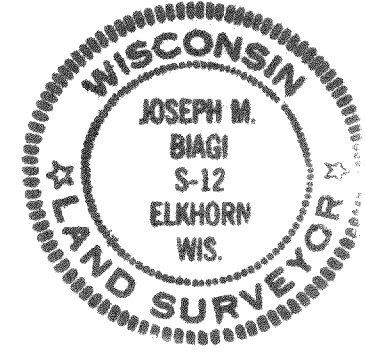

REVISIONS			MR. WAYNE WULF		
NO.	DATE	BY			
1	12/9/74	GW	NE 1/2 LOT 3 AND ALL OF LOTS 4, 5, & 6 BLOCK 52 4 <sup>TH</sup> MAP OF INTERLAKEN		
2					
3			DRAWN BY	SCALE	MATERIAL
4			CHK'D	DATE	DRAWING NO.
5			TRACED	APP'D	

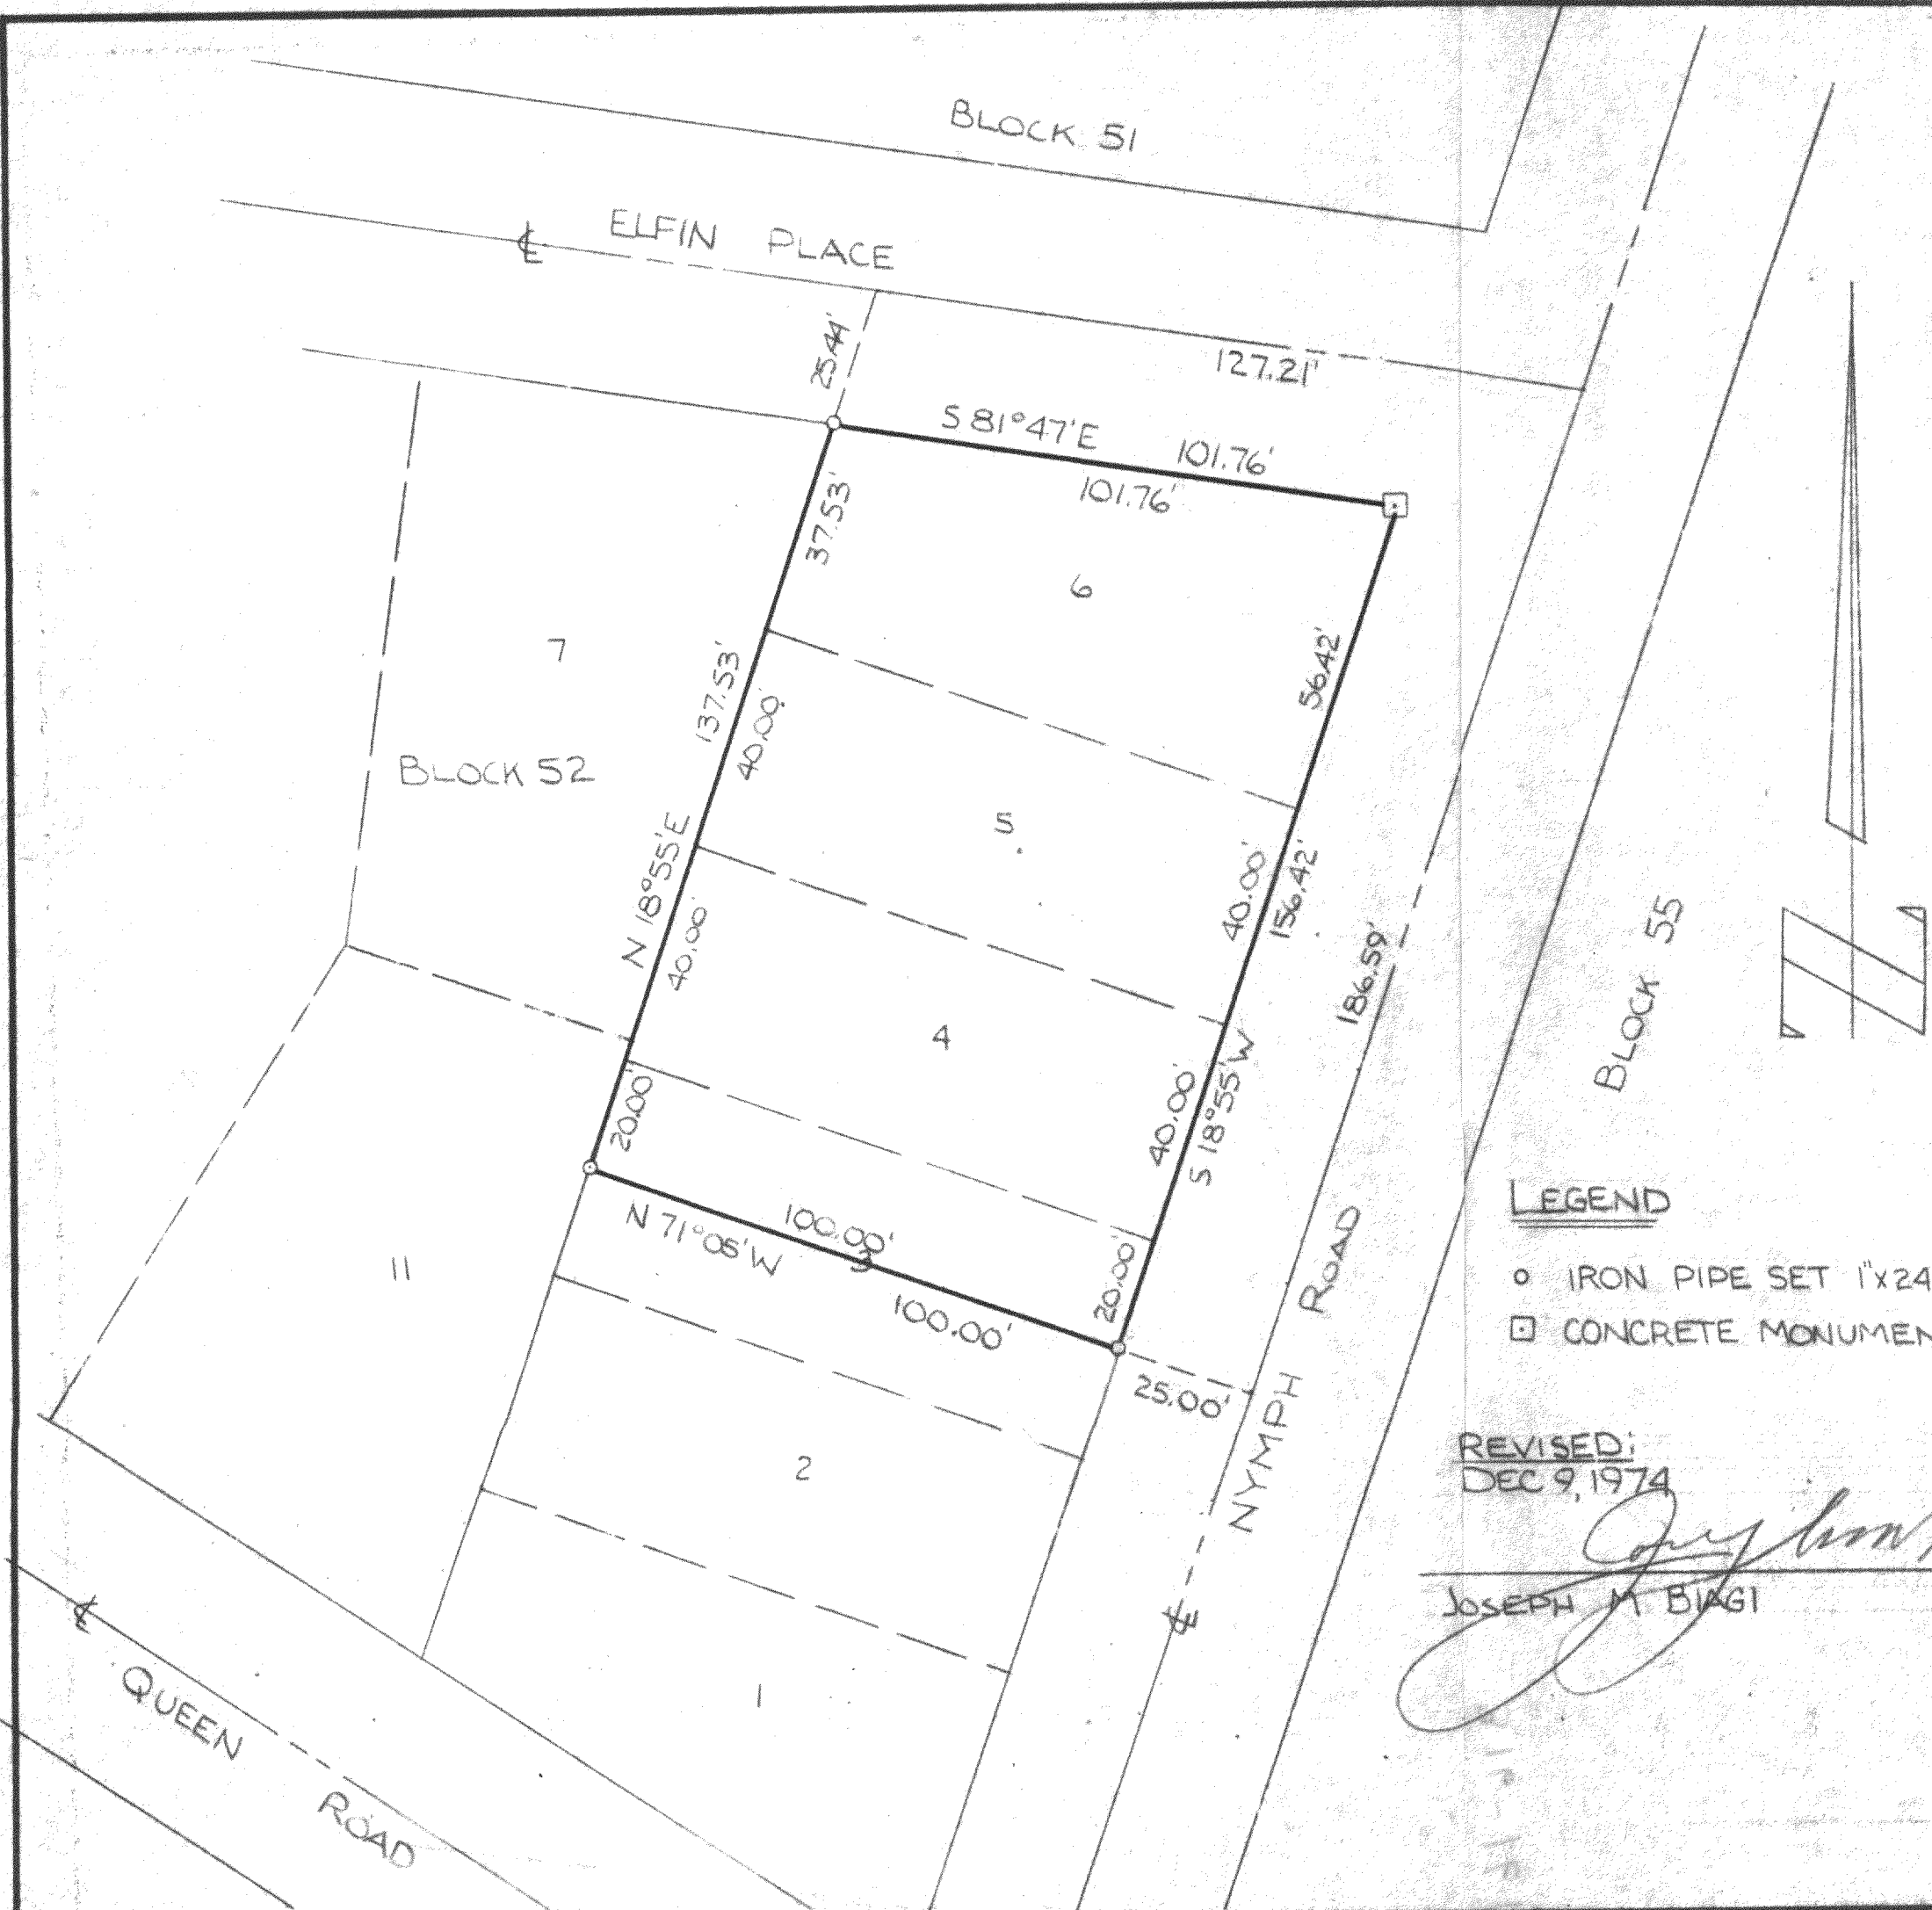


**DESCRIPTION:**  
 THE NE 1/2 OF LOT 3 AND ALL OF LOTS 4, 5, & 6 ALL IN BLOCK 52 OF THE 4<sup>TH</sup> MAP OF INTERLAKEN A SUBDIVISION LOCATED IN SECTION 11, T3N, R16E, WALWORTH COUNTY, WIS. DESCRIBED MORE PARTICULARLY AS FOLLOWS: COMMENCING AT A CONCRETE MONUMENT AT THE NE CORNER OF SAID BLOCK 52, THENCE S 18° 55' W ALONG THE W'LY LINE OF NYMPH ROAD 156.42 FEET, THENCE N 71° 05' W 100.00 FEET, THENCE N 18° 55' E 137.53 FEET TO AN IRON PIPE IN THE S'LY LINE OF ELFIN PLACE, THENCE S 81° 47' E ALONG SAID ROAD LINE 101.76 FEET TO THE PLACE OF BEGINNING.

**CERTIFICATE:**  
 I, JOSEPH M. BIAGI, SURVEYOR, DO HEREBY CERTIFY THAT I HAVE SURVEYED THE LANDS HEREON DESCRIBED

**SIGNED:**  
 OCTOBER 28, 1974

*Joseph M. Biagi*  
 JOSEPH M. BIAGI RLS #12

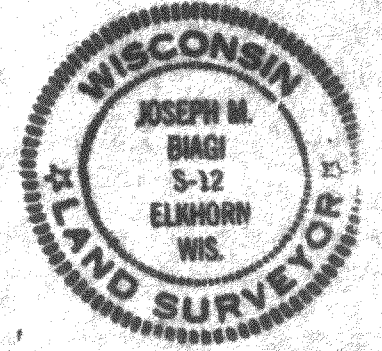

**LEGEND**  
 ○ IRON PIPE SET 1"X24"  
 □ CONCRETE MONUMENT

**REVISED:**  
 DEC 9, 1974

*Joseph M. Biagi*  
 JOSEPH M. BIAGI RLS #12

REVISIONS			MR. WAYNE WULF	
NO.	DATE	BY	SCALE	MATERIAL
1	12/9/74	GW	1" = 30'	NE 1/2 LOT 3 AND ALL OF LOTS 4, 5, & 6
2				BLOCK 52 4 <sup>TH</sup> MAP OF INTERLAKEN
3			DATE	DRAWING NO.
4			10-28-74	
5			APP'D	118-74
			JMB	