
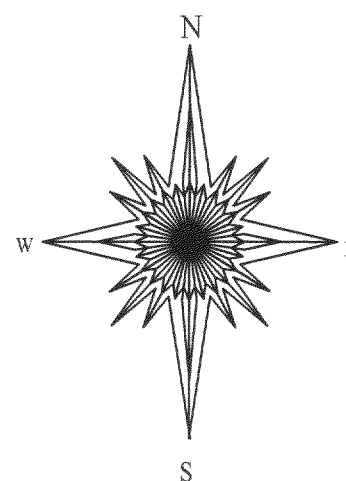
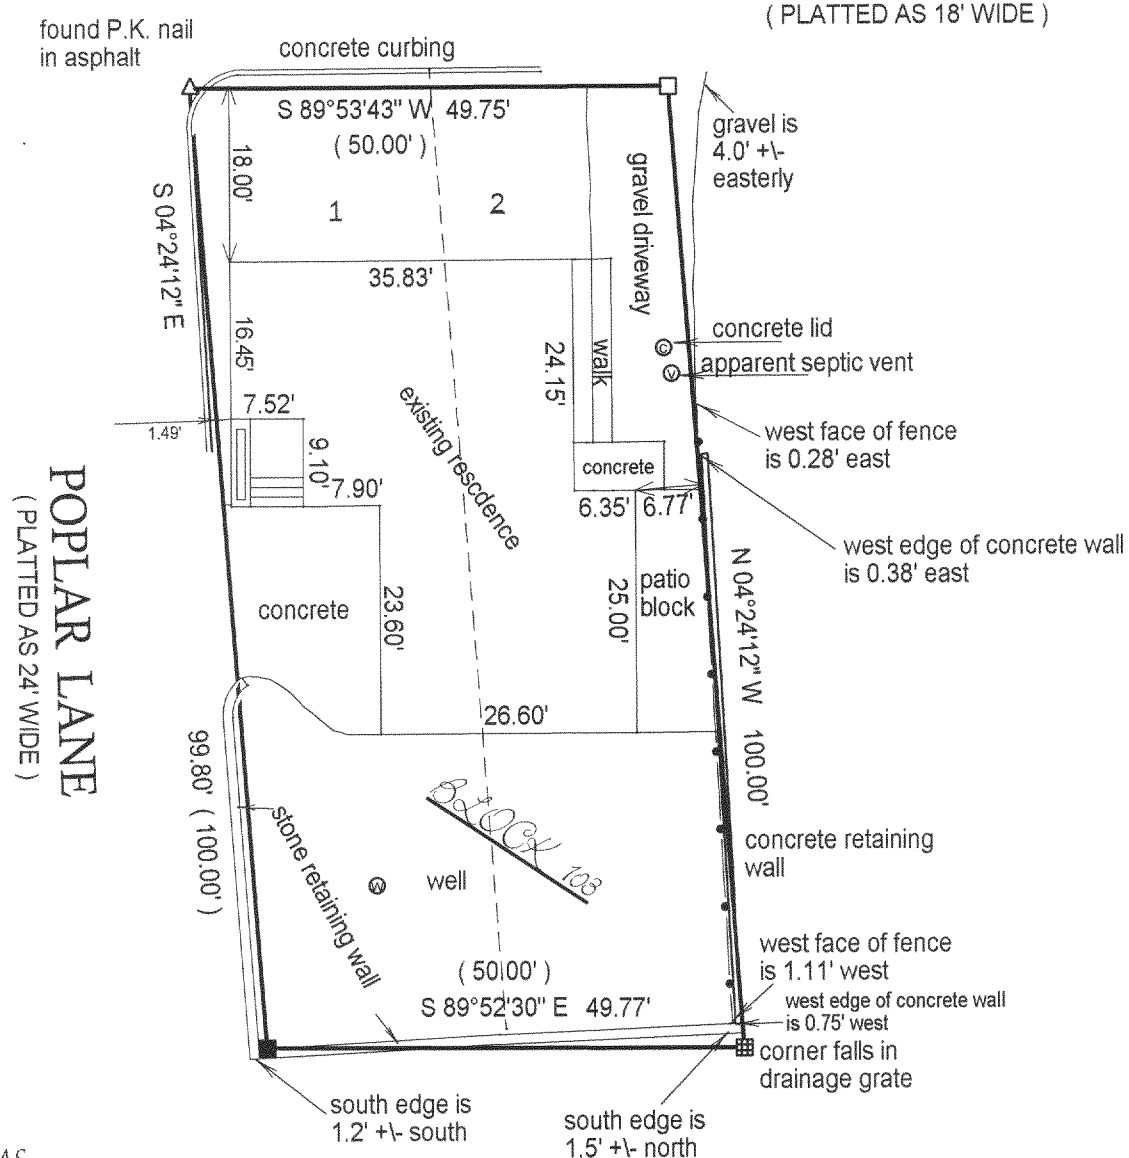


J.K. SURVEYING INC.  
N3705 WILLOWBEND LANE  
LAKE GENEVA, WI, 53147  
262-248-3697

-OF-

LOTS 43,44,45,46,47, & 48, BLOCK 91 ALSO LOTS 1 & 2, BLOCK 103  
LAKE WANDAWEGA SUBDIVISION, A SUBDIVISION LOCATED  
IN TOWN 3 NORTH, RANGE 16 EAST, WALWORTH COUNTY,  
WISCONSIN.

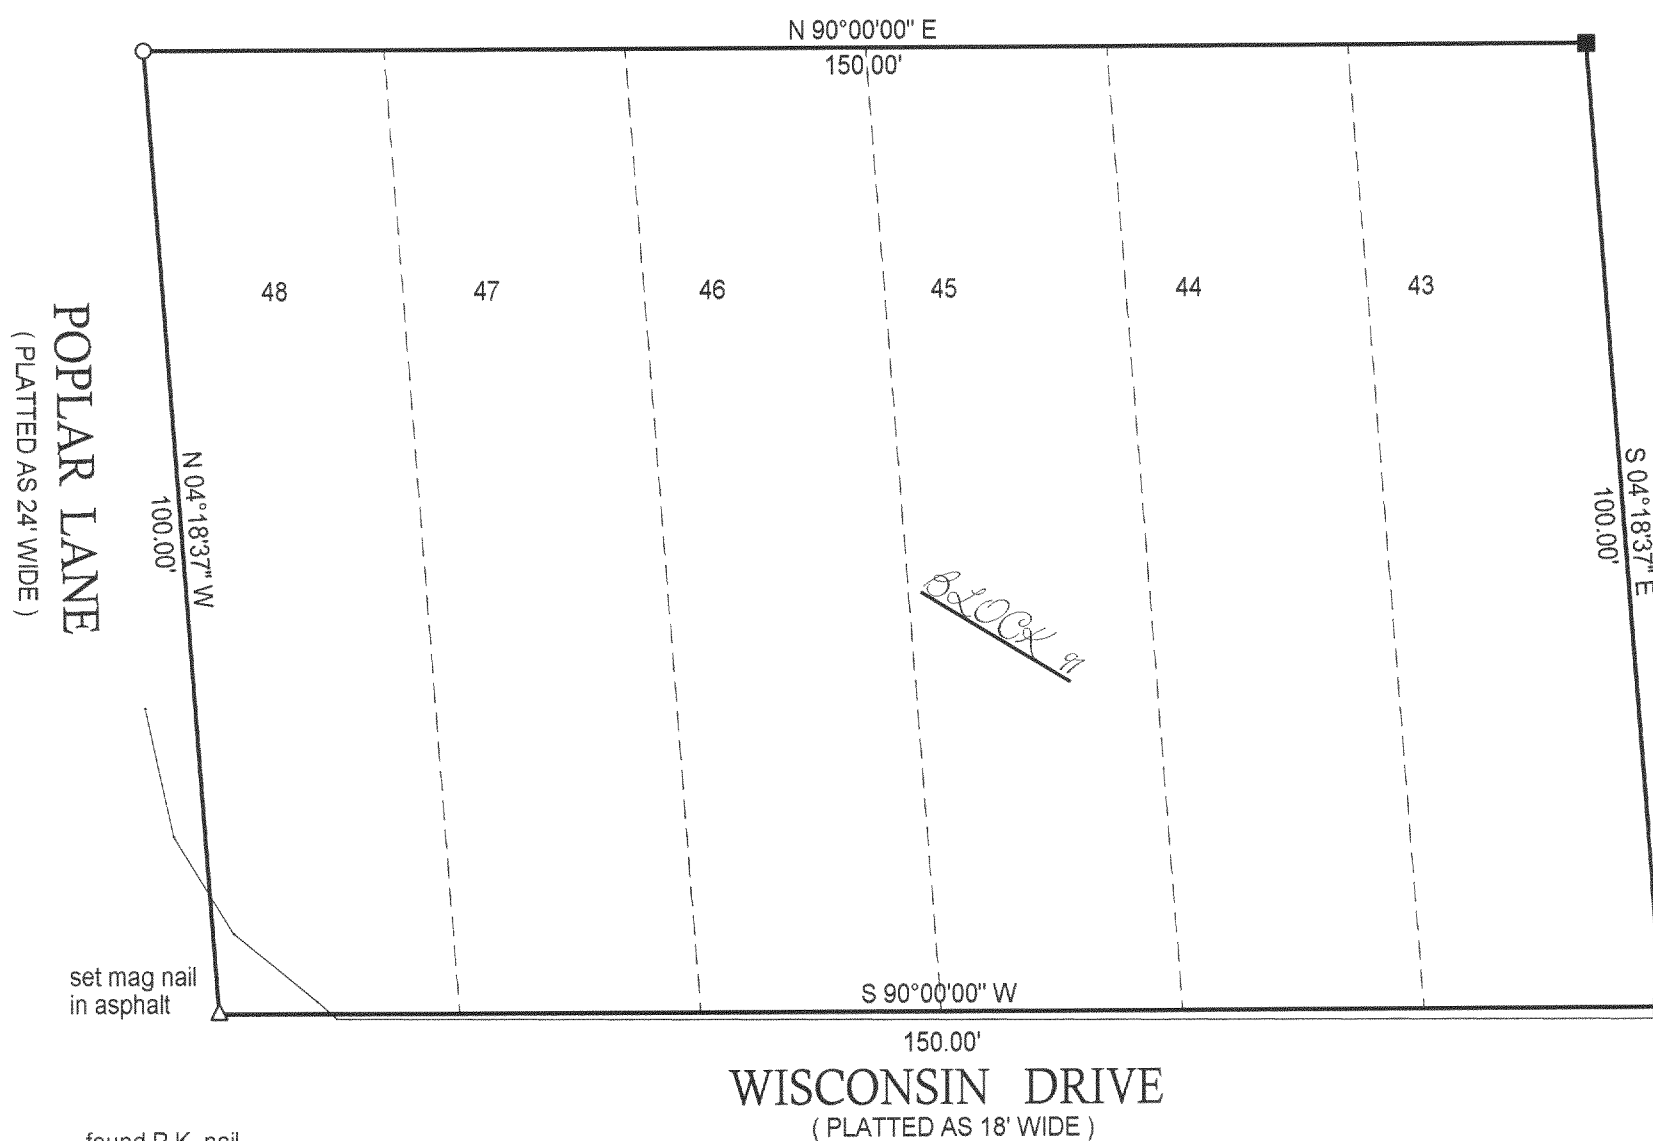

( ) = RECORDED AS

□ = FOUND IRON BAR

○ = FOUND IRON PIPE

● = SET IRON PIPE

■ = SET IRON BAR


SCALE: 1" = 20'

JOB #: 03-769

TAX ID #:GLW 00163 & 00249

COMPARE LEGAL DESCRIPTION ABOVE AND DRAWING WITH DEED. FOR BUILDING RESTRICTIONS AND EASEMENTS NOT SHOWN, REFER TO DEED, ABSTRACT SOURCES AND LOCAL MUNICIPAL CODES. NOTIFY THE SURVEYOR IMMEDIATELY OF ANY DISCREPANCY.

"I hereby certify that the above described property was surveyed under my supervision and that the above map, to the best of my knowledge and belief, is a true representation thereof and shows the size and location of all visible structures, apparent easements and encroachments if any." This survey is made for the present owners of the property, and those who purchase, mortgage, or guarantee the title thereto, within one year from the date hereof.

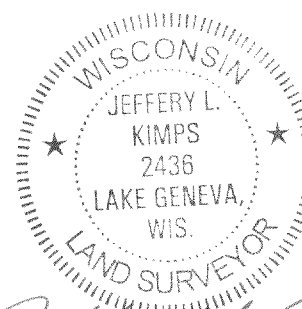

JEFFREY L KIMPS S - 2436  
Wisconsin Registered Land Surveyor  
( original if signed in red )

DATED THE 8 TH, DAY OF JAN. 2004.

316-1616