



PREPARED FOR:  
 BASSO BUILDERS  
 403 SKYLINE DR  
 LAKE GENEVA, WI  
 53147

# PLAT OF SURVEY

J.K. SURVEYING INC.  
 N3705 WILLOWBEND LANE  
 LAKE GENEVA, WI, 53147  
 262-248-3697

- OF -

LOTS 39, 40 AND 41 IN BLOCK 2 OF INTERLAKEN  
 A SUBDIVISION LOCATED IN SECTION 11, TOWN  
 3 NORTH, RANGE 16 EAST, TOWN OF SUGAR  
 CREEK, WALWORTH COUNTY, WISCONSIN.

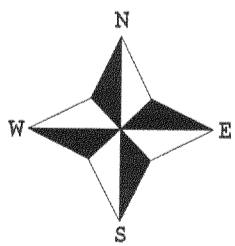
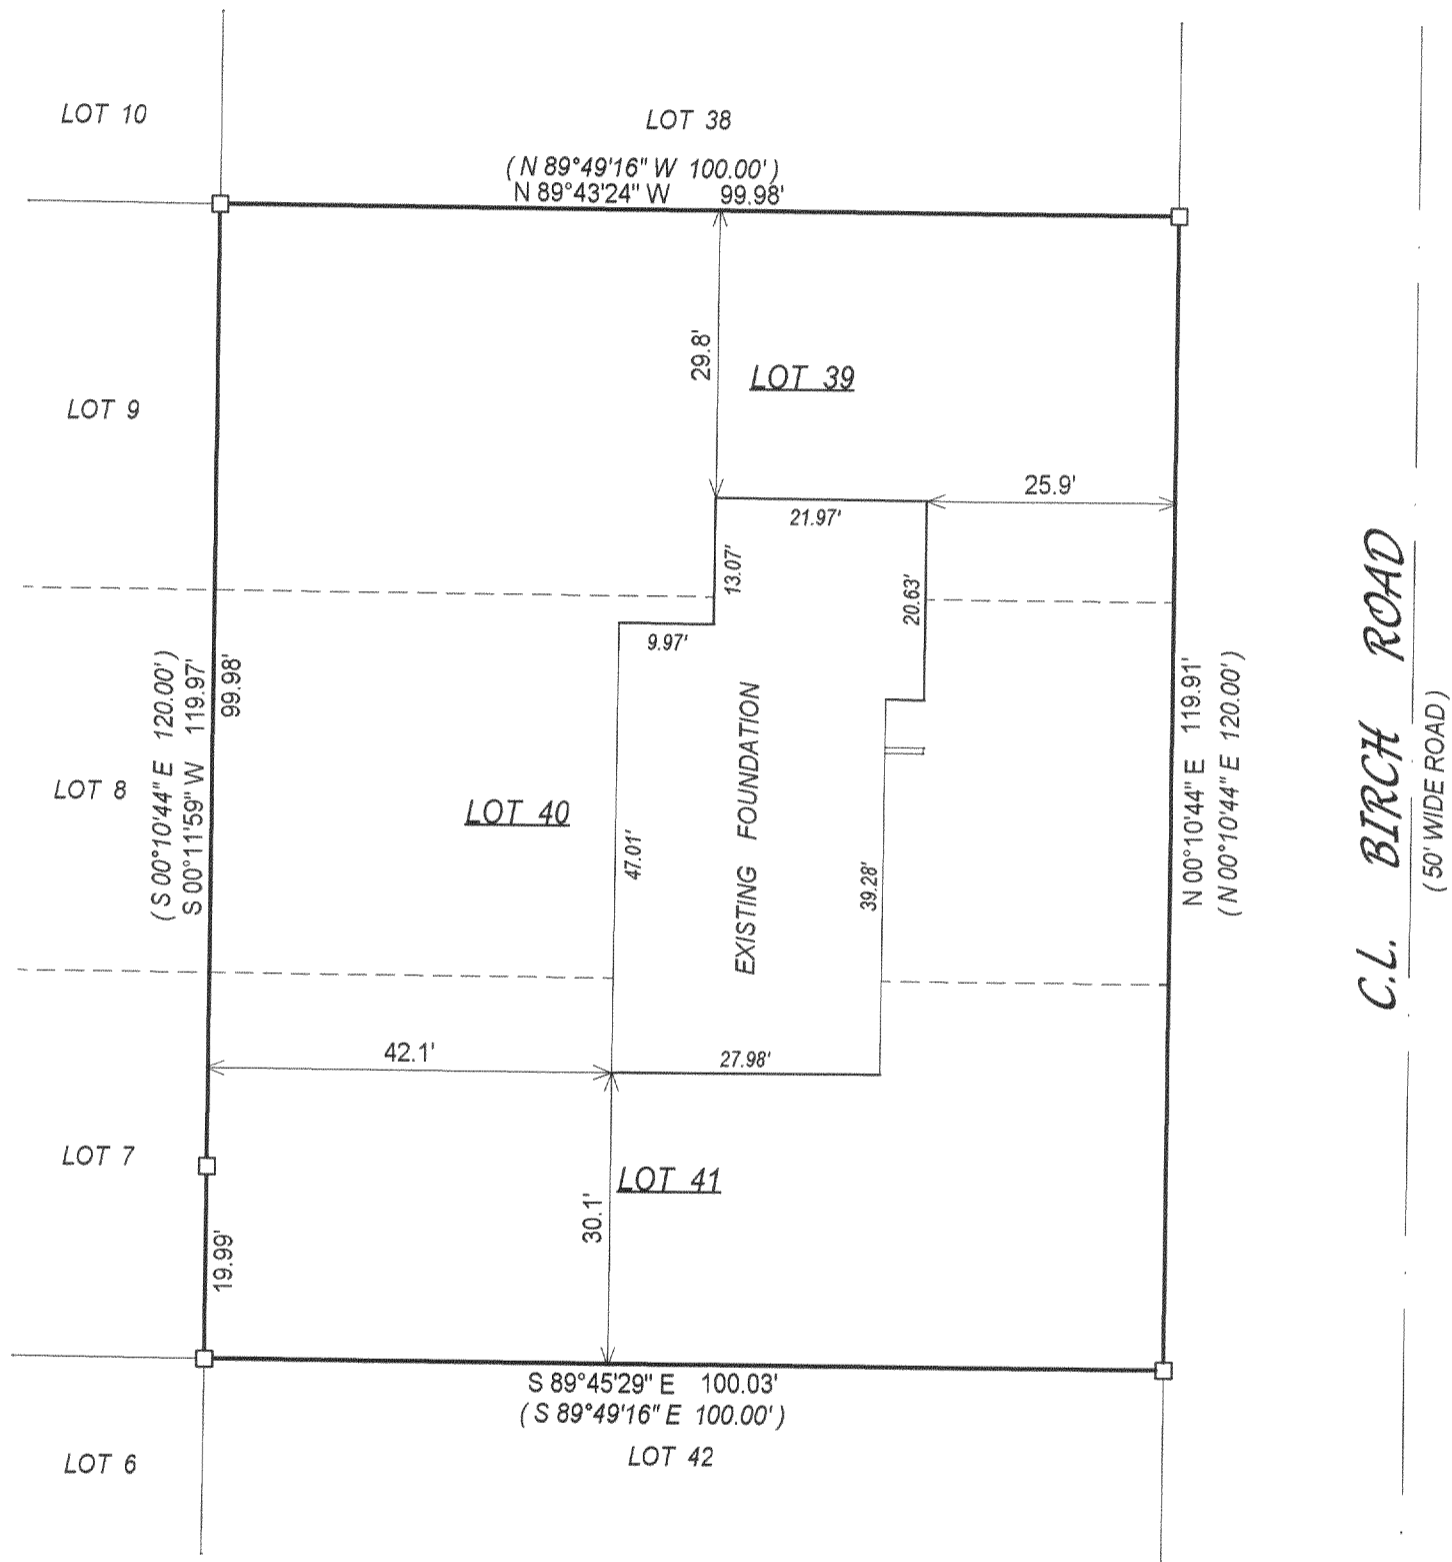


- ( ) = recorded as
- = found iron bar
- = found iron pipe
- = set iron pipe
- = set iron bar

SCALE 1" = 20'

JOB # 04-033AB

TAX ID # G100008C

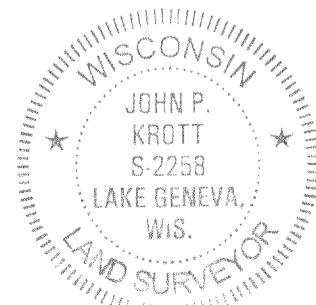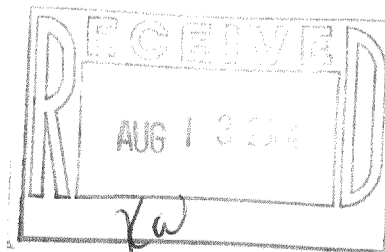

*John P. Krott*

JOHN KROTT S - 2258  
 Wisconsin Registered Land Surveyor  
 (original if signed in red)

DATE OF LAST REVISION 05-27-04  
 DATED THIS THE 4th DAY OF FEBRUARY 2004.

COMPARE LEGAL DESCRIPTION ABOVE AND DRAWING WITH DEED. FOR BUILDING RESTRICTIONS AND EASEMENTS NOT SHOWN, REFER TO DEED, ABSTRACT SOURCES AND LOCAL MUNICIPAL CODES. NOTIFY THE SURVEYOR IMMEDIATELY OF ANY DISCREPANCY.

"I hereby certify that I have surveyed the above described property and that the above map, to the best of my knowledge and belief, is a true representation thereof and shows the size and location of all visible structures, apparent easements and encroachments if any."

This survey is made for the present owners of the property, and those who purchase, mortgage, or guarantee the title thereto, within one year from the date hereof.

316-1665