FARRIS, HANSEN & ASSOCIATES, INC.

ENGINEERING - ARCHITECTURE - SURVEYING 7 RIDGWAY COURT - P.O. BOX 437, ELKHORN, WISCONSIN, 53121

PHONE: (262) 723-2098

FAX: (262) 723-5886

PLAT OF SURVEY

- WORK ORDERED BY -RICHARD HOWARTH - DALLAS DEVELOPEMENT 820 WEST WALWORTH ELKHORN, WI. 53121

LOTS 5, 6, 28, & 29 OF BLOCK 72 OF THE FIFTH MAP OF INTERLAKEN

LOCATED IN THE NW 1/4 OF SECTION 14. TOWN 3 NORTH, RANGE 16 EAST, TOWN OF SUGAR CREEK, WALWORTH COUNTY, WISCONSIN


LEGEND

O = FOUND IRON PIPE STAKE

= SET IRON REBAR STAKE, 3/4" DIA. x 24" x 1.50 lbs./ft.

(XXX) = RECORDED AS


(DANDELION ROAD)

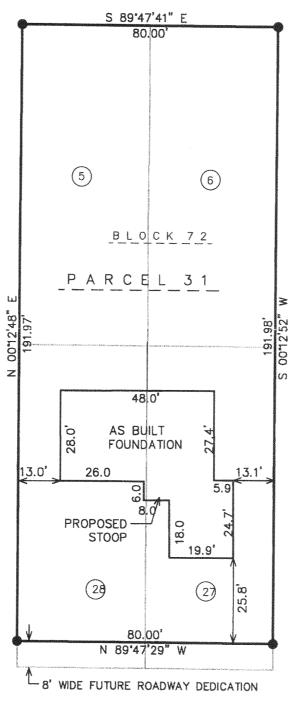

EVERGREEN ROAD

50' WIDE R.O.W.

(66' WIDE AFTER FUTURE R.O.W. DEDICATION)

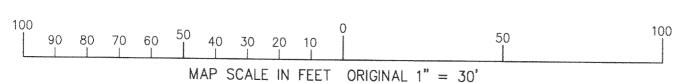

NOTE: COPIES OF THIS MAP TO WHICH THE FOLLOWING CERTIFICATE WILL APPLY SHOW THE SURVEYOR'S ORIGINAL SEAL AND SIGNATURE IN RED INK. COPIES BY ANY OTHER MEANS MAY HAVE ALTERATIONS WHICH DO NOT REPRESENT THE SURVEYOR'S WORK PRODUCT.

I HEREBY CERTIFY THAT THE ABOVE DESCRIBED PROPERTY HAS BEEN SURVEYED UNDER MY DIRECTION AND THAT THE ABOVE MAP IS A TRUE REPRESENTATION THEREOF AND SHOWS THE SIZE AND LOCATION OF THE PROPERTY AND ITS EXTERIOR BOUNDARIES. THIS SURVEY IS MADE FOR THE USE OF THE PRESENT OWNERS OF THE PROPERTY, AND ALSO THOSE WHO PURCHASE, MORTGAGE, OR GUARANTEE THE TITLE THERETO WITHIN ONE YEAR FROM THE DATE HEREOF.

REVISED 08-30-04 TO SHOW SIZE & LOCATION

MAY 3, 2004

DATED REVISED 08-09-04

OF AS BUILT FOUNDATION

PROJECT: 5015.31 DATE: 05-03-2004 SHEET: 1 OF 1

SEP 2 2 2004

Marie and 7)

PETER S. GORDON GI 00642

WEST

ASSIGNED

316-1670

R.L.S. 2101