PLAT OF SURVEY

-OF-

LOT 5, POPLAR RIDGE SUBDIVISION, BEING A REDIVISION OF LOTS 45-47, BLOCK 68, AND LOTS 25 AND 26, BLOCK 74, LAKE WANDAWEGA SUBDIVISION, BEING A PART OF GOVERNMENT LOT 1 OF SECTION 1 AND PART OF GOVERNMENT LOT 1 OF SECTION 2, ALL IN TOWN 3 NORTH, RANGE 16 EAST OF THE FOURTH PRINCIPAL MERIDIAN, TOWN OF SUGAR CREEK, WALWORTH COUNTY, WISCONSIN.

SURVEY FOR: SOUTHEASTERN WISCONSIN HOUSING CORPORATION


PROPOSED ADDRESS: _____ DELAVAN DRIVE


I HEREBY CERTIFY THAT THE EXISTING FOUNDATION SHOWN ON THIS PLAT OF SURVEY IS LOCATED AS SHOWN THUS (), DATED THIS 4TH DAY OF NOVEMBER, 2004.

trankling. Ukman

FRANKLIN J. LEHMAN

S-2211

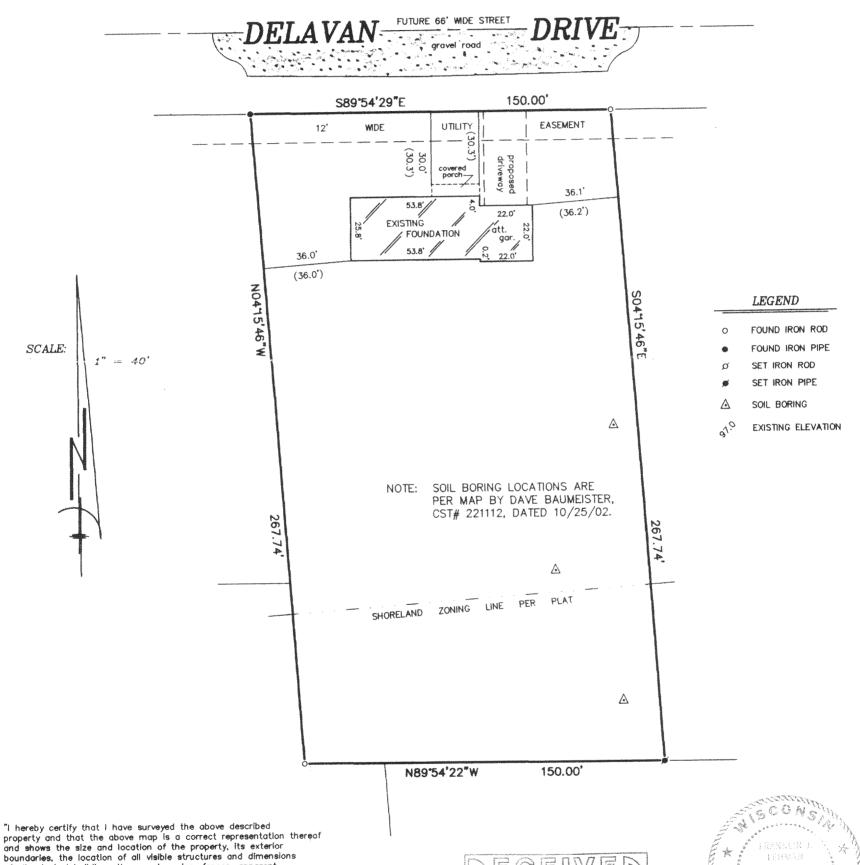

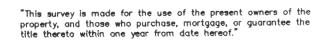

of all principal buildings thereon, boundary fences, apparent easements, roadways and encroachments, if any."



B.W. SURVEYING, INC.

LAND SURVEYS
MAPPING AND PLANNING
412 N. PINE STREET
BURLINGTON, WI 53105
(262)-767-0225



THIS IS NOT AN ORIGINAL PRINT

THIS IS NOT AN ORIGINAL PRINT UNLESS THIS SEAL IS RED.

Franklin J. LEHMAN S-2

SEPTEMBER 22, 2004
DATE

6506 JOB NUMBER

GPR-5