

J.K. SURVEYING INC.
N3705 WILLOWBEND LANE
LAKE GENEVA, WI, 53147
262-248-3697



PREPARED FOR:
LAKEWOOD CONSTRUCTION
JOHN CONSOLINO

PLAT OF SURVEY

- OF -

LOTS 22 AND 23 IN BLOCK 39 OF INTERLAKEN SUBDIVISION,
TOGETHER WITH THAT PART OF LOT 21 DESCRIBED AS FOLLOWS:
COMMENCING AT THE MOST SOUTHERLY CORNER OF LOT 22
(a concrete monument at the northerly right of way of Club House Circle)

Thence southwesterly along a non-tangent curve, concave to the southeast, having a radius of 185.00 feet, a central angle of 4°37'37", and a chord of 14.94 feet bearing N47°48'39"E ; thence N43°32'18"W, a distance of 44.65 feet; thence N34°26'22"W, a distance of 17.64 feet; thence N23°04'41"W, a distance of 39.98 feet; thence S42°29'11"E, a distance of 99.90 feet to the POINT OF BEGINNING; said described tract containing 0.0 Acres, more or less.

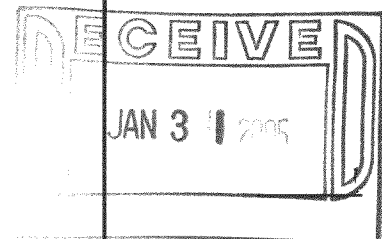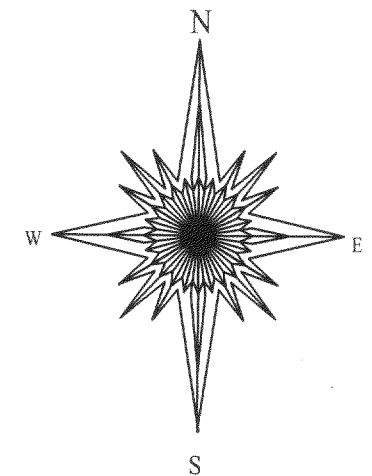

- () = recorded as
- = found iron bar
- = found iron pipe
- = set iron pipe
- = set iron bar

SCALE 1" = 20'

JOB # 02-558PHBAB

TAX ID # G100346 A

5' SEPTIC EASEMENT
FOR THE USE OF LOT 2
0.01 acres
309.37 sq ft

LOT 22

LOT 23

FOUNDATION
AS BUILT
7-7-2004

0.24 acres
10608.61 sq ft

FOUND CONCRETE
MONUMENT

FOUND CONCRETE
MONUMENT

revised 5-13-2004 changed lot line adjustment

REVISED 4-21-2004

REVISED 7-7-2004 FOUNDATION AS BUILT

COMPARE LEGAL DESCRIPTION ABOVE AND DRAWING WITH DEED. FOR BUILDING RESTRICTIONS AND EASEMENTS NOT SHOWN, REFER TO DEED, ABSTRACT SOURCES AND LOCAL MUNICIPAL CODES. NOTIFY THE SURVEYOR IMMEDIATELY OF ANY DISCREPANCY.

"I hereby certify that I have surveyed the above described property and that the above map is a true representation thereof and shows the size and location of all visible structures, apparent easements and encroachments if any."

This survey is made for the present owners of the property, and those who purchase, mortgage, or guarantee the title thereto, within one year from the date hereof.

DATED THIS THE 22nd DAY OF OCTOBER 2002.



JEFFREY L. KIMPS S - 2436
Wisconsin Registered Land Surveyor
(original if signed in red)

316-1705