

# PLAT OF SURVEY




Engineers • Land Surveyors • Environmental Scientists  
801 MAIN STREET MUKWONAGO, WISCONSIN 53149 (262) 363-2004

FOR: SHOREWEST REALTY

DATE: 04/26/2005

DESCRIPTION: BEING LOTS 14, 13, THE NORTH 1/2 OF LOT 15, AND THE SOUTH 1/2 OF LOT 12 BLOCK 18, OF INTERLAKEN 2ND MAP, LOCATED IN THE SE 1/4 OF SECTION 11, TOWN 3 NORTH, RANGE 16 EAST, TOWN OF SUGAR CREEK, WALWORTH COUNTY, WISCONSIN.

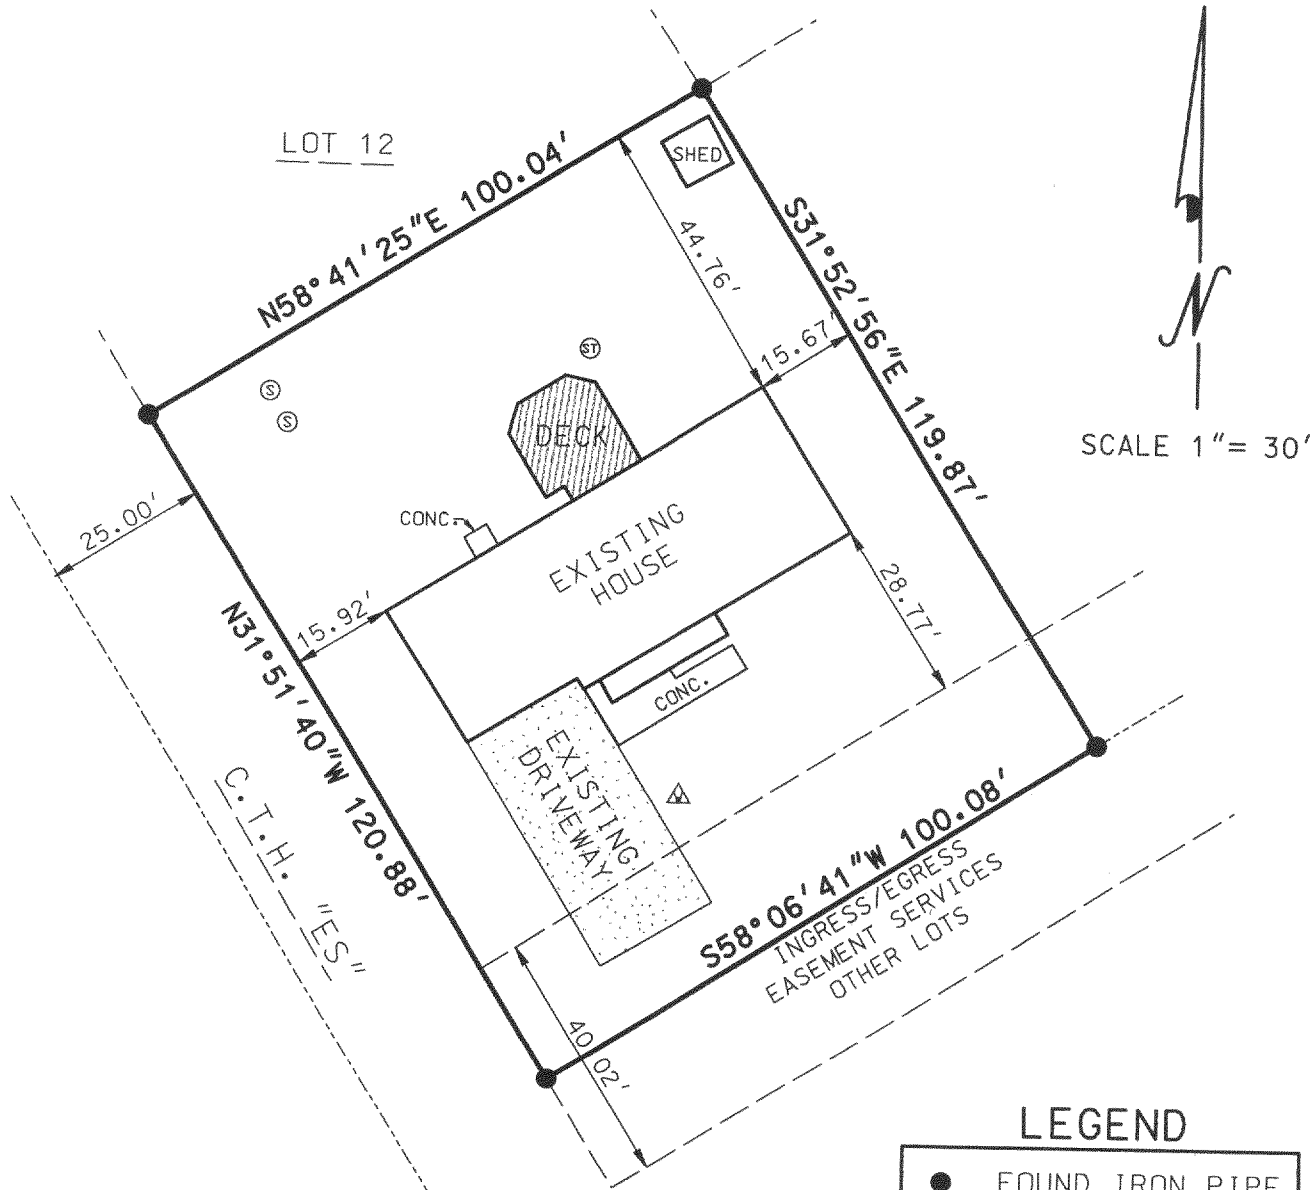

SCALE 1" = 30'

### LEGEND

- FOUND IRON PIPE
- ⊙ SEPTIC VENT
- ⊙ SEPTIC TANK
- △ WELL

RECEIVED  
MAY 31 2005

I PAUL H. VAN HENKELUM R.L.S. # 1931 HEREBY CERTIFY THAT THIS SURVEY WAS MADE IN ACCORDANCE WITH THE MINIMUM STANDARDS FOR PROPERTY SURVEYS (CHAPTER A-E7) STATE OF WISCONSIN AND HAS BEEN PREPARED UNDER MY DIRECTION AND CONTROL AND IS CORRECT TO THE BEST OF MY KNOWLEDGE AND BELIEF.



*Paul H. Van Henkelum*  
PAUL H. VAN HENKELUM, R.L.S. # 1931  
RSV# 05078.DGN

GI 0002A1

316-1736