
## **ABELL** SURVEYING & MAPPING

1140 SEQUOIA STREET . DELAVAN, WISCONSIN 53115 262-728-6737

CANARY ROAD

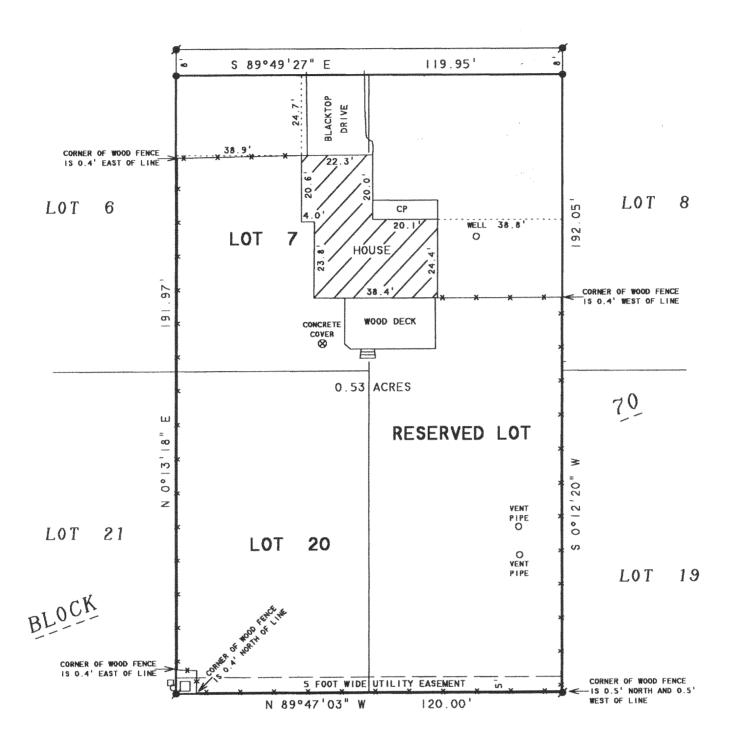

## DANDELION

ROAD

(UNIMPROVED)

## PLAT OF SURVEY OF

LOTS 7, 20 AND THE RESERVED LOT IN BLOCK 70 IN THE FIFTH MAP OF INTERLAKEN. LOCATED IN T3N.RIGE, WALWORTH COUNTY, WISCONSIN. EXCEPTING THEREFROM THE NORTH 8 FEET.

ORDERED BY: SHOREWEST REALTORS 830 E. GENEVA STREET

DELAVAN, WI 53115

NOTE: BEARINGS ARE REFERENCED TO EXISTING SURVEY RECORDS.





SCALE | " = 30 '

LEGEND

# - IRON ROD FOUND - IRON ROD SET CP - CONCRETE PORCH O- UTILITY PEDS \*- - WOOD FENCE

( )- RECORDED AS

I HEREBY CERTIFY THAT I HAVE SURVEYED THE ABOVE DESCRIBED PROPERTY AND THAT THE ABOVE MAP IS A TRUE REPRESENTATION THEREOF AND SHOWS THE SIZE AND LOCATION OF THE PROPERTY, ITS EXTERIOR BOUNDARIES. THE LOCATION OF ALL VISIBLE STRUCTURES AND DIMENSIONS OF ALL PRINCIPAL BUILDINGS THEREON. BOUNDARY FENCES. APPARENT EASEMENTS. ROADWAYS AND VISIBLE ENCROACHMENTS, IF ANY, TO THE BEST OF MY KNOWLEDGE AND BELIEF.

THIS SURVEY IS MADE FOR THE USE OF THE PRESENT OWNERS OF THE PROPERTY, AND ALSO THOSE WHO PURCHASE, MORTGAGE, OR GUARANTEE THE TITLE THERETO WITHIN ONE (1) YEAR FROM DATE HEREON.

DAVID F. ABELL WISCONSIN REGISTERED LAND SURVEYOR. S-1596

July 20, 2005

JOB NUMBER - 05088