LAND-MARK SURVEYING Mark L. Miritz

N9330 Knuteson Drive Whitewater, WI 53190 Phone:(262)495-3284 FAX: (262) 495-8421

Wisconsin Registered Land Surveyor S-2582

LAND-MARKSURVEYING.COM

PLAT OF SURVEY


THE EASTERLY 1/2 OF LOT 3 AND ALL OF LOTS 4 AND 5 OF BLOCK 11, OF INTERLAKEN SUBDIVISION, LOCATED IN SOUTH 1/2 OF SECTION 11, TOWN 3 NORTH, RANGE 16 EAST, TOWN OF SUGAR CREEK. WALWORTH COUNTY,



SCHAUDER BUILDING, INC. 4115 U.S. HIGHWAY 51 NORTH **JANESVILLE, WI 53545-9674**



REVISED 7/22/2005 TO SHOW FOUNDATION "AS BUILT"

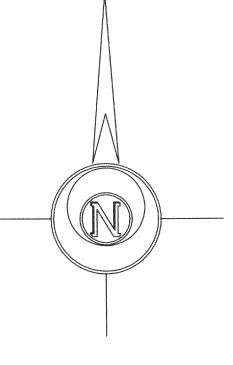

LEGEND

FOUND IRON PIPE

FOUND IRON ROD

10' BUILDING OFFSET STAKE \boxtimes

FOUND CONCRETE MONUMENT

CHISEL CUT IN CONCRETE

SET IRON ROD, 24" LONG, WEIGHING 1.5 LBS./LINEAL FT., 3/4" DIA.

RECORDED AS DIMENSION

EXISTING FENCE

SCALE: 1" = 30 FEET

"I hereby certify that the above described property has been surveyed by me or under my direction and that the above map is a true representation thereof and shows the size and location of the property, its exterior boundaries, the location of all visible structures and dimensions of all principal buildings thereon, boundary fences, apparent easements, roadways and visible encroachments, if any."

"This survey is made for the use of the present owners of the property, and also those who purchase, mortgage, or guarantee the title thereto within one year from date

MARK L. MIRITZ WISCONSIN REGISTERED LAND SURVEYOR S-2582

DATE: JUNE 9, 2005 JOB NO. 05.605