

FARRIS, HANSEN & ASSOCIATES, INC.



ENGINEERING — ARCHITECTURE — SURVEYING
 7 RIDGWAY COURT — P.O. BOX 437 — ELKHORN, WISCONSIN 53121
 PHONE: (262) 723-2098 FAX: (262) 723-5886

PLAT OF SURVEY

LOTS 6-8, BLOCK 34 OF INTERLAKEN
 LOCATED IN PART OF THE SOUTH 1/2 OF SECTION 11,
 TOWN 3 NORTH, RANGE 16 EAST,
 TOWN OF SUGAR CREEK, WALWORTH COUNTY, WISCONSIN

— WORK ORDERED BY —
 KEN WISWELL
 131 WEST MARKET STREET
 ELKHORN, WI 53121

ASSIGNED SOUTH LINE OF CLUB HOUSE DRIVE
 N 32°32'00" E

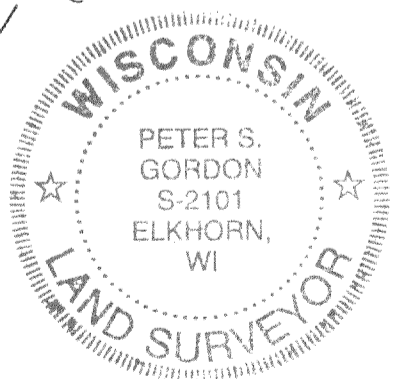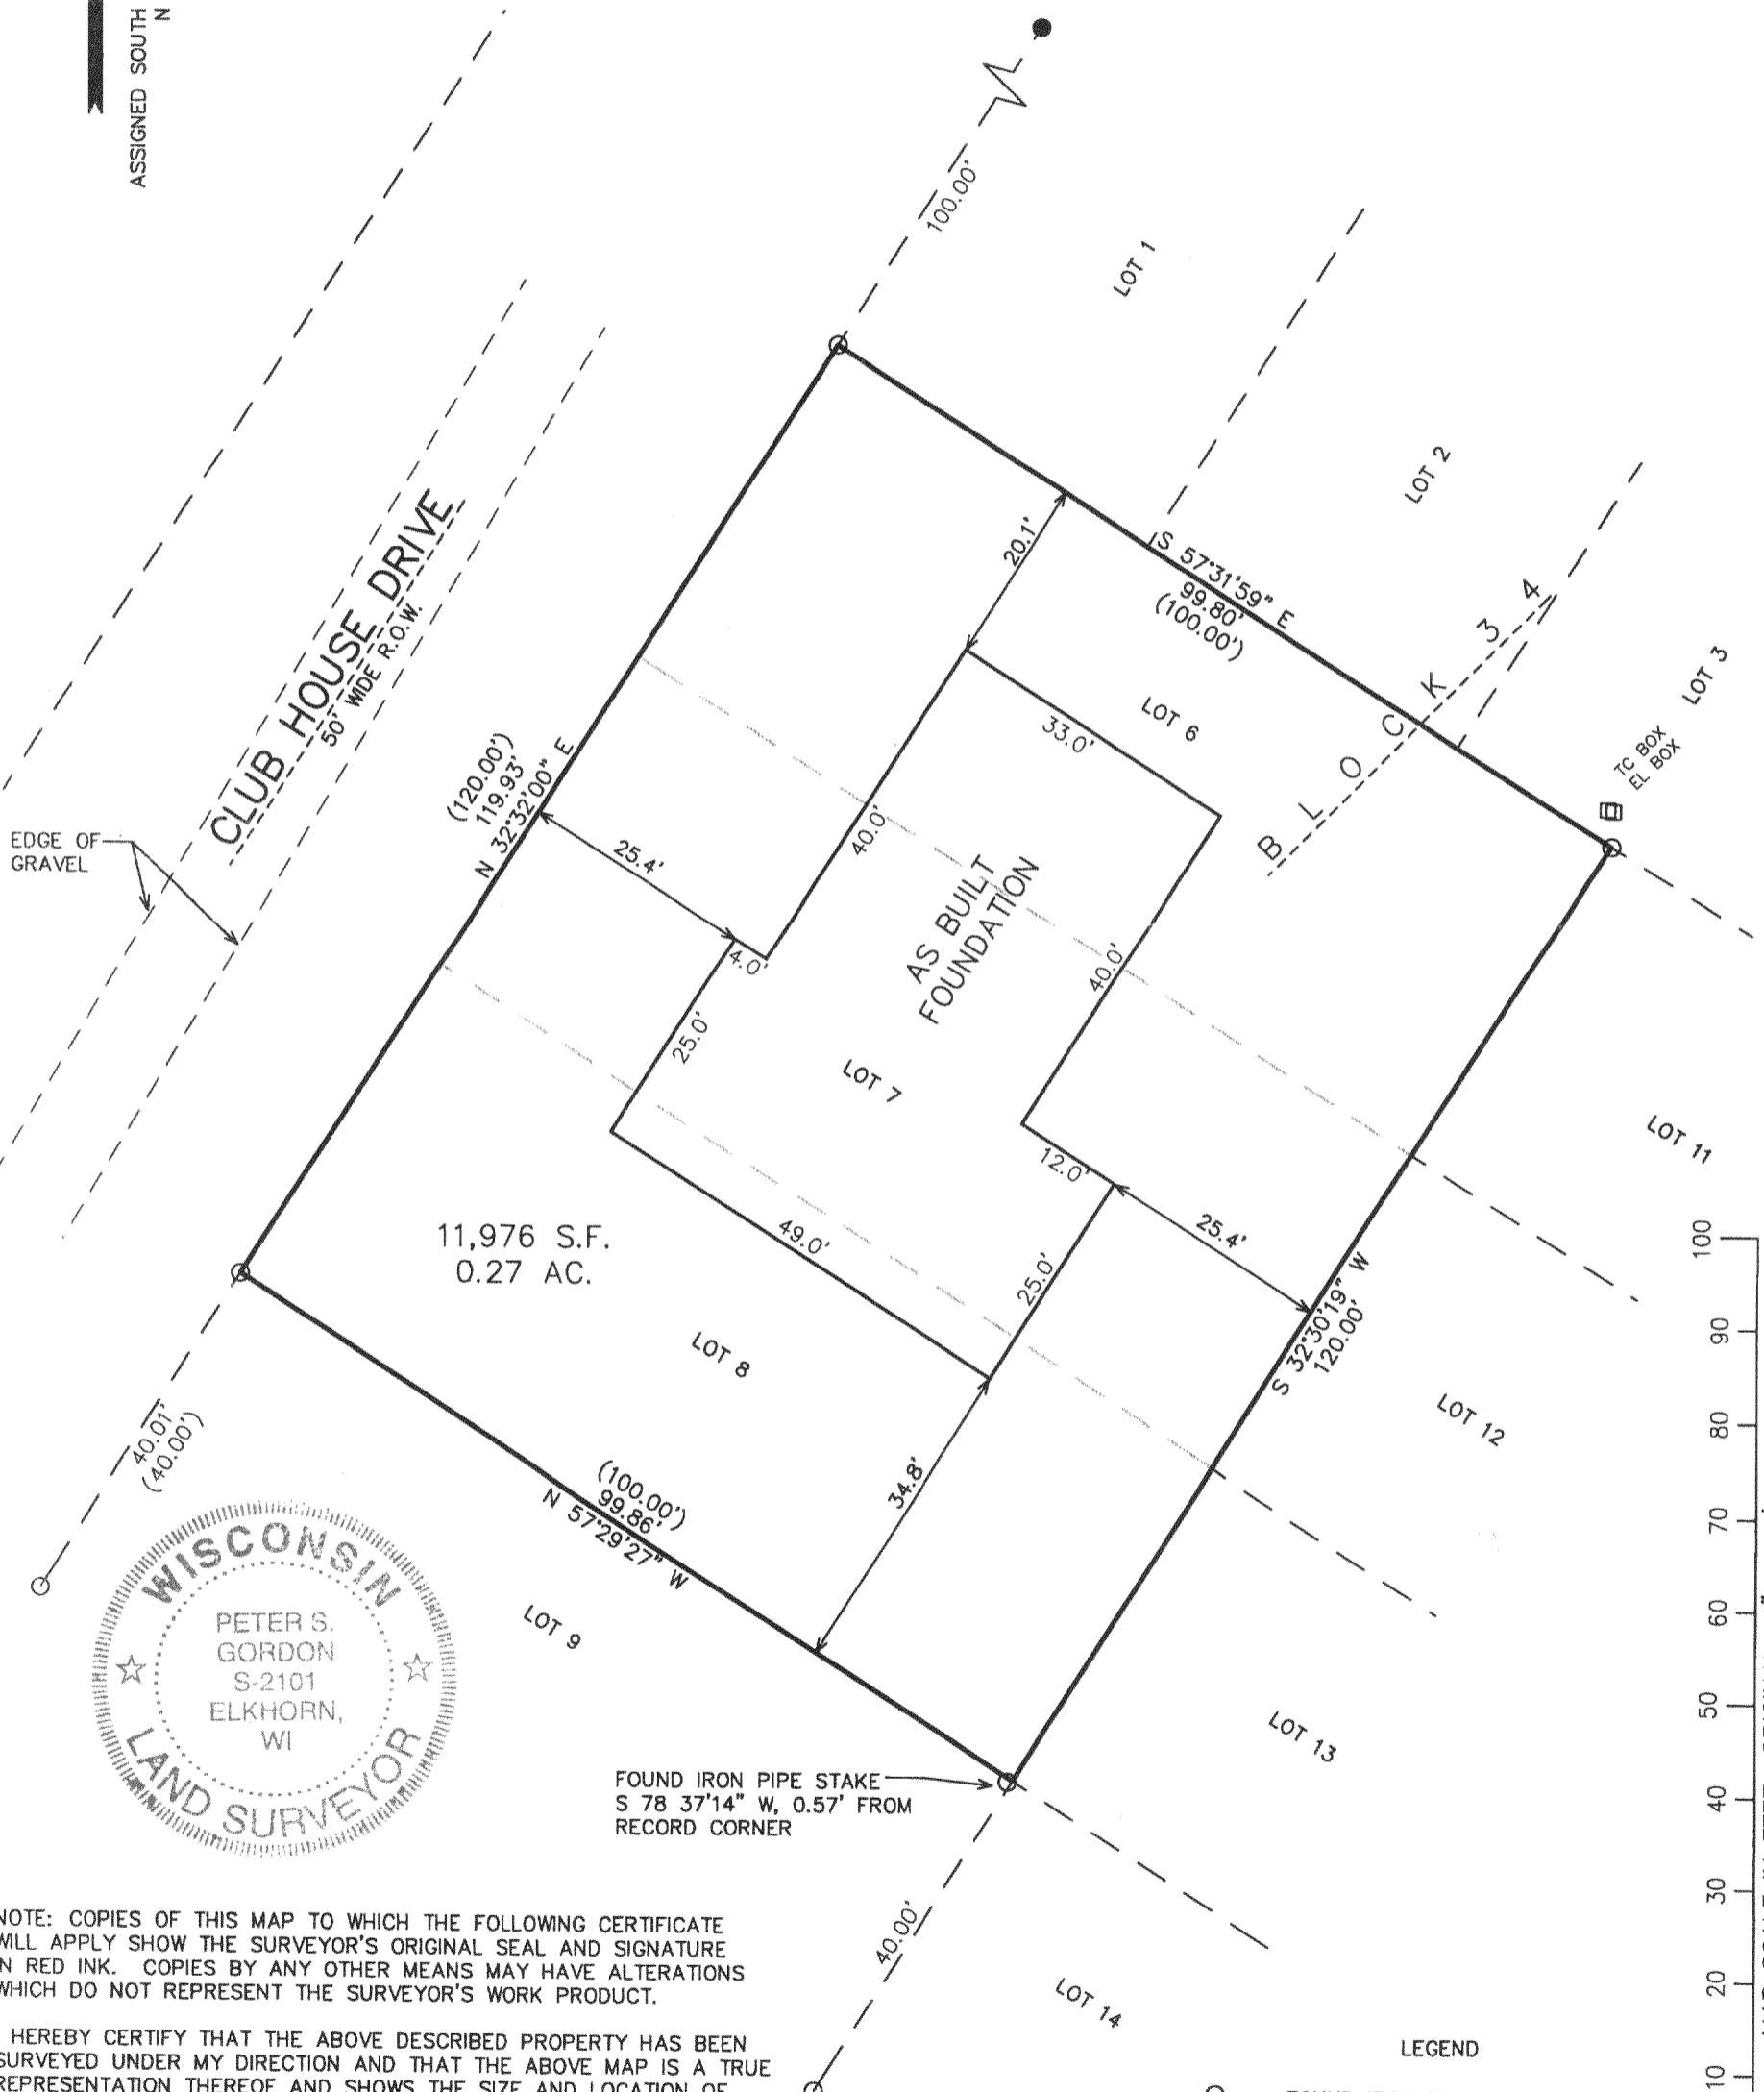


NOTE: COPIES OF THIS MAP TO WHICH THE FOLLOWING CERTIFICATE WILL APPLY SHOW THE SURVEYOR'S ORIGINAL SEAL AND SIGNATURE IN RED INK. COPIES BY ANY OTHER MEANS MAY HAVE ALTERATIONS WHICH DO NOT REPRESENT THE SURVEYOR'S WORK PRODUCT.

I HEREBY CERTIFY THAT THE ABOVE DESCRIBED PROPERTY HAS BEEN SURVEYED UNDER MY DIRECTION AND THAT THE ABOVE MAP IS A TRUE REPRESENTATION THEREOF AND SHOWS THE SIZE AND LOCATION OF THE PROPERTY AND ITS EXTERIOR BOUNDARIES. THIS SURVEY IS MADE FOR THE USE OF THE PRESENT OWNERS OF THE PROPERTY, AND ALSO THOSE WHO PURCHASE, MORTGAGE, OR GUARANTEE THE TITLE THERETO WITHIN ONE YEAR FROM THE DATE HEREOF.


DATED: MAY 25, 2005

 PETER S. GORDON R.L.S. 2101

REVISED 06-14-2005
 REVISED 08-31-2005
 TO SHOW SIZE & LOCATION OF
 AS BUILT FOUNDATION

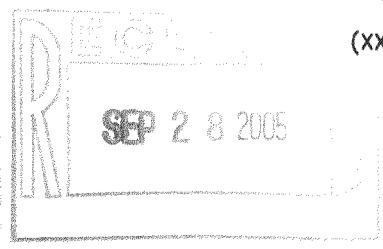

- LEGEND
- = FOUND IRON PIPE STAKE
 - = FOUND IRON REBAR STAKE
 - (XXX) = RECORDED AS

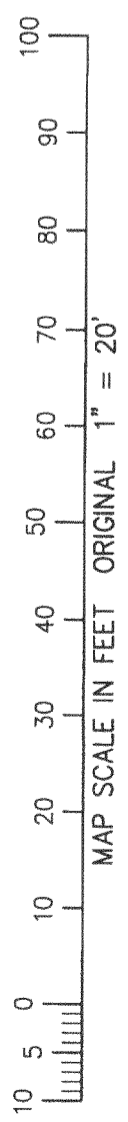

PROJECT: 6791
 DATE: 05/25/2005
 SHEET 1 OF 1

E:\31725\31725\Projects\6791\Coord\SURVEY

AUG 31 2005 GI 06293A

316-1780