

Manowa Trail (40' Wide)


Arc=200.26'  
Radius=3582.7', Chord=N76°28'24"E 200.23'  
(N76°28'E 200.17')

# Plat of Survey

of  
**Lot 4 of Certified Survey Map No. 204,**  
 recorded in Vol. 1 of Certified Survey Maps of Walworth  
 County on Page 204 and located in the Northeast 1/4  
 of Section 11, Town 3 North, Range 16 East, Town of  
 Sugar Creek, Walworth County, Wisconsin.


Surveyed for: **Russ Treiterer**  
 N6814 Avataia Trail  
 Elkhorn, Wisconsin. 53121

Lot 6  
 Block 7  
 Lake  
 Wandawega  
 Highlands

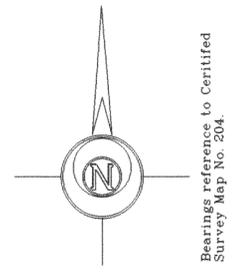

Lot 3  
 C.S.M. 204

**Lot 4**  
 1.363 Acres  
 59,368 Sq.Ft.

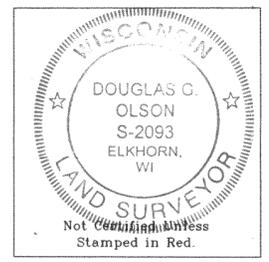


- Notes: 1) This survey plat is not certified unless signed and sealed in red ink.  
 2) This survey is subject to Wisconsin lien laws. This Plat of Survey is the notice of intent to file lien. Lien waiver required.

Copyright © 2005, Jensen & Olson Land Surveying, LLC.  
 All rights reserved. No part of this survey plat may be reproduced or transmitted in any form by any means - graphic, electronic, or mechanical, including photocopying, tracing, or information storage and retrieval systems - without permission in writing from Douglas G. Olson, Jensen & Olson Land Surveying, LLC.

I, Douglas G. Olson, Wisconsin Registered Land Surveyor, do hereby certify that this survey was performed by me or under my direction in full compliance with the owner's / agent's instructions and Chapter A-E 7 of the Wisconsin Administrative Code "Minimum Standards for Property Surveys"; and that this map is an accurate representation thereof to the best of my knowledge and belief.

Douglas G. Olson  
 Wisconsin Registered Land Surveyor - 2093

Lot 5  
 Block 1  
 Lake Wandawega  
 Highlands  
 1st Addition

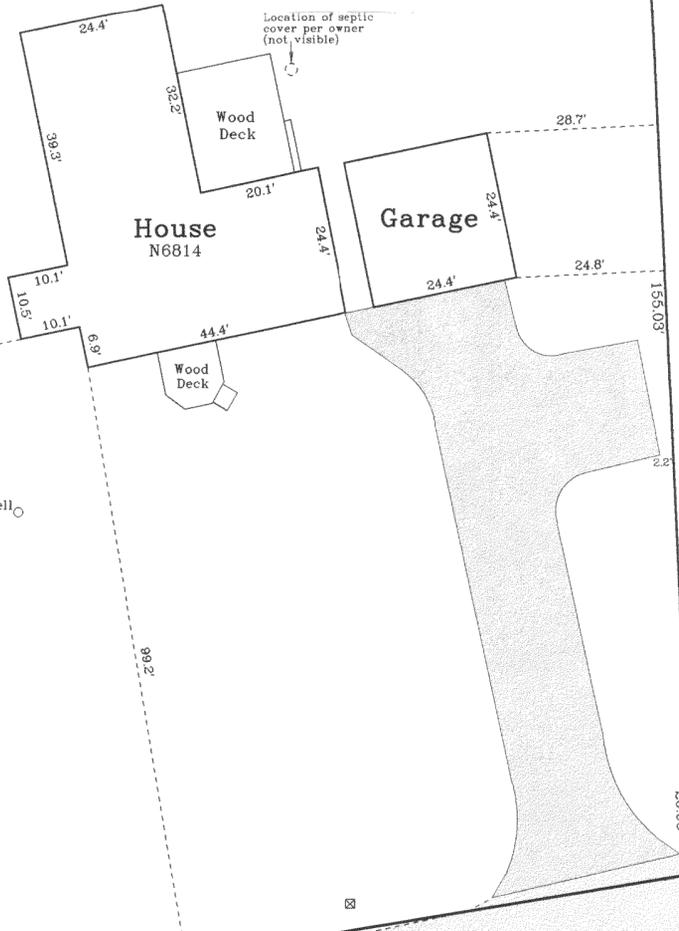


Akwenasa Trail (40' Wide)

Avataia Trail (40' Wide)

2005.128  
 Sheet 1 of 1 Sheets  
 Job Reference Number  
 2005.128

Legend	
■	Found Concrete Monument
⊗	Found Iron Pipe
●	Found Iron Rod
( )	Recorded Information
⊕	Utility Pedestal
▨	Asphalt Surface
▩	Gravel Surface

**Jensen & Olson Land Surveying, LLC**  
 45 South Wisconsin Street P.O. Box 322  
 Elkhorn, Wisconsin. 53121  
 Telephone (262) 723-3434  
 Facsimile (262) 723-8044

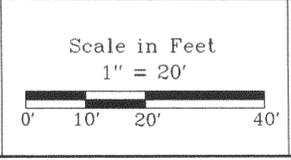

Survey Date: Sept. 15, 2005.  
 Revisions:

GA 20400004

316-1783