

Manowa Trail (40' Wide)

Arc=200.26'
Radius=3582.7', Chord=N76°28'24"E 200.23'
(N76°28'E 200.17')


Plat of Survey

of

Lot 4 of Certified Survey Map No. 204,
recorded in Vol. 1 of Certified Survey Maps of Walworth
County on Page 204 and located in the Northeast 1/4
of Section 11, Town 3 North, Range 16 East, Town of
Sugar Creek, Walworth County, Wisconsin.

Surveyed for: **Russ Treiterer**
N6814 Avataia Trail
Elkhorn, Wisconsin. 53121

Lot 6
Block 7
Lake
Wandawega
Highlands

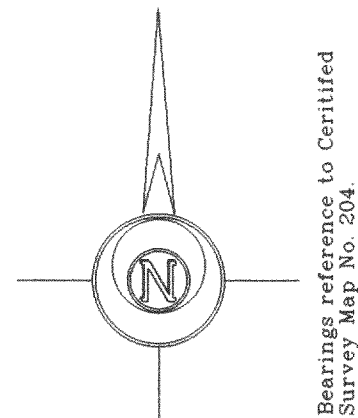


Lot 3
C.S.M. 204

Lot 4
1.363 Acres
59,368 Sq.Ft.

Septic
Vent

N12°00'56"W 341.37'
(N12°04'W 341.80')

S2°48'02"E 357.42'
(S2°50'00"E 357.57')

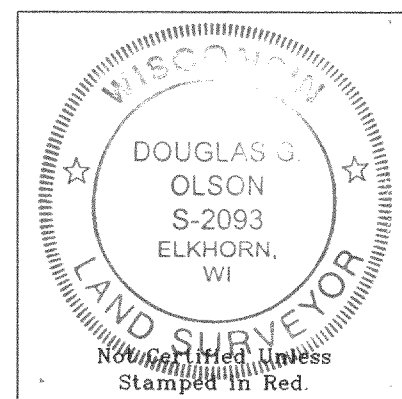

- Notes: 1) This survey plat is not certified unless signed and sealed in red ink.
- 2) This survey is subject to Wisconsin lien laws. This Plat of Survey is the notice of intent to file lien. Lien waiver required.

Copyright © 2005, Jensen & Olson Land Surveying, LLC.

All rights reserved. No part of this survey plat may be reproduced or transmitted in any form by any means - graphic, electronic, or mechanical, including photocopying, tracing, or information storage and retrieval systems - without permission in writing from Douglas G. Olson, Jensen & Olson Land Surveying, LLC.

I, Douglas G. Olson, Wisconsin Registered Land Surveyor, do hereby certify that this survey was performed by me or under my direction in full compliance with the owner's / agent's instructions and Chapter A-E 7 of the Wisconsin Administrative Code "Minimum Standards for Property Surveys"; and that this map is an accurate representation thereof to the best of my knowledge and belief.

Douglas G. Olson
Wisconsin Registered Land Surveyor - 2093

Akwenasa Trail (40' Wide)

Avataia Trail
(40' Wide)

2005.128

Sheet 1 of 1 Sheets

Job Reference Number

2005.128

Legend

- Found Concrete Monument
- Found Iron Pipe
- Found Iron Rod
- Recorded Information
- Utility Pedestal
- Asphalt Surface
- Gravel Surface




Jensen & Olson Land Surveying, LLC

45 South Wisconsin Street P.O. Box 322
Elkhorn, Wisconsin. 53121
Telephone (262) 723-3434
Facsimile (262) 723-8044

Scale in Feet

1" = 20'

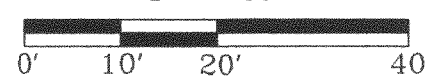

Survey Date: Sept. 15, 2005.

Revisions: No. 1 - Garage Addition

GA 20400004

310-1784