




SCALE 1" = 30'
O = IRON PIPE

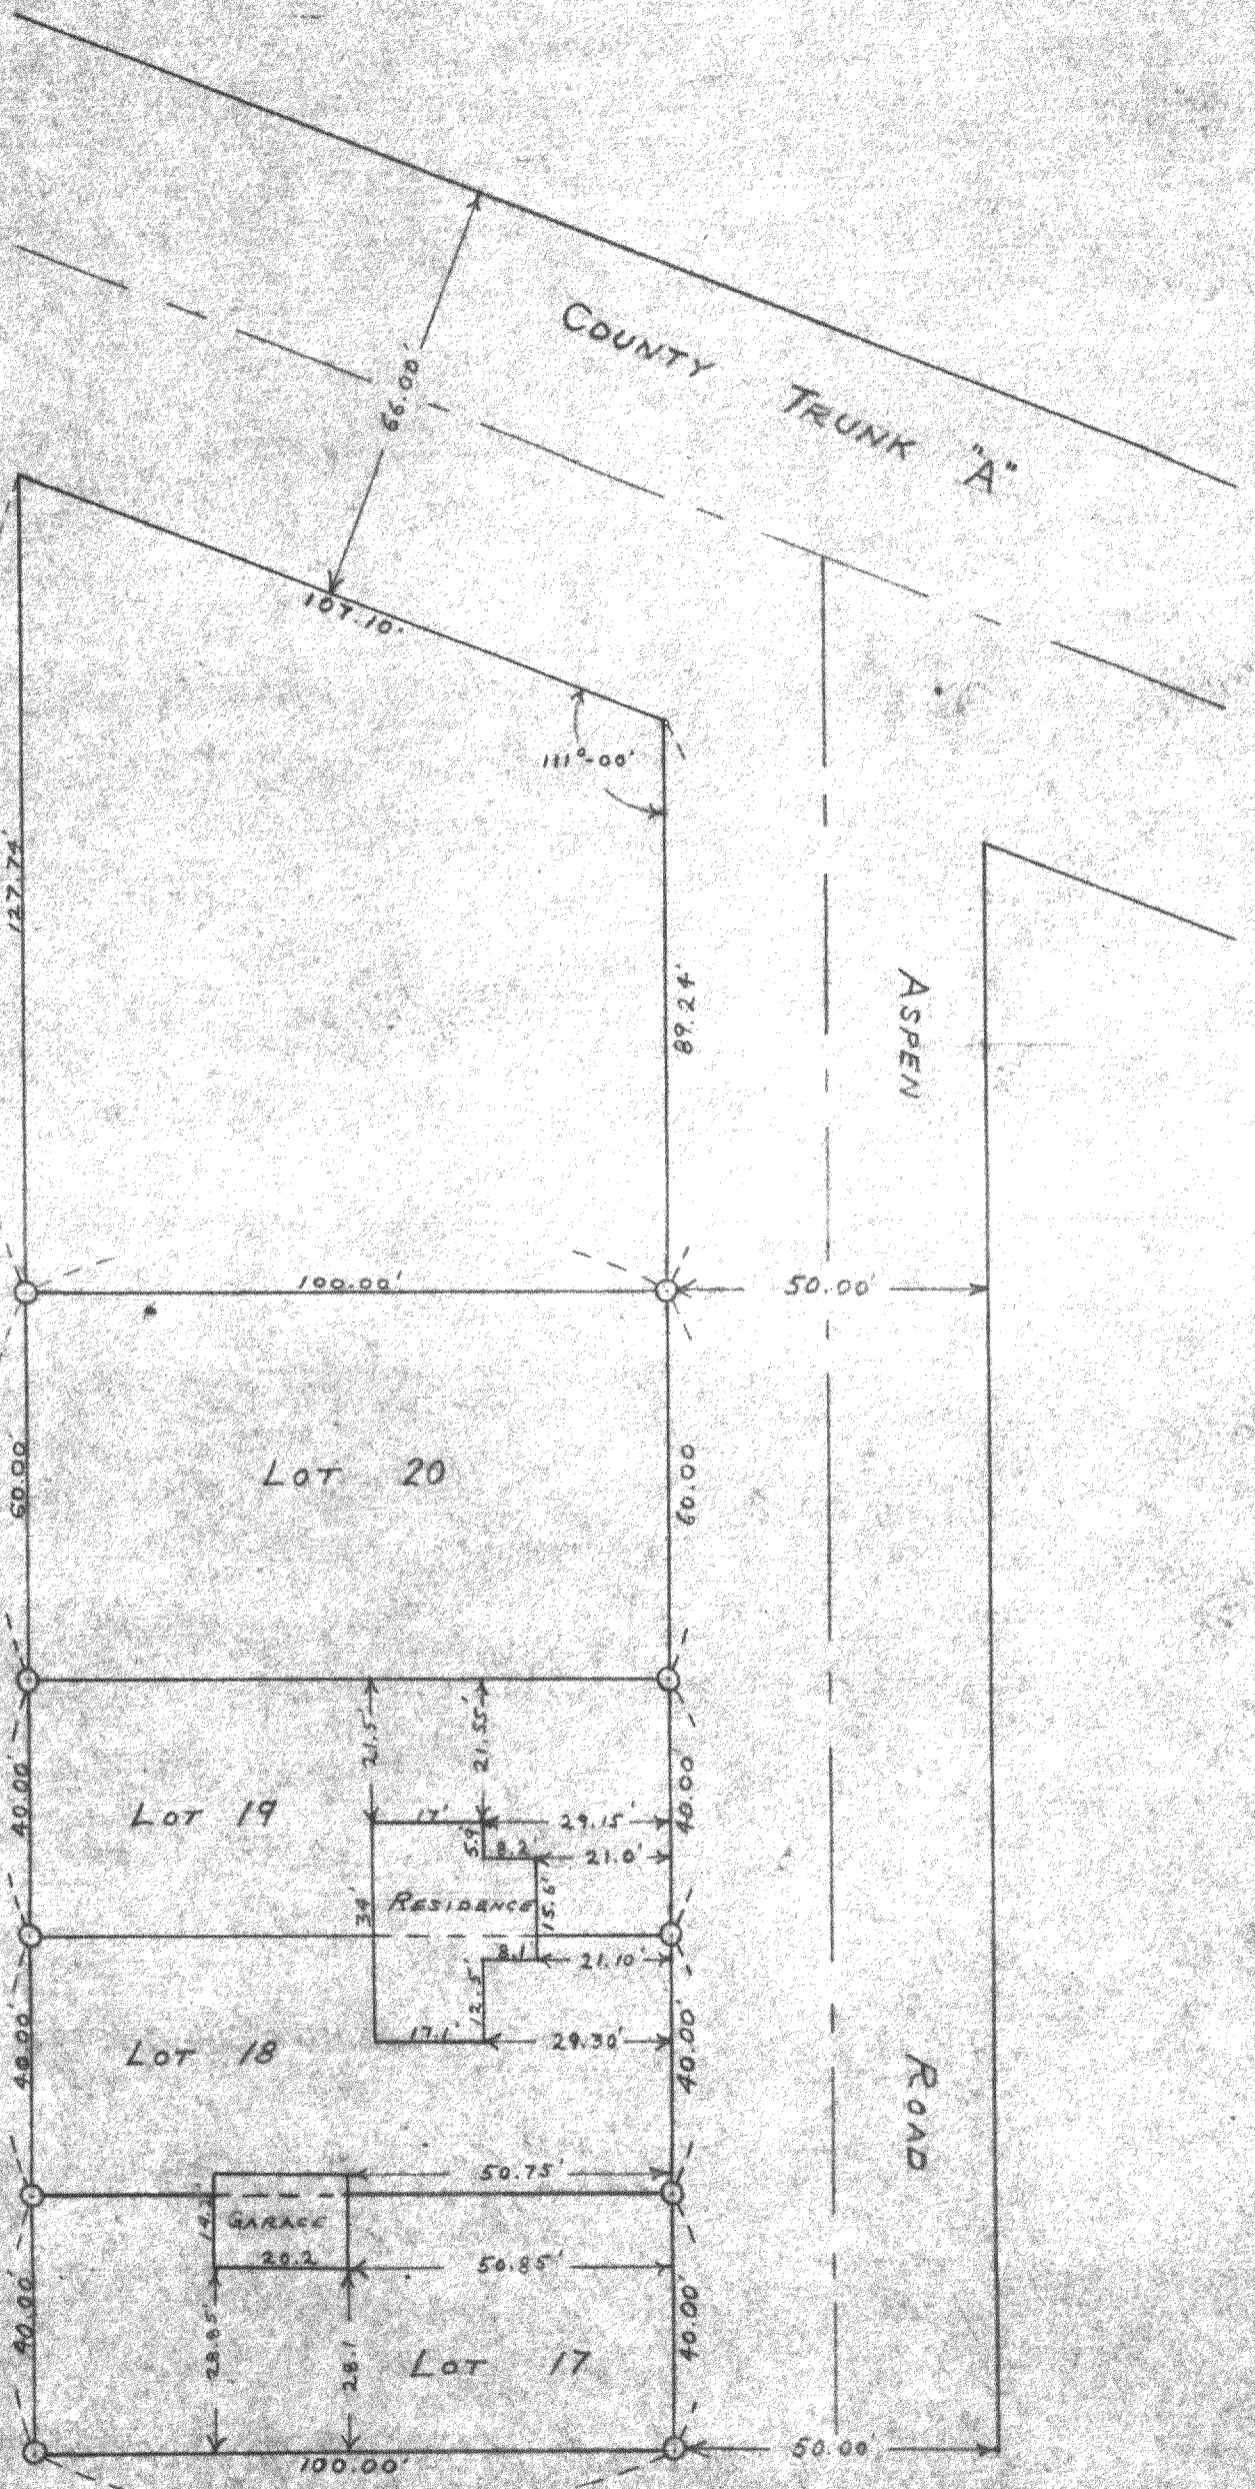

PLAT OF SURVEY OF LOTS 17, 18, 19
AND 20 BLOCK 1 INTERLAKEN WALWORTH
COUNTY, WISCONSIN
JULY 22, 1951

Lloyd R Jensen
COUNTY SURVEYOR 316-1801

G1-145
11-146
G1-2B, ac