




PREPARED FOR:
 DENISE FREUND
 PREMIER REAL ESTATE
 W9390 STATE RD. 59
 WHITEWATER, WI 53190

J.K. SURVEYING INC.
 N3705 WILLOWBEND LANE
 LAKE GENEVA, WI, 53147
 262-248-3697

PLAT OF SURVEY

OF

LOTS 8, 9 AND 10 OF BLOCK 27, THIRD MAP OF INTERLAKEN,
 TOWN OF SUGAR CREEK, WALWORTH COUNTY, WISCONSIN.

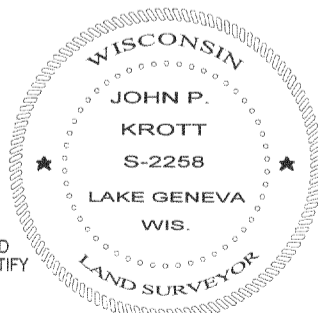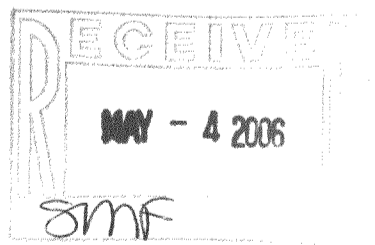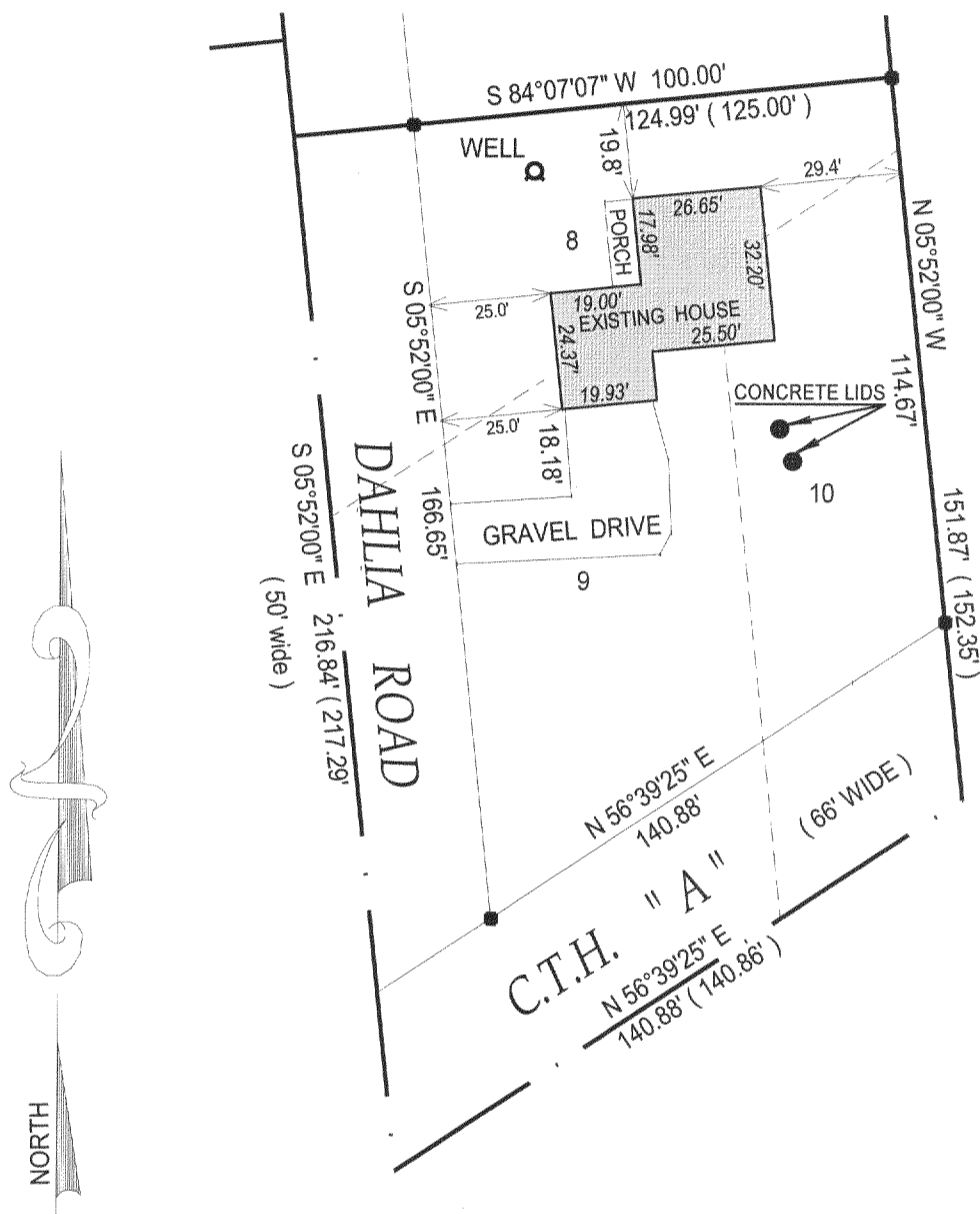

COMPARE LEGAL DESCRIPTION ABOVE AND DRAWING WITH DEED. FOR BUILDING RESTRICTIONS AND EASEMENTS NOT SHOWN, REFER TO DEED, ABSTRACT SOURCES AND LOCAL MUNICIPAL CODES. NOTIFY THE SURVEYOR IMMEDIATELY OF ANY DISCREPANCY.

- () = RECORDED AS
- = FOUND IRON BAR
- = FOUND IRON PIPE
- = SET IRON BAR
- = SET IRON PIPE

"I hereby certify that I have surveyed the above described property and that the above map, to the best of my knowledge and belief, is a true representation thereof and shows the size and location of all visible structures, apparent easements and encroachments if any."

This survey is made for the present owners of the property, and those who purchase, mortgage, or guarantee the title thereto, within one year from the date hereof.

John P. Krott

JOHN KROTT S - 2258
 Wisconsin Registered Land Surveyor
 (original if signed in red)

JOB #: 01-513AAB
 SCALE: 1" = 40'
 TAX KEY #: GI - 270

DATE OF LAST REVISION 05-03-06
 REVISED 9-13-2004 (PROPOSED)
 DATED THIS 26th DAY OF DEC., 2004

GI-270

316-1838