


PLAT OF SURVEY

- OF -
LOT 3 OF GRANVILLE ESTATES, A SUBDIVISION

MAY - 4 2006

8mf

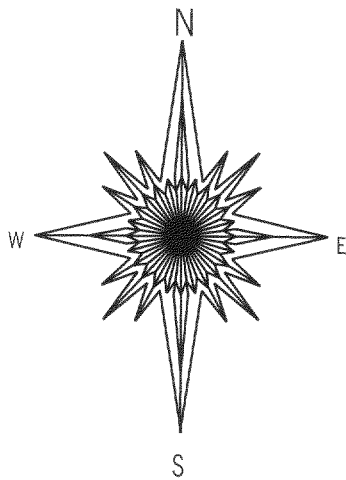

LOT 2

12' WIDE UTILITY
EASEMENT

DRAINAGE & NATURE
PRESERVATION EASEMENT

LOT 1

LOT 3

AREA= 4.57 ACRES

GRANVILLE COURT
LC=98.27.917
LCB=5.26.917
R-O-N)

GRAVEL DRIVE

ELEC.
TRANSFORMER

LOT 4

FENCE IS 11.2' WEST
OF LOT CORNER

() = recorded as

 = found iron bar

○ = found iron pipe

● = set iron pipe

■ = set iron bar

DATE OF LAST REVISION: 5/03/2006
DATE OF LAST REVISION: 2/08/2006

COMPARE LEGAL DESCRIPTION ABOVE AND DRAWING WITH DEED. FOR BUILDING RESTRICTIONS AND EASEMENTS NOT SHOWN, REFER TO DEED, ABSTRACT SOURCES AND LOCAL MUNICIPAL CODES. NOTIFY THE SURVEYOR IMMEDIATELY OF ANY DISCREPANCY.

"I hereby certify that I have surveyed the above described property and that the above map is a true representation thereof and shows the size and location of all visible structures, apparent easements and encroachments if any."


This survey is made for the present owners of the property, and those who purchase, mortgage, or guarantee the title thereto, within one year from the date hereof.

DATED THIS 27th, DAY OF APRIL, 2005

SCALE 1" = 60'

JOB # 05-184AB

TAX ID # GGR00003

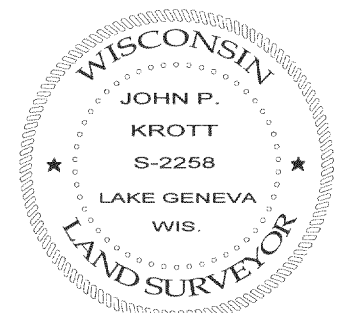

John P. Walsh

JOHN KROTT S - 2258
Wisconsin Registered Land Surveyor
(original if signed in red)

GGR-3

316-1839