

LAND-MARK SURVEYING

Mark L. Miritz



Wisconsin Registered Land Surveyor S-2582

N9330 Knuteson Drive
Whitewater, WI 53190
Phone: (262) 495-3284
FAX: (262) 495-8421
LAND-MARKSURVEYING.COM

PLAT OF SURVEY

THE NORTHWESTERLY 1/2 OF LOT 15, LOTS 16 AND 17 AND
THE SOUTHEASTERLY 1/2 OF LOT 18, ALL IN BLOCK 63, FOURTH
MAP OF INTERELAKEN, ACCORDING TO THE RECORDED PLAT THEREOF,
SAID LAND BEING IN THE TOWN OF SUGAR CREEK, COUNTY OF WALWORTH,
STATE OF WISCONSIN.

OWNER: O'NEIL BUILDERS
P.O. BOX 351
FONTANA, WI. 53125

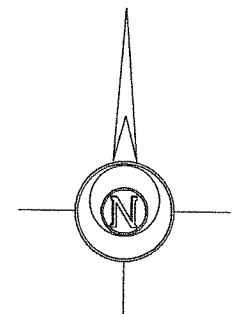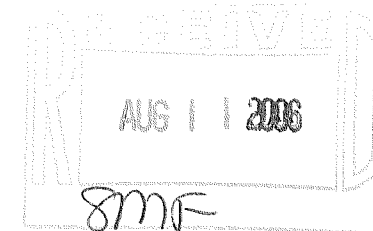

BEARINGS ARE BASED ON
PREVIOUS SURVEYS OF RECORD

LEGEND

- FOUND IRON PIPE
- FOUND IRON ROD
- FOUND COUNTY MONUMENT
- FOUND CONCRETE MONUMENT
- CHISEL CUT IN CONCRETE
- SET IRON ROD, 24" LONG, WEIGHING 1.5 LBS./LINEAL FT., 3/4" DIA.
- RECORDED AS DIMENSION
- EXISTING FENCE

SCALE: 1" = 20 FEET

"I hereby certify that the above described property has been surveyed by me or under my direction and that the above map is a true representation thereof and shows the size and location of the property, its exterior boundaries, the location of all visible structures and dimensions of all principal buildings thereon, boundary fences, apparent easements, roadways and visible encroachments, if any."
"This survey is made for the use of the present owners of the property, and also those who purchase, mortgage, or guarantee the title thereto within one year from date hereof."

MARK L. MIRITZ
WISCONSIN REGISTERED
LAND SURVEYOR S-2582

DATE: APRIL 27, 2006 JOB NO. 06.414

REVISED JULY 18, 2006 TO SHOW EXISTING FOUNDATION "AS BUILT"



DOE
PLACE
50' WIDE

WALNUT ROAD
50' WIDE

SOUTHEASTERLY 1/2 OF LOT 18
99.74' (100')

LOT 17

LOT 16
GI 00572
12,501 S.F.

NORTHWESTERLY 1/2 OF LOT 15
97.95' (100')

UTILITY PEDESTAL FALLS
ON CORNER

EXISTING
FOUNDATION

GI-572

316-1804