


FARRIS, HANSEN & ASSOCIATES, INC.

ENGINEERING – ARCHITECTURE – SURVEYING
7 RIDGWAY COURT – P.O. BOX 437 – ELKHORN, WISCONSIN 53121
PHONE: (262) 723-2098 FAX: (262) 723-5886

PLAT OF SURVEY


THE SOUTH 1/2 OF LOT 18, LOT 19, LOT 20, AND THE
NORTH 1/2 OF LOT 21 OF BLOCK 16 OF THE MAP OF INTERLAKEN
LOCATED IN PART OF THE SOUTH 1/2 OF SECTION 11,
TOWN 3 NORTH, RANGE 16 EAST,
TOWN OF SUGAR CREEK, WALWORTH COUNTY, WISCONSIN

– WORK ORDERED BY –
DAVID DENMAN
681 N. SANDY LANE, APT. 401
ELKHORN, WI 53121

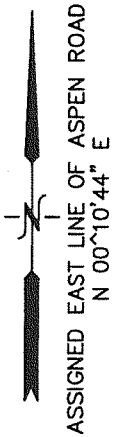

ASPEN ROAD
60' WIDE R.O.W.

EDGE OF PAVEMENT

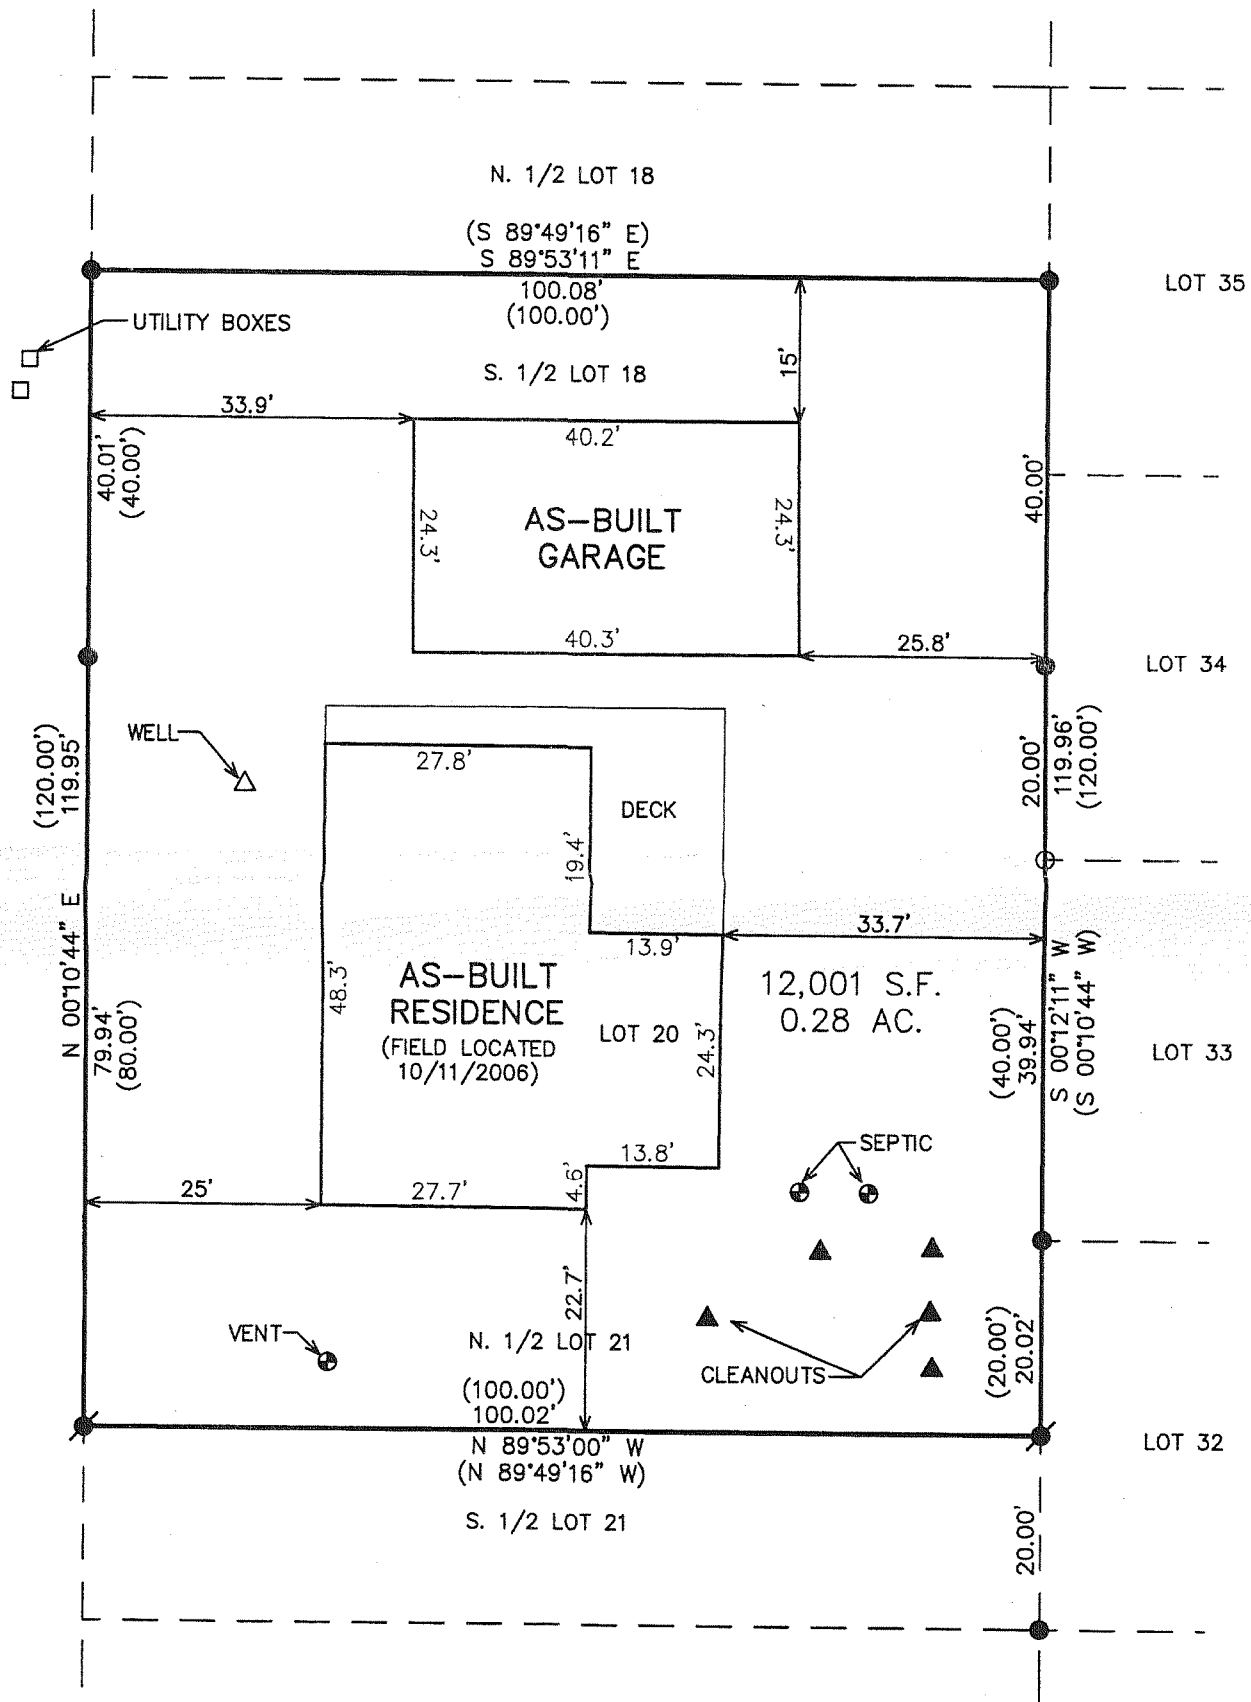

100
90
80
70
60
50
40
30
20
10
0
10 5 0
MAP SCALE IN FEET ORIGINAL 1" = 20'

NOTE: COPIES OF THIS MAP TO WHICH THE FOLLOWING CERTIFICATE
WILL APPLY SHOW THE SURVEYOR'S ORIGINAL SEAL AND SIGNATURE
IN RED INK. COPIES BY ANY OTHER MEANS MAY HAVE ALTERATIONS
WHICH DO NOT REPRESENT THE SURVEYOR'S WORK PRODUCT.

I HEREBY CERTIFY THAT THE ABOVE DESCRIBED PROPERTY HAS BEEN
SURVEYED UNDER MY DIRECTION AND THAT THE ABOVE MAP IS A TRUE
REPRESENTATION THEREOF AND SHOWS THE SIZE AND LOCATION OF
THE PROPERTY AND ITS EXTERIOR BOUNDARIES. THIS SURVEY IS
MADE FOR THE USE OF THE PRESENT OWNERS OF THE PROPERTY, AND
ALSO THOSE WHO PURCHASE, MORTGAGE, OR GUARANTEE THE TITLE
THERETO WITHIN ONE YEAR FROM THE DATE HEREOF.

DATED: SEPTEMBER 17, 2005


Peter S. Gordon
PETER S. GORDON R.L.S. 2101

REVISED 10/07/2005
TO SHOW SIZE AND LOCATED OF
REVISED PROPOSED RESIDENCE AND GARAGE
REVISED 10/12/2006
TO SHOW SIZE AND LOCATIO OF AS-BUILT
RESIDENCE AND GARAGE



LEGEND

- = SET IRON REBAR STAKE
- = FOUND IRON PIPE STAKE
- = FOUND IRON REBAR STAKE
- (XXX) = RECORDED AS

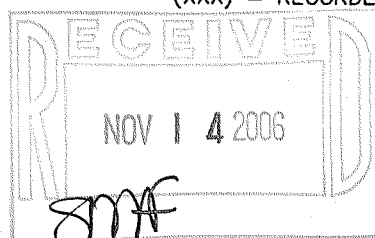

PROJECT: 6862
DATE: 09/17/2005
SHEET 1 OF 1

GI-200

316-1874