

LAND-MARK SURVEYING

Mark L. Miritz

Wisconsin Registered Land Surveyor S-2582

N9330 Knuteson Drive
Whitewater, WI 53190
Phone: (262) 495-3284
FAX: (262) 495-8421
LAND-MARKSURVEYING.COM



OWNER: KATHERINE M. EFFERTZ
N6525 ASPEN RD.
ELKHORN, WI. 53121

PLAT OF SURVEY

LOTS 19, 20, 21, AND THE NORTH 1/2
OF LOT 22 OF BLOCK 17 OF THE ORIGINAL
PLAT OF INTERLAKEN SUBDIVISION, 1ST
MAP, LOCATED IN THE SOUTHEAST 1/4 OF
SECTION 11, TOWN 3 NORTH, RANGE 16
EAST, TOWN OF SUGAR CREEK, WALWORTH
COUNTY, WISCONSIN.

ORDERED BY: WEATHER TIGHT CORP
10700-H W. VENTURE DRIVE
FRANKLIN, WI. 53132

ATTENTION: CHRIS PALITA

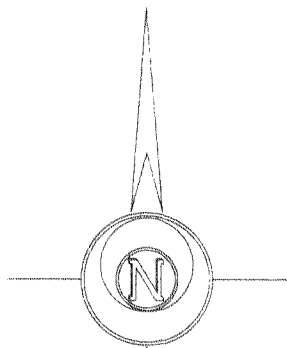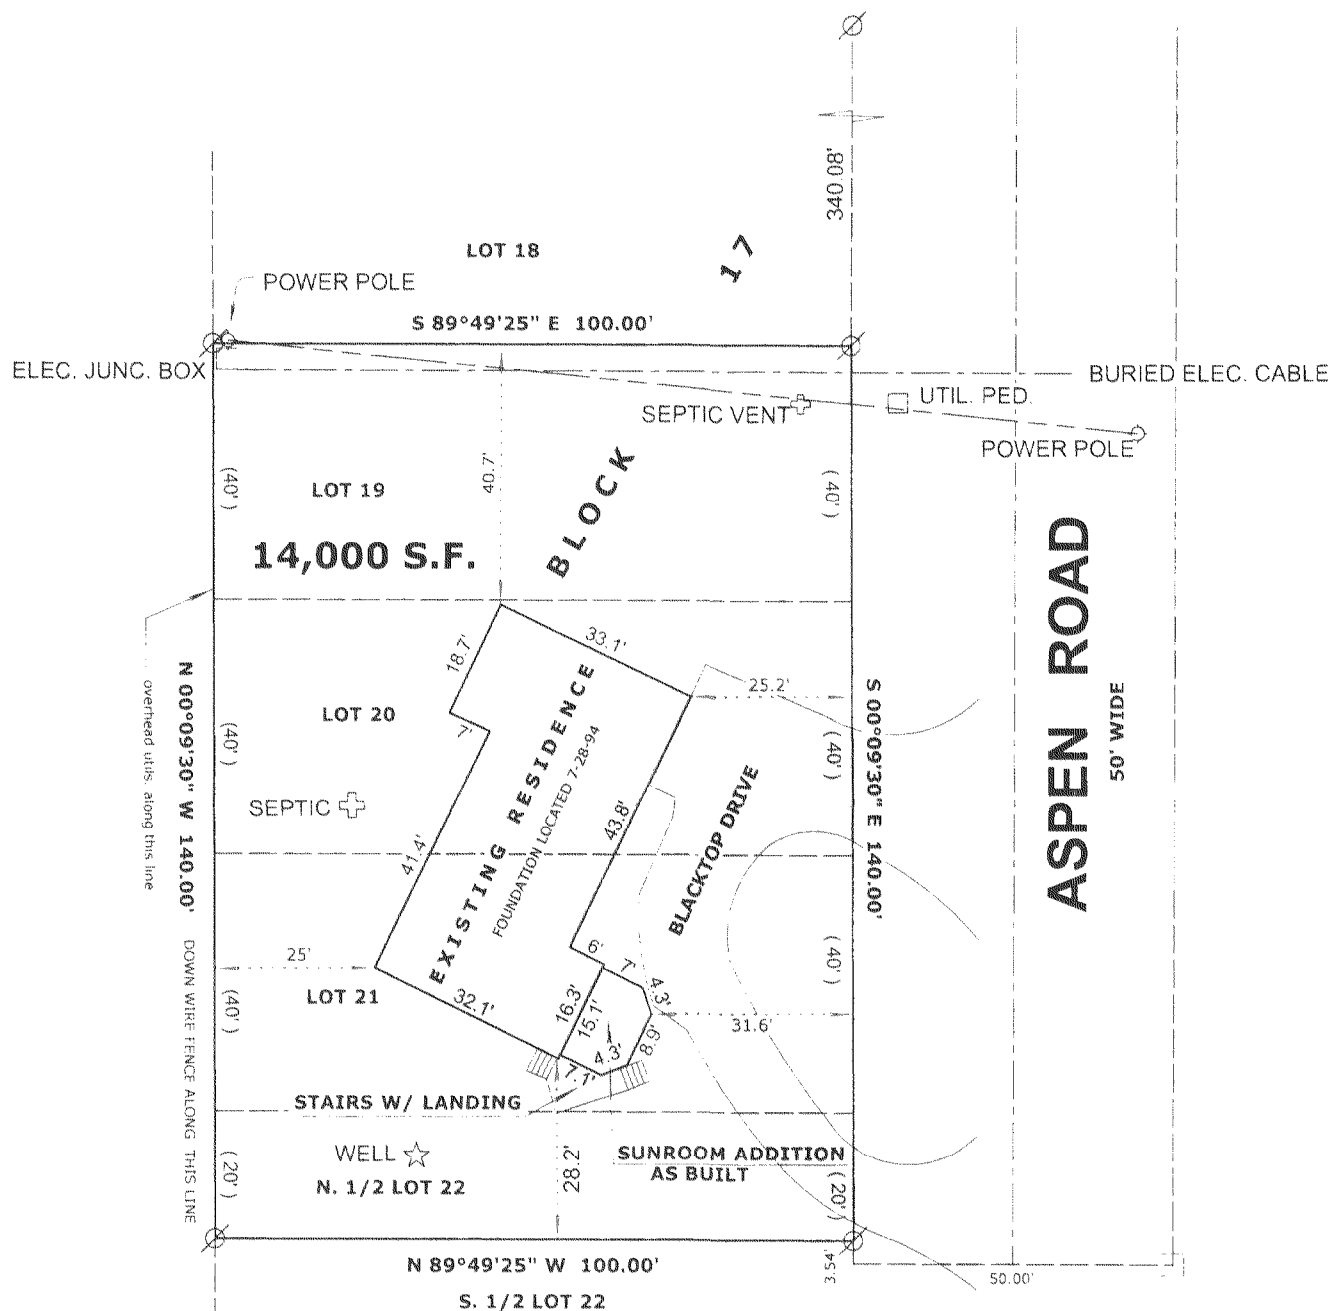

BEARINGS ARE REFERENCED TO A PREVIOUS SURVEY
BY KENNETH B. ABERNATHY JR. DATED 7/28/1994 AND
RECORDED AS SYRVEY NO. 316-740 IN WALWORTH
COUNTY SURVEYOR'S RECORDS.

LEGEND

- FOUND IRON PIPE
- FOUND IRON ROD
- FOUND COUNTY MONUMENT
- FOUND CONCRETE MONUMENT
- CHISEL CUT IN CONCRETE
- SET IRON ROD, 24" LONG, WEIGHING
1.5 LBS./LINEAL FT., 3/4" DIA.
- (x x) RECORDED AS DIMENSION
- EXISTING FENCE

NOV 29 2006

SMF

SCALE: 1" = 30 FEET

"I hereby certify that the above described property has
been surveyed by me or under my direction and that the
above map is a true representation thereof and shows the
size and location of the property, its exterior boundaries,
the location of all visible structures and dimensions of all
principal buildings thereon, boundary fences, apparent
easements, roadways and visible encroachments, if any."
"This survey is made for the use of the present owners of
the property, and also those who purchase, mortgage, or
guarantee the title thereto within one year from date
hereof."

MARK L. MIRITZ
WISCONSIN REGISTERED
LAND SURVEYOR S-2582

DATE: OCT. 21, 2006 JOB NO. 06.1007

GI-237

316-1882