

PLAT OF SURVEY

ERSV
ENGINEERING, INC.

Engineers • Land Surveyors • Environmental Scientists
801 MAIN STREET MUKWONAGO, WISCONSIN 53149 (262) 363-2004


FOR: TODD Mc CORMICK

DATE 4/22/06-RECERTIFICATION
DATE: 5/30/02

DESCRIPTION: LOTS 18 THROUGH 22 OF BLOCK 9 OF INTERLAKEN SUBDIVISION
LOCATED IN THE TOWN OF SUGAR CREEK, WALWORTH COUNTY, WISCONSIN.


LEGEND

| | |
|----------------|--------------------------|
| 1" IP • 1/2" R | FOUND IRON PIPE OR REBAR |
| — EOP | EDGE OF PAVEMENT |
| ⊙ | SEPTIC TANK |
| ⊙ | SEPTIC VENT |
| ⊠ | CLEAN OUT |

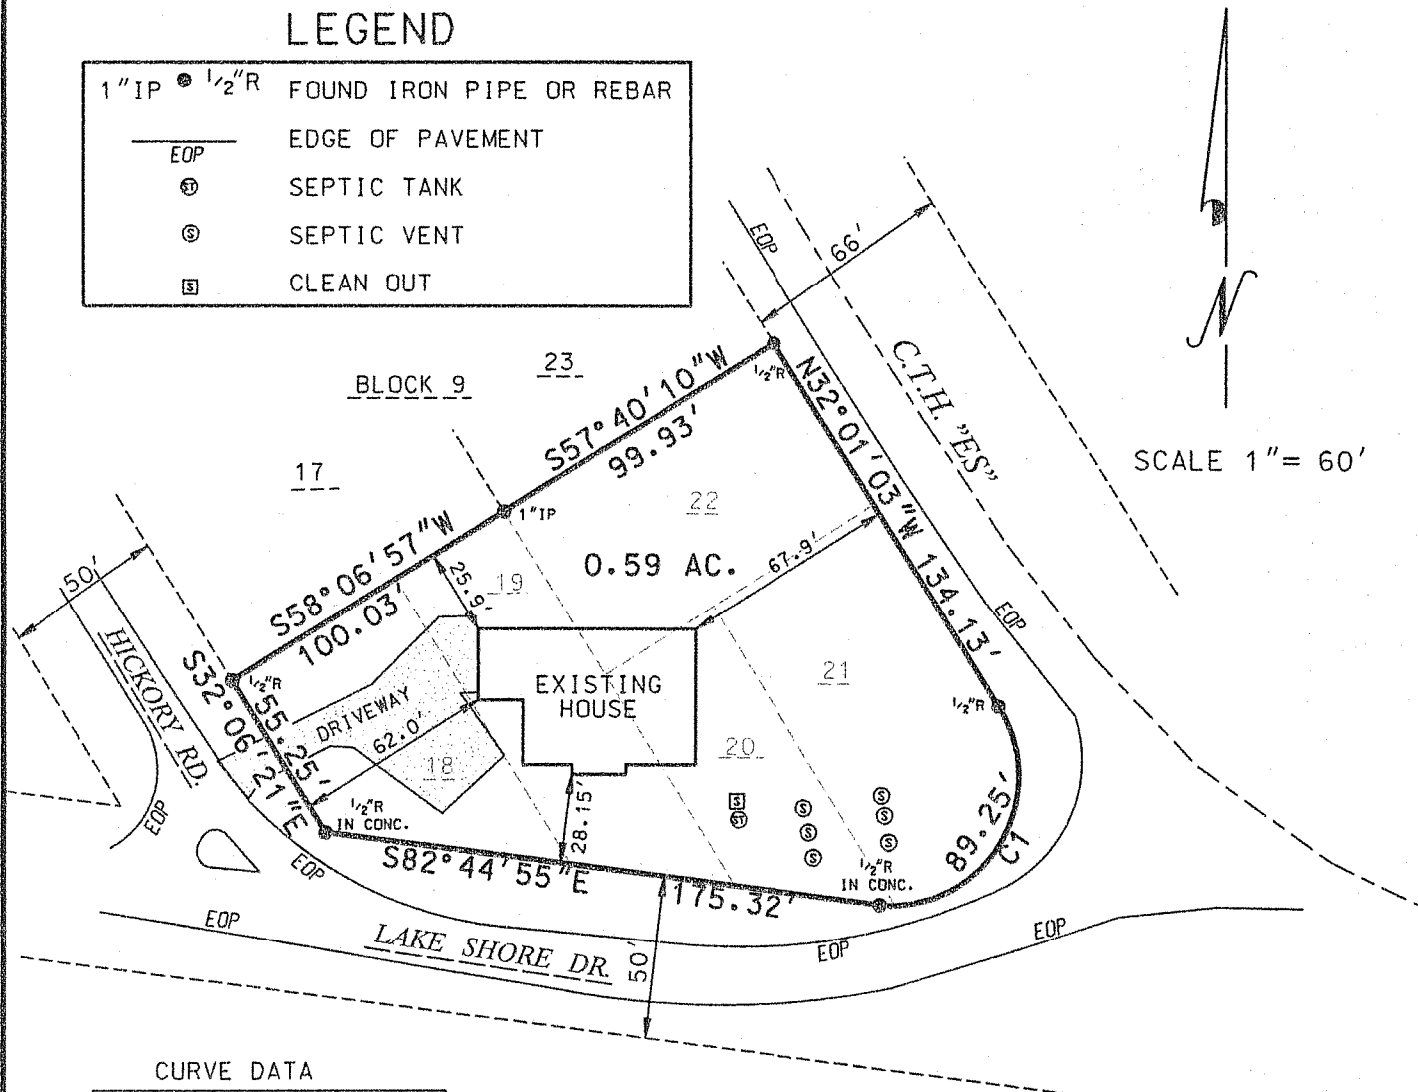

CURVE DATA

| | |
|---------|-------------|
| ARC | 89.25' |
| DELTA | 127°50'52" |
| RADIUS | 40.00' |
| CHORD | 71.86' |
| BEARING | N31°10'43"E |

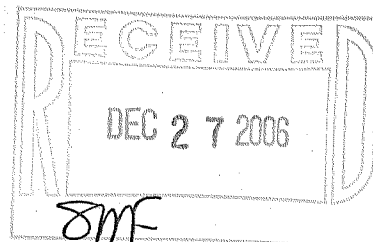

THE ABOVE MAP IS A TRUE REPRESENTATION THEREOF AND SHOWS THE SIZE AND LOCATION OF ALL THE PROPERTY, EXTERIOR BOUNDARIES, THE LOCATION OF ALL VISIBLE BOUNDARY FENCES, APPARENT EASEMENTS, ROADWAYS AND VISIBLE ENCROACHMENTS, IF ANY.

THIS SURVEY IS MADE FOR THE USE OF THE PRESENT OWNERS OF THE PROPERTY, AND ALSO THOSE WHO PURCHASE, MORTGAGE OR GUARANTEE TITLE THERETO WITHIN ONE (1) YEAR FROM DATE HERETO.

Michael A. Greeson

MICHAEL A. GREESON, R.L.S. 2770
RSV DATA6/BRADTDS/02189RECERT.DGN

