

# PLAT OF SURVEY

**ERSV**  
ENGINEERING, INC.

Engineers • Land Surveyors • Environmental Scientists  
801 MAIN STREET MILWAUKEE, WISCONSIN 53149 (262) 363-2004


FOR: TODD Mc CORMICK

DATE 4/22/06-RECERTIFICATION  
DATE: 5/30/02

DESCRIPTION: LOTS 18 THROUGH 22 OF BLOCK 9 OF INTERLAKEN SUBDIVISION  
LOCATED IN THE TOWN OF SUGAR CREEK, WALWORTH COUNTY, WISCONSIN.


## LEGEND

|              |                          |
|--------------|--------------------------|
| 1"IP • 1/2"R | FOUND IRON PIPE OR REBAR |
| — EOP —      | EDGE OF PAVEMENT         |
| ⊙            | SEPTIC TANK              |
| ⊙            | SEPTIC VENT              |
| □            | CLEAN OUT                |

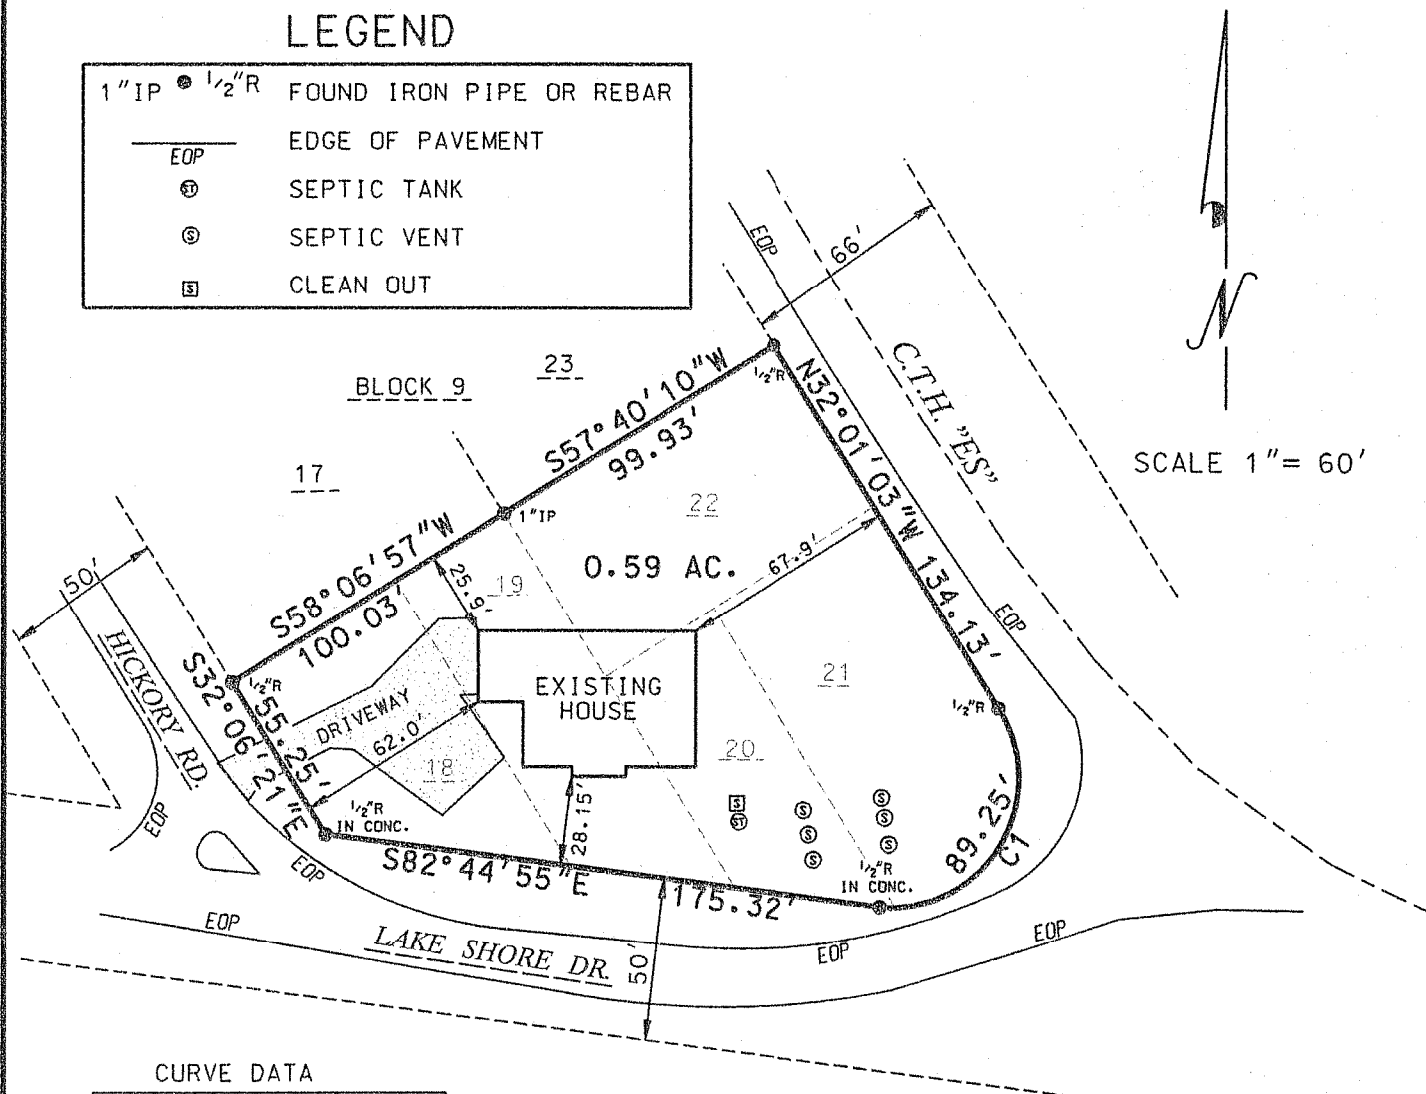

## CURVE DATA

|         |             |
|---------|-------------|
| ARC     | 89.25'      |
| DELTA   | 127°50'52"  |
| RADIUS  | 40.00'      |
| CHORD   | 71.86'      |
| BEARING | N31°10'43"E |

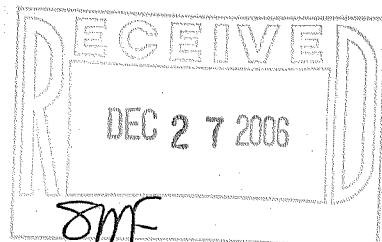


THE ABOVE MAP IS A TRUE REPRESENTATION THEREOF AND  
SHOWS THE SIZE AND LOCATION OF ALL THE PROPERTY,  
EXTERIOR BOUNDARIES, THE LOCATION OF ALL VISIBLE  
BOUNDARY FENCES, APPARENT EASEMENTS, ROADWAYS  
AND VISIBLE ENCROACHMENTS, IF ANY.

THIS SURVEY IS MADE FOR THE USE OF THE PRESENT  
OWNERS OF THE PROPERTY, AND ALSO THOSE WHO  
PURCHASE, MORTGAGE OR GUARANTEE TITLE THERETO  
WITHIN ONE (1) YEAR FROM DATE HERETO.

*Michael A. Greeson*

MICHAEL A. GREESON, R.L.S. 2770  
RSV DATA6/BRADTDS/02189RECERT.DGN

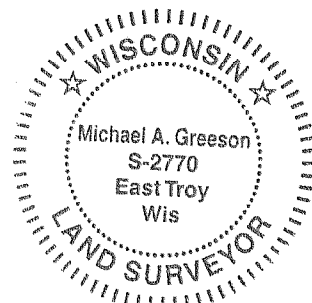

316-1897