
LAND-MARK SURVEYING Mark L. Miritz

Wisconsin Registered Land Surveyor S-2582


N9330 Knuteson Drive Whitewater, WI 53190 Phone:(262)495-3284 FAX: (262) 495-8421 LAND-MARKSURVEYING.COM

PLAT OF SURVEY

LOTS 31 AND 32 OF BLOCK 7 OF LAKE WANDAWEGA **HIGHLANDS SUBDIVISION, LOCATED IN SECTION 11** AND 12, TOWN 3 NORTH, RANGE 16 EAST, WALWORTH COUNTY, WISCONSIN.

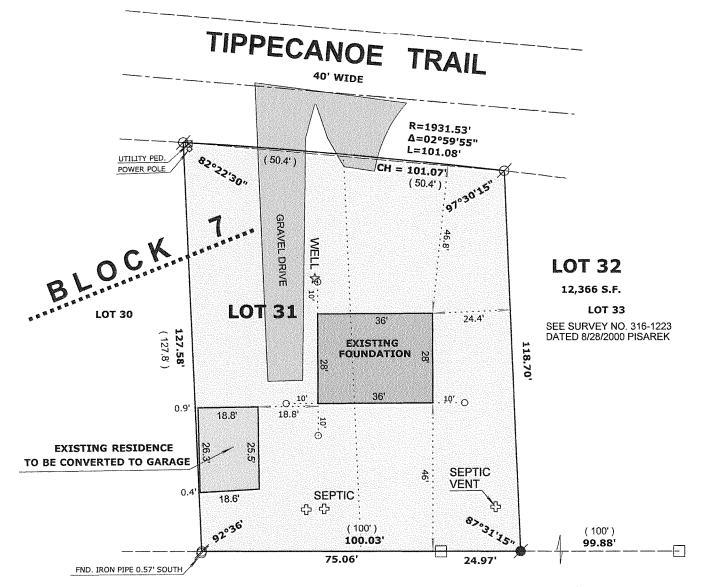

OWNER: JESSIE L. GUSTAFSON W5239 TIPPECANOE TR. ELKHORN, WI. 53121

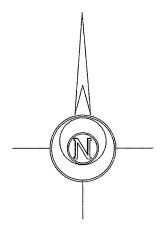





LEGEND

FOUND IRON PIPE

FOUND IRON ROD UTILITY PEDESTAL

FOUND CONCRETE MONUMENT

CHISEL CUT IN CONCRETE

SET IRON ROD, 24" LONG, WEIGHING 1.5 LBS./LINEAL FT., 3/4" DIA.

RECORDED AS DIMENSION

EXISTING FENCE

"I hereby certify that the above described property has been surveyed by me or under my direction and that the above map is a true representation thereof and shows the size and location of the property, its exterior boundaries, the location of all visible structures and dimensions of all principal buildings thereon, boundary fences, apparent easements, roadways and visible encroachments, if any,

"This survey is made for the use of the present owners of the property, and also those who purchase, mortgage, or guarantee the title thereto within one year from date

MARK L. MIRITZ

WISCONSIN REGISTERED LAND SURVEYOR S-2582

REVISED NOV. 14, 2006 TO SHOW FOUNDATION "AS BUILT"

REVISED SEPT. 22, 2006 TO SHOW PROPOSED RESIDENCE MOVED NORTHERLY DATE: AUG. 31, 2006 JOB NO. 06.817