


202 West Street Johnson Creek, WI 53038 (920) 699-3305

A B C D E F G

FOR LOTS 22, 23 AND 24, BLOCK 55, IN THE FOURTH MAP OF INTERLAKEN, BEING PART
OF THE NW 1/4 OF THE SOUTHWEST QUARTER OF SECTION 11, TOWN 3 NORTH,
RANGE 16 EAST, TOWN OF SUGAR CREEK, WALWORTH COUNTY, WISCONSIN.

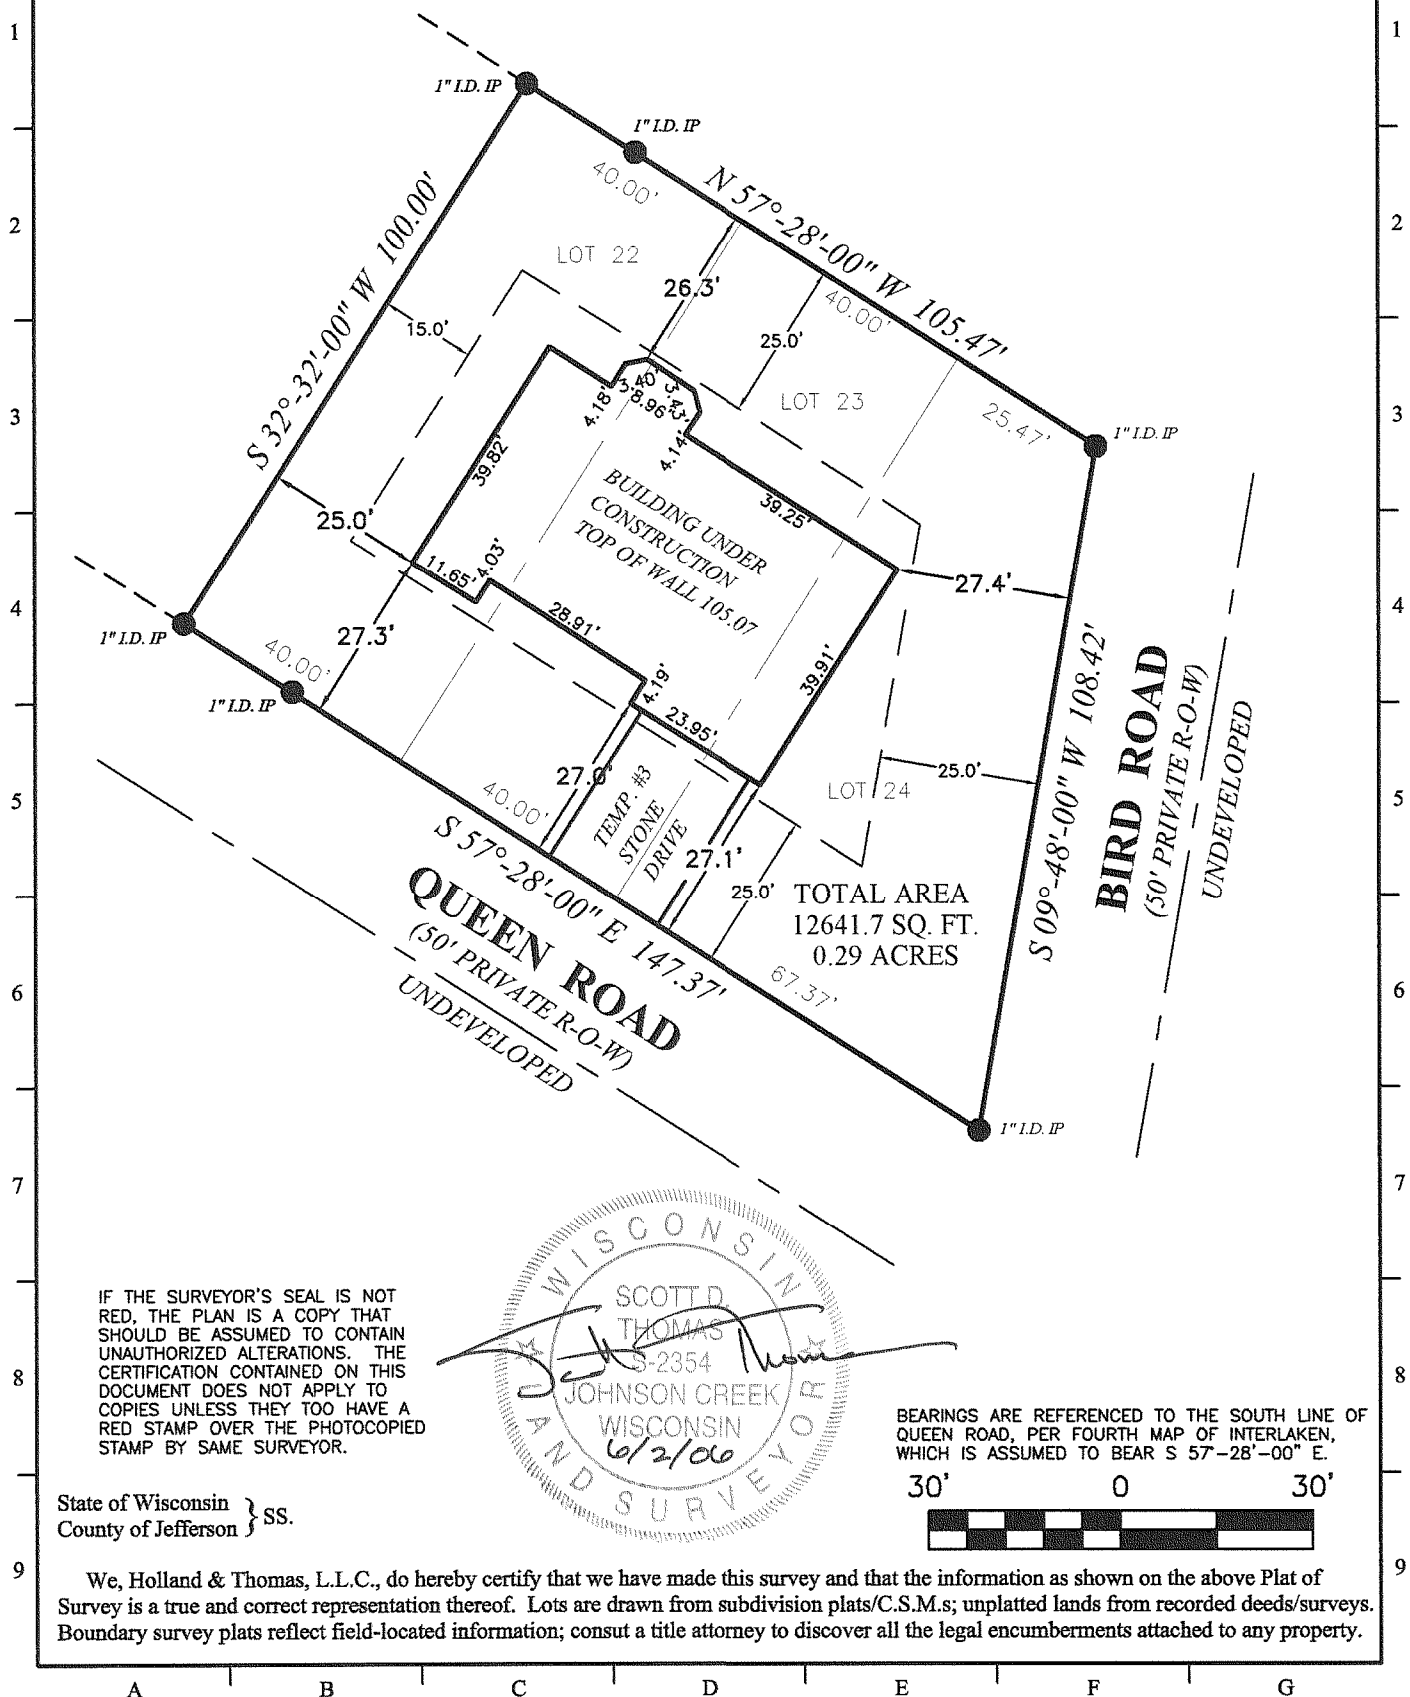

State of Wisconsin }
County of Jefferson } ss.


We, Holland & Thomas, L.L.C., do hereby certify that we have made this survey and that the information as shown on the above Plat of Survey is a true and correct representation thereof. Lots are drawn from subdivision plats/C.S.M.s; unplatted lands from recorded deeds/surveys. Boundary survey plats reflect field-located information; consult a title attorney to discover all the legal encumbrments attached to any property.

LEGEND: These standard symbols may be found in the drawing.

- Lot Corner (Found) w/Desc. _____ . _____ Easement Boundary
 _____ _____ Setback Line

OWNER: BERELC

BUILDER: KAEREK HOMES, INC.
11600 LINCOLN AVE.
WEST ALLIS, WI 53227
PH: (414) 321-5300
FAX: (414) 321-8622

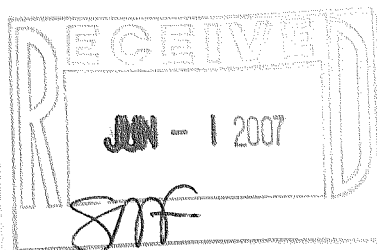

GI-497

316-1911