
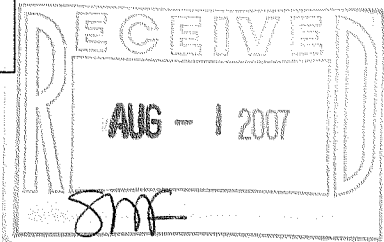
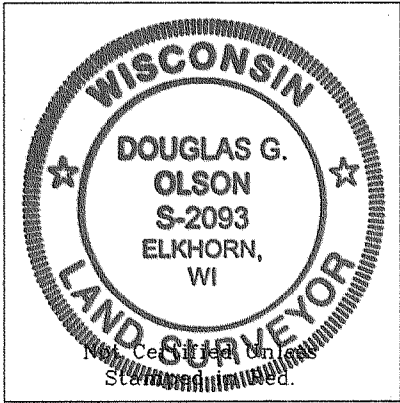


# Plat of Survey

of  
Lots 7 through 9, all in Block 3 of Interlaken,  
a subdivision located in the Southwest 1/4 of Section 11,  
Town 3 North, Range 16 East, Town of Sugar Creek,  
Walworth County, Wisconsin.

Surveyed for: **Victor Young**  
N6612 Birch Road  
Elkhorn, Wisconsin. 53121

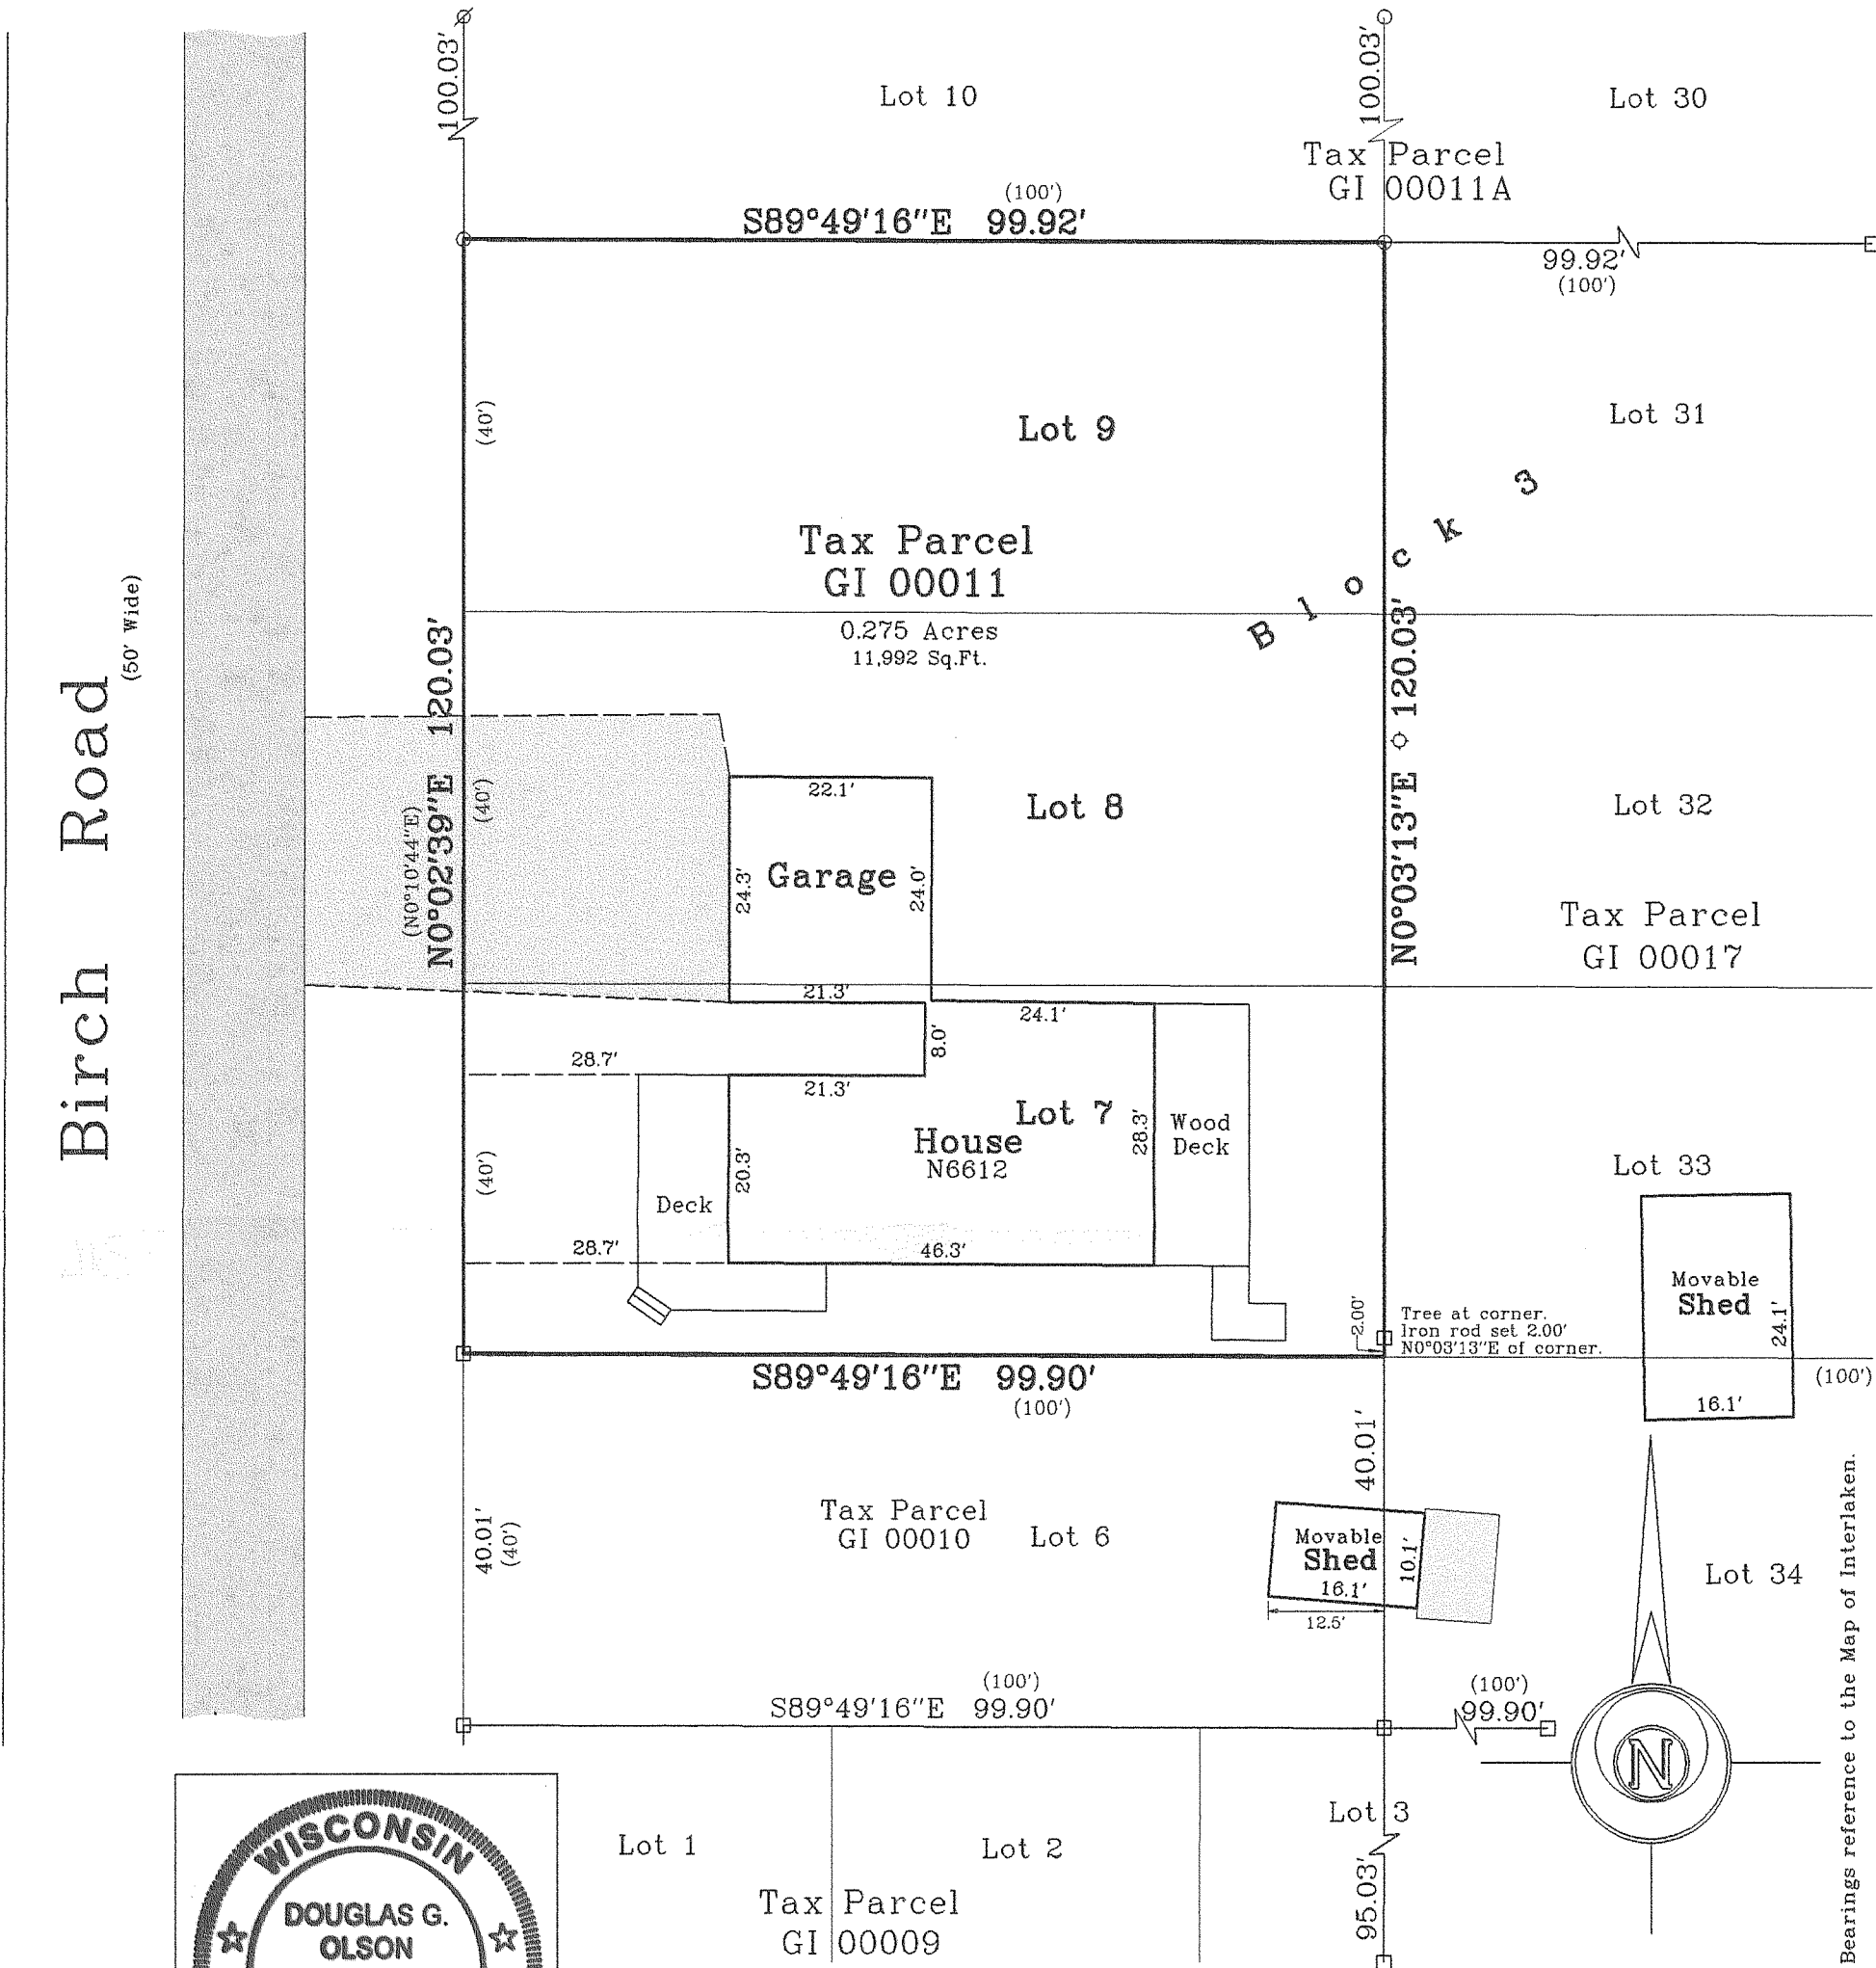

- Notes:
- 1) This survey plat is not certified unless signed and sealed in red ink.
  - 2) This survey is subject to Wisconsin lien laws. This Plat of Survey is the notice of intent to file lien. Lien waiver required.

Copyright © 2007 by Jensen & Olson Land Surveying, LLC.

All rights reserved. No part of this survey plat may be reproduced or transmitted in any form by any means - graphic, electronic, or mechanical, including photocopying, tracing, or information storage and retrieval systems - without permission in writing from Douglas G. Olson, Jensen & Olson Land Surveying, LLC.

I hereby certify that I have surveyed the above described property and the map hereon is correct to the best of my professional knowledge and belief and shows the size and location of the property, its exterior boundaries, the location and dimensions of all visible structures thereon, boundary fences, apparent easements and roadways and visible encroachments, if any.

This survey is made for the exclusive use of the present owners of property, and also those who purchase, mortgage or guarantee title thereto, within one year from the date hereof.

Douglas G. Olson  
Wisconsin Registered Land Surveyor - 2093

## Legend

- Found Concrete Monument
- Found Iron Pipe
- Found Iron Rod, 1 3/16" dia.
- Found Iron Rod, 3/4" dia.
- ( ) Recorded Information
- Utility Pole
- Asphalt Surface
- Gravel Surface
- Concrete Surface
- Set Iron Rod, 3/4" dia.
- Septic Vent

## Jensen & Olson Land Surveying, LLC

45 South Wisconsin Street P.O. Box 322  
Elkhorn, Wisconsin. 53121  
Telephone: (262) 723-3434  
Facsimile: (262) 723-8044

Scale: 1" = 20'



Survey date: March 16, 2007.  
Revisions:

Sheet 1 of 1 Sheets.

Job Reference Number:

2006.132

GI-11

316-1934