

**LAND-MARK SURVEYING**

Mark L. Miritz



Wisconsin Registered Land Surveyor S-2582

N9330 Knuteson Drive  
Whitewater, WI 53190  
Phone: (262) 495-3284  
FAX : (262) 495-8421  
LAND-MARKSURVEYING.COM

**PLAT OF SURVEY**

**LOT 1, 2 AND THE WEST 1/2 OF LOT 3, ALL IN BLOCK 3  
OF INTERLAKEN, A SUBDIVISION LOCATED IN THE SOUTHWEST  
1/4 OF SECTION 11, TOWN 3 NORTH, RANGE 16 EAST, TOWN OF  
SUGAR CREEK, WALWORTH COUNTY, WISCONSIN**


OWNER: JOHN O'NEILL  
P.O. BOX 351  
FONTANA, WI. 53125

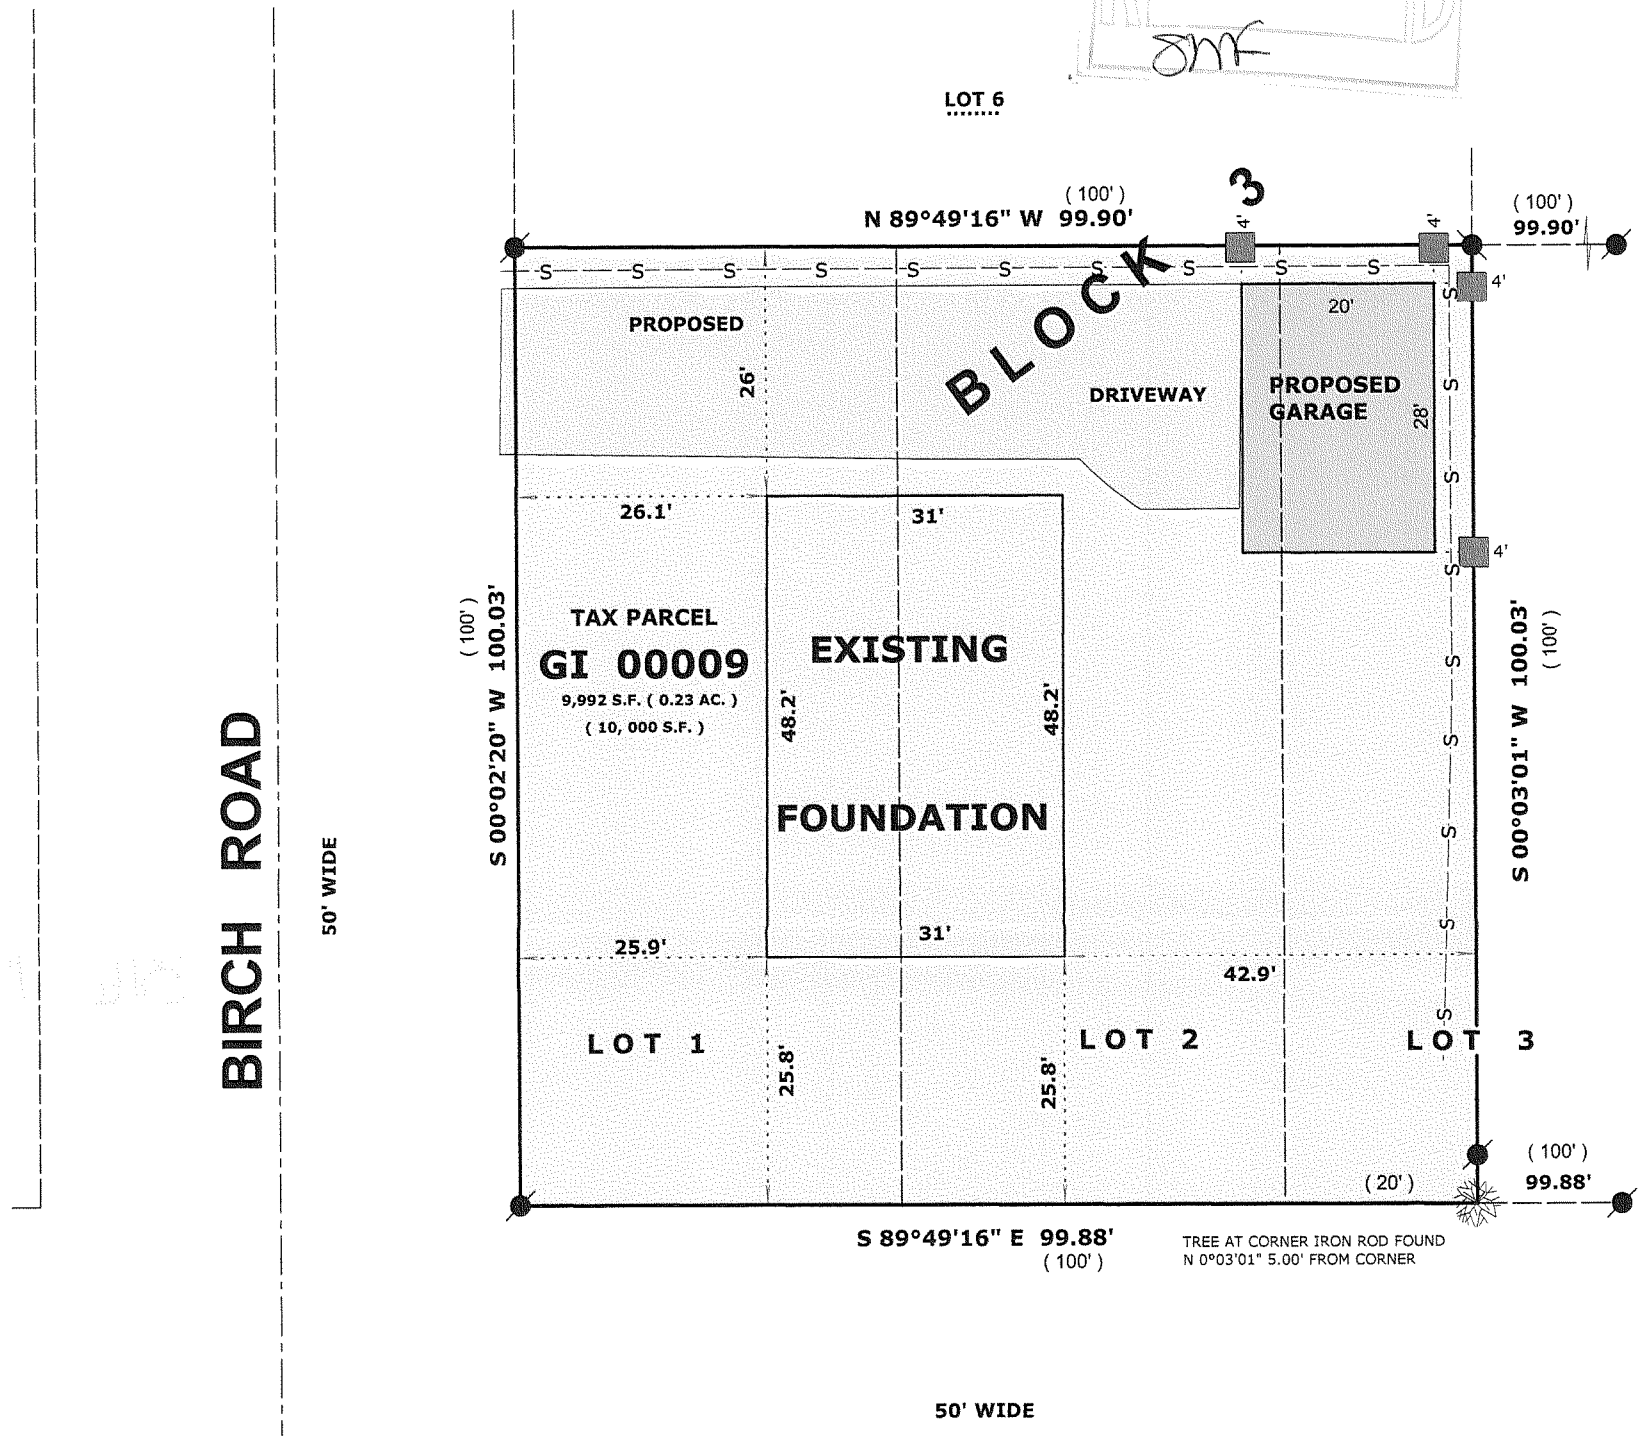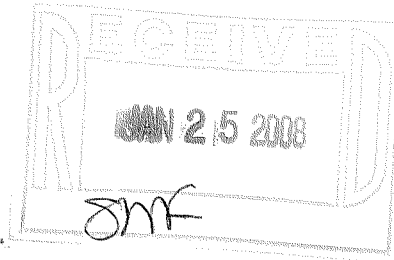


**LEGEND**

- FOUND IRON PIPE
- FOUND IRON ROD
- WOOD STAKE SET AT 10' OFFSET
- SET IRON ROD, 24" LONG, WEIGHING 1.5 LBS./LINEAL FT., 3/4" DIA.
- RECORDED AS DIMENSION
- PROPOSED SILT FENCE

BEARINGS ASSUMED TO MATCH  
PREVIOUS SURVEYS OF RECORD

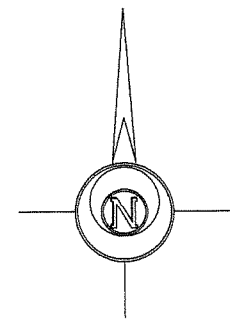

SCALE: 1" = 20 FEET

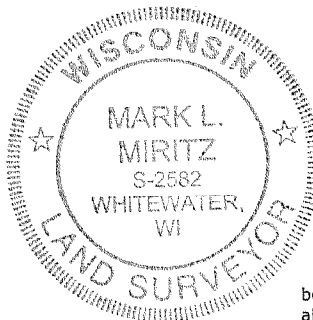

"I hereby certify that the above described property has been surveyed by me or under my direction and that the above map is a true representation thereof and shows the size and location of the property, its exterior boundaries, the location of all visible structures and dimensions of all principal buildings thereon, boundary fences, apparent easements, roadways and visible encroachments, if any."  
"This survey is made for the use of the present owners of the property, and also those who purchase, mortgage, or guarantee the title thereto within one year from date hereof."

*Mark L. Miritz*  
MARK L. MIRITZ  
WISCONSIN REGISTERED  
LAND SURVEYOR S-2582

REVISED 10/17/2007 TO MOVE PROP RESIDENCE  
REVISED 11/12/2007 TO SHOW FOUNDATION "AS BUILT"

DATE: AUG. 27, 2007 JOB NO. 07.804 (2)

GI-9

316-1958