

LAND-MARK SURVEYING
Mark L. Miritz



Wisconsin Registered Land Surveyor S-2582

N9330 Knuteson Drive
 Whitewater, WI 53190
 Phone: (262) 495-3284
 FAX : (262) 495-8421
 LAND-MARKSURVEYING.COM

PLAT OF SURVEY

**LOT 4, 5 AND THE EAST 1/2 OF LOT 3, ALL IN BLOCK 3
 OF INTERLAKEN, A SUBDIVISION LOCATED IN THE SOUTHWEST
 1/4 OF SECTION 11, TOWN 3 NORTH, RANGE 16 EAST, TOWN OF
 SUGAR CREEK, WALWORTH COUNTY, WISCONSIN**

OWNER: JOHN O'NEILL
P.O. BOX 351
FONTANA, WI. 53125

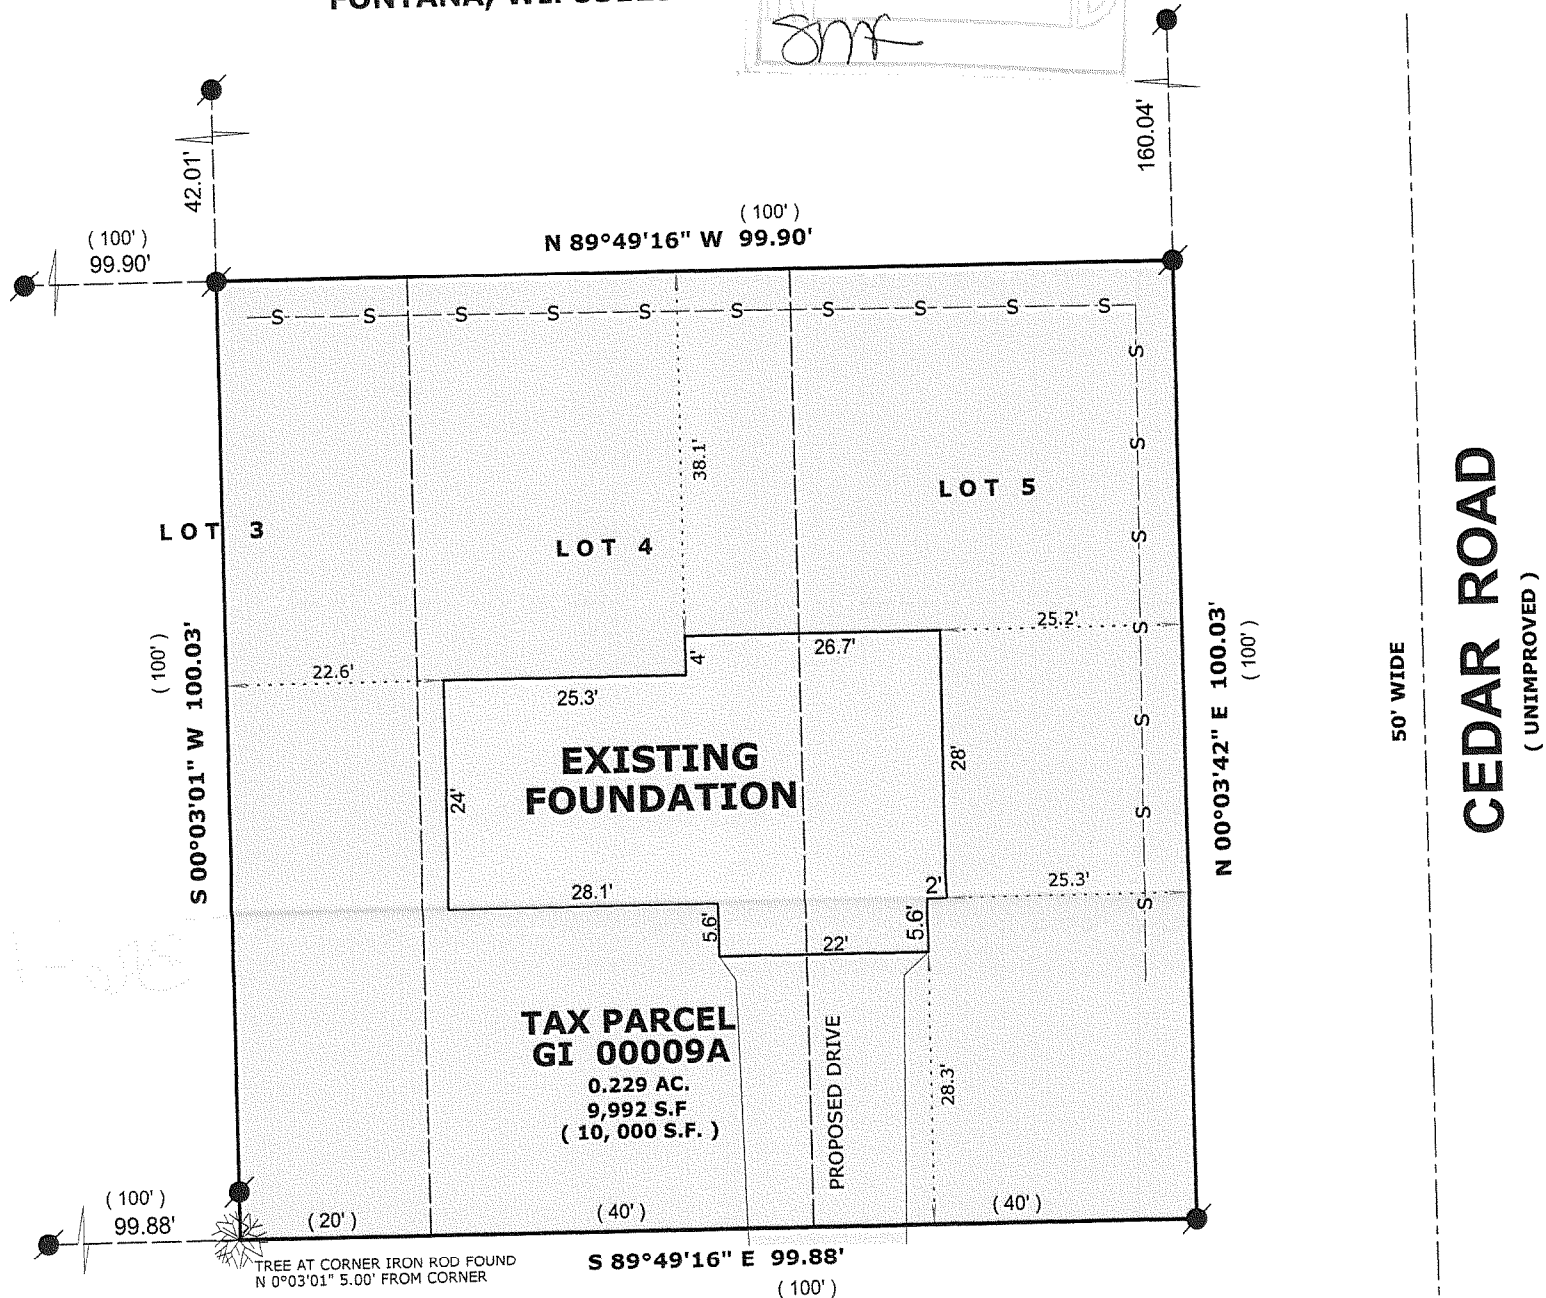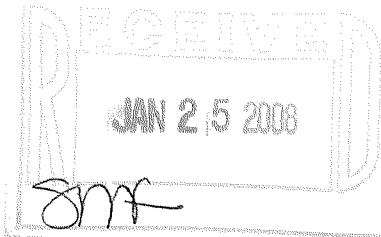


BEARINGS ASSUMED TO MATCH
 PREVIOUS SURVEYS OF RECORD

LEGEND

- FOUND IRON PIPE
- FOUND IRON ROD
- (x x) RECORDED AS DIMENSION
- S-S- PROPOSED SILT FENCE

SCALE: 1" = 20 FEET

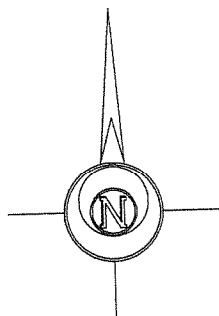

"I hereby certify that the above described property has been surveyed by me or under my direction and that the above map is a true representation thereof and shows the size and location of the property, its exterior boundaries, the location of all visible structures and dimensions of all principal buildings thereon, boundary fences, apparent easements, roadways and visible encroachments, if any."
 "This survey is made for the use of the present owners of the property, and also those who purchase, mortgage, or guarantee the title thereto within one year from date hereof."

MARK L. MIRITZ
WISCONSIN REGISTERED
LAND SURVEYOR S-2582

DATE: AUG. 26, 2007 JOB NO. 07.804

REVISED NOV. 12, 2007 TO SHOW FOUNDATION "AS BUILT"

GI-9A

316-1959