



1805-010

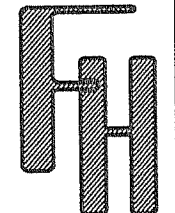

**PLAT OF SURVEY**  
BALANCE OF THE CLUB HOUSE GROUNDS  
AS LAID OUT ON THE LAKE WANDAWEGA SUBDIVISION  
PLAT AFTER STATE HIGHWAY DEDICATION,  
GOLF PARK ADDITION, & VARIOUS DOCUMENTS  
VACATING PARTS OF LAKE WANDAWEGA AND  
GOLF PARK ADDITION  
LOCATED IN THE SW 1/4 SECTION 1  
TOWN 3 NORTH, RANGE 16 EAST  
TOWN OF SUGAR CREEK  
WALWORTH COUNTY, WI.

ASSIGNED NORTH LINE WISCONSIN AVENUE  
N 85°36'40" W

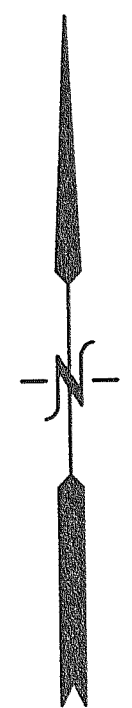

GOLF VIEW DRIVE  
30' WIDE

GOLF VIEW DRIVE  
30' WIDE


VACATED LOT 8 BLOCK 80

VACATED WALWORTH DRIVE  
18' WIDE  
S 85°34'57" E 96.83

HIGHWAY ROW AS MONUMENTED AND SURVEYED  
BY DOT

US HIGHWAY "12" & STATE TRUNK HIGHWAY "67"

CENTERLINE

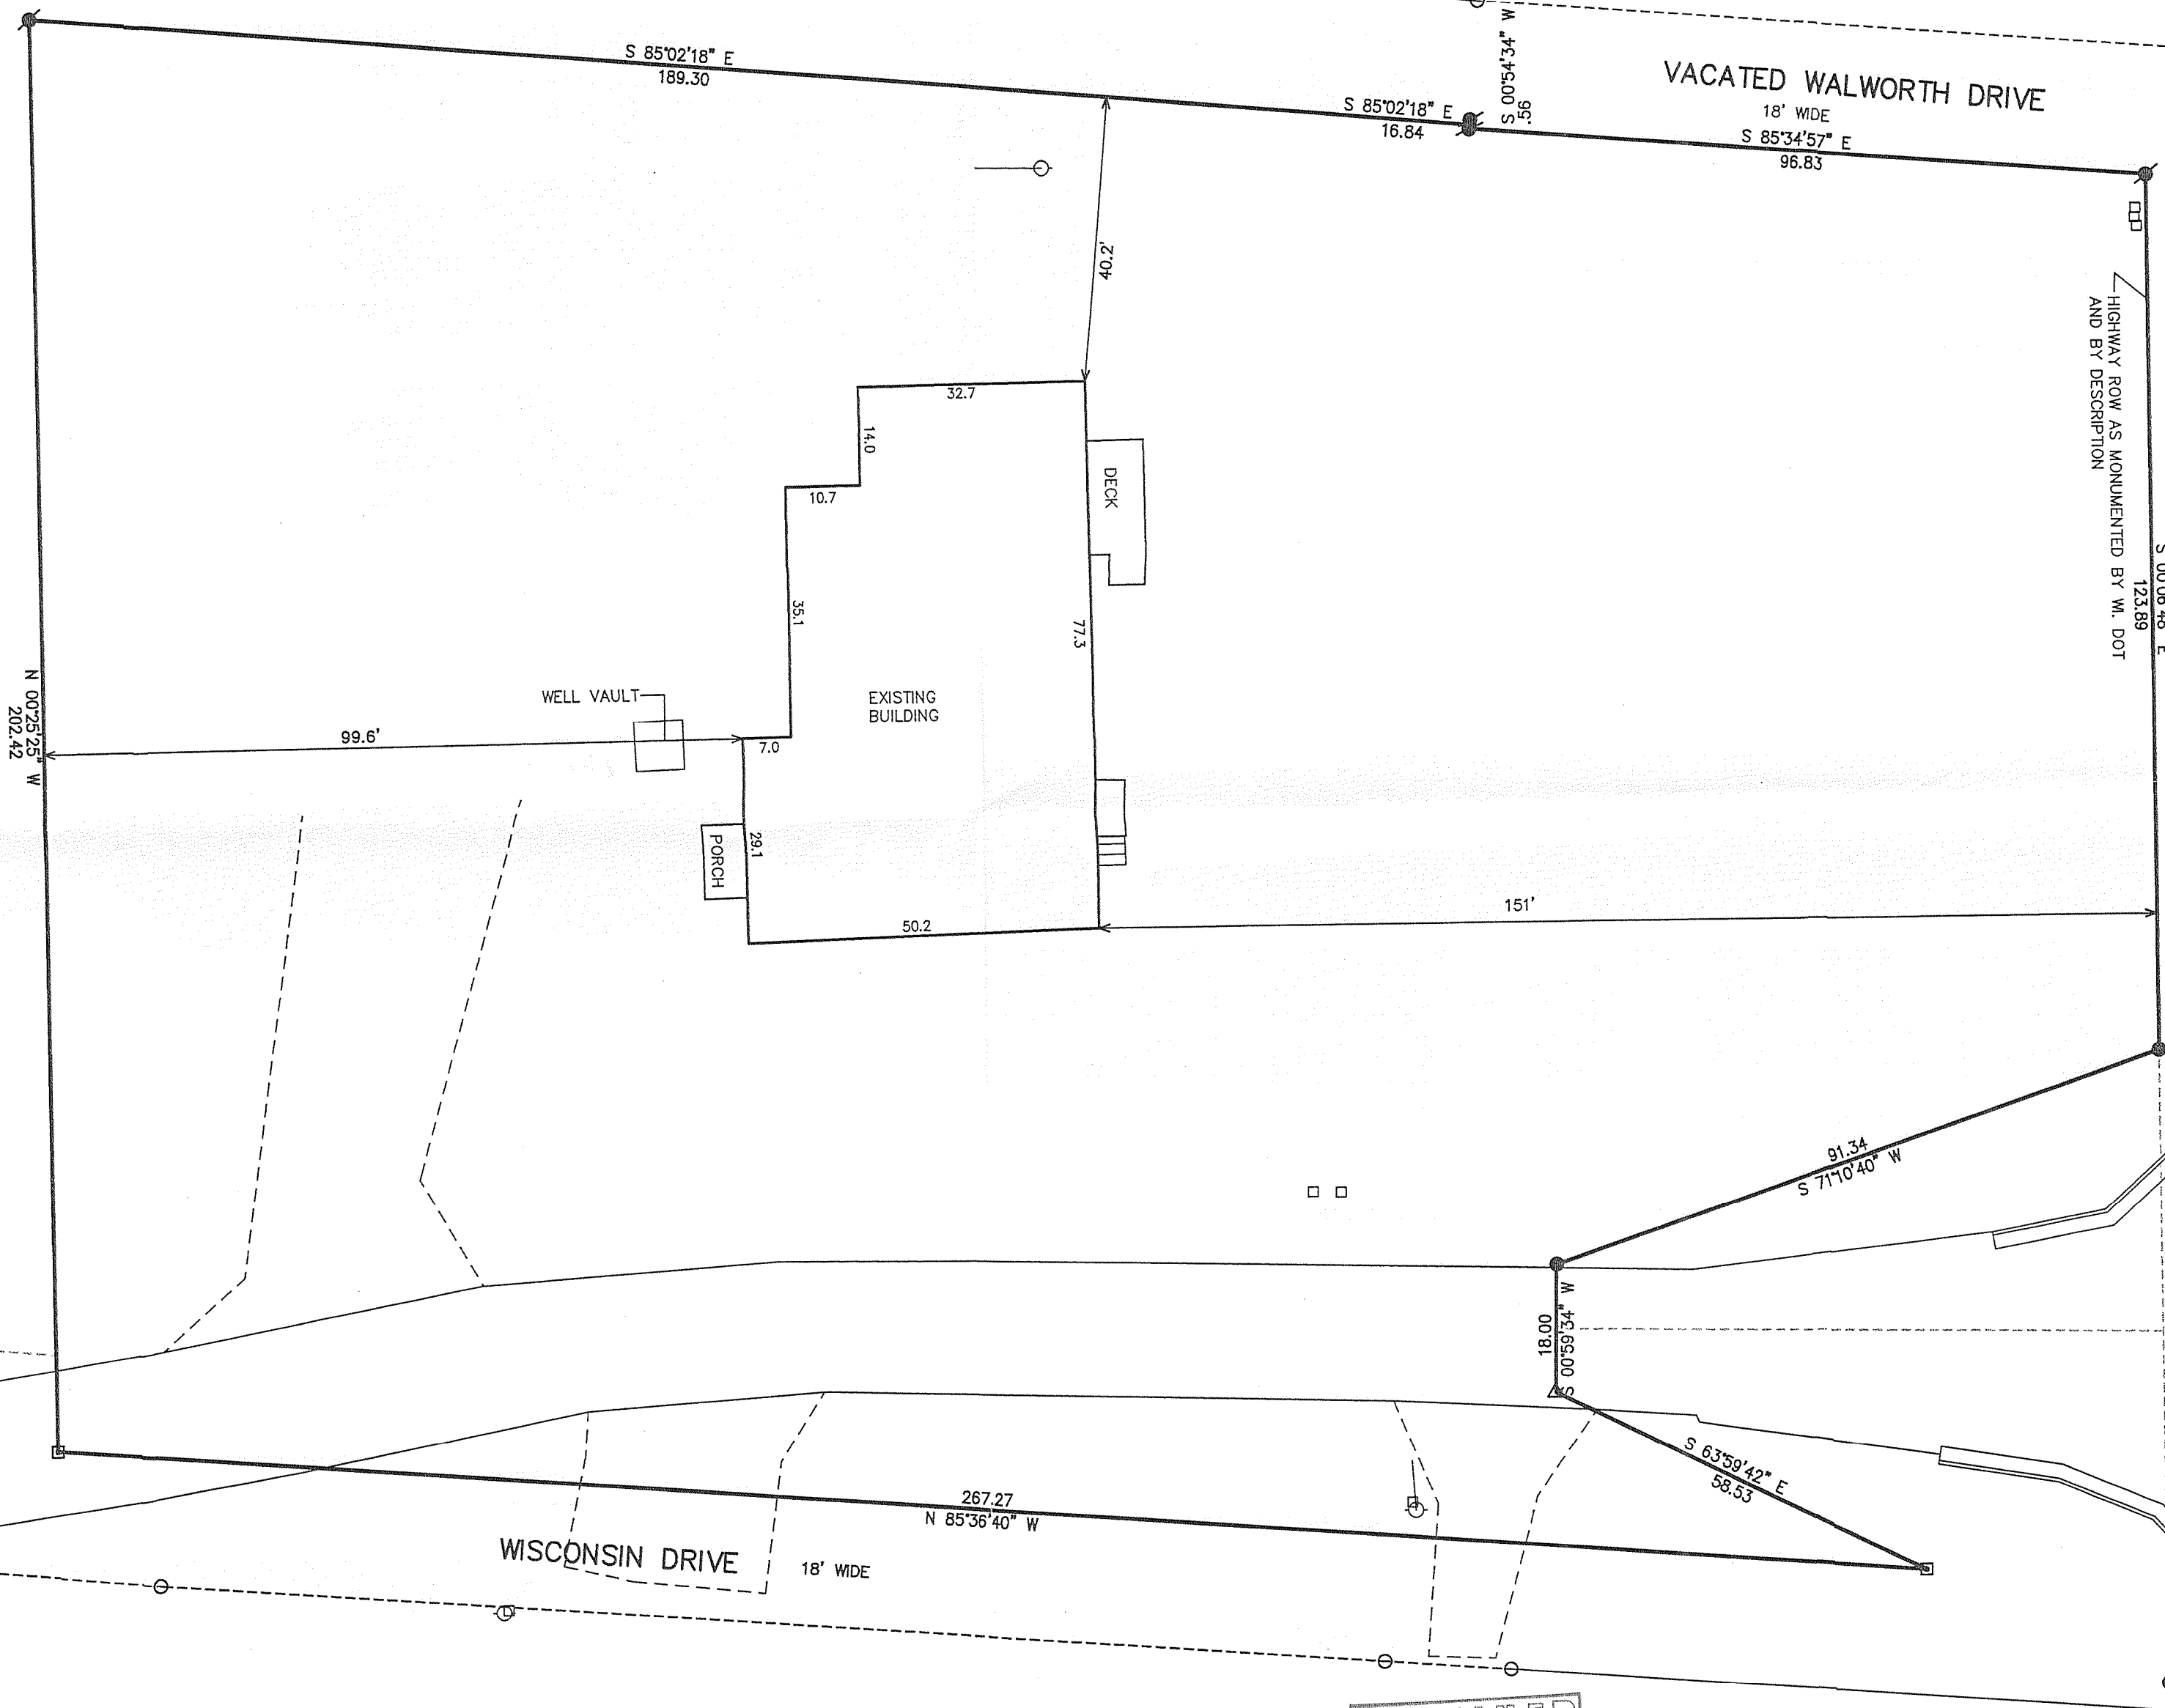

30' WIDE  
PER GOLF PARK ADDITION PLAT &  
PRIOR SURVEYS

WISCONSIN DRIVE  
18' WIDE




- LEGEND**
- = FOUND IRON PIPE STAKE
  - = SET IRON REBAR STAKE
  - = FOUND IRON REBAR STAKE
  - = SET NAIL
  - △ = FOUND PK NAIL
  - (XXX) = RECORDED AS

NOTE: COPIES OF THIS MAP TO WHICH THE FOLLOWING CERTIFICATE WILL  
APPLY SHOW SURVEYOR'S ORIGINAL SEAL AND SIGNATURE IN RED INK. COPIES  
BY ANY OTHER MEANS MAY HAVE ALTERATIONS WHICH DO NOT REPRESENT THE  
SURVEYOR'S WORK PRODUCT.

I HEREBY CERTIFY THAT THE ABOVE DESCRIBED PROPERTY HAS BEEN SURVEYED  
UNDER MY DIRECTION AND THAT THE ABOVE MAP IS A TRUE REPRESENTATION  
THEREOF AND SHOWS THE SIZE AND LOCATION OF THE PROPERTY AND ITS  
EXTERIOR BOUNDARIES. THIS SURVEY IS MADE FOR THE USE OF THE PRESENT  
OWNERS OF THE PROPERTY, AND ALSO THOSE WHO PURCHASE, MORTGAGE, OR  
GUARANTEE THE TITLE THERETO WITHIN ONE YEAR FROM THE DATE HEREOF.

DATED: MAY 18, 2009

PETER S. GORDON R.L.S. 2101

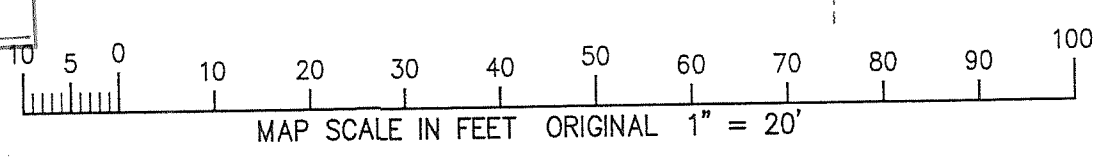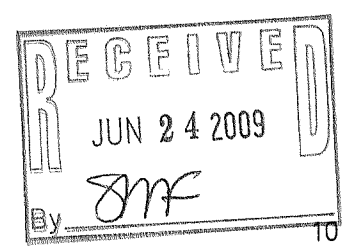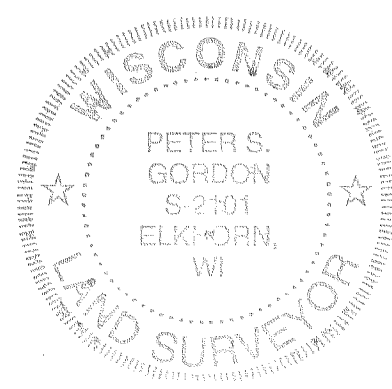

**FARRIS, HANSEN & ASSOCIATES, INC.**  
ENGINEERING - ARCHITECTURE - SURVEYING  
7 RIDGWAY COURT P.O. BOX 437  
ELKHORN, WISCONSIN 53121  
OFFICE: (262) 723-2098 FAX: (262) 723-5886

REVISIONS

PROJECT NO.  
7893  
DATE:  
05-14-2009  
SHEET NO.  
1 OF 1

5/18/2009 X:\Projects\7893\dead\survey

GLW- 383

316-2021