


Plat of Survey

of



Lot 54 of Lauderdale Lakes Estates,

a condominium located in the Southeast 1/4 of Section 1, Town 3 North,  
Range 16 East, Town of Sugar Creek, Walworth County, Wisconsin.

Surveyed for: **Clark Kohlhagen**  
N6921 Northwood Drive  
Elkhorn, Wisconsin. 53121

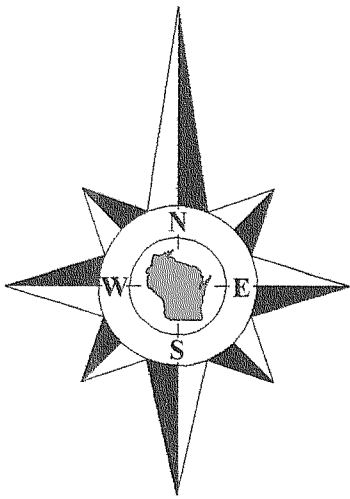

Bearings reference to the South line of Northwood Drive recorded as S76°48'40"W on the plat of Lauderdale Lakes Estates.

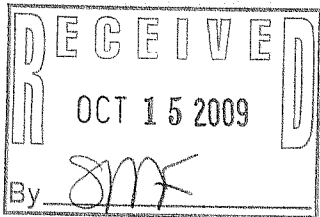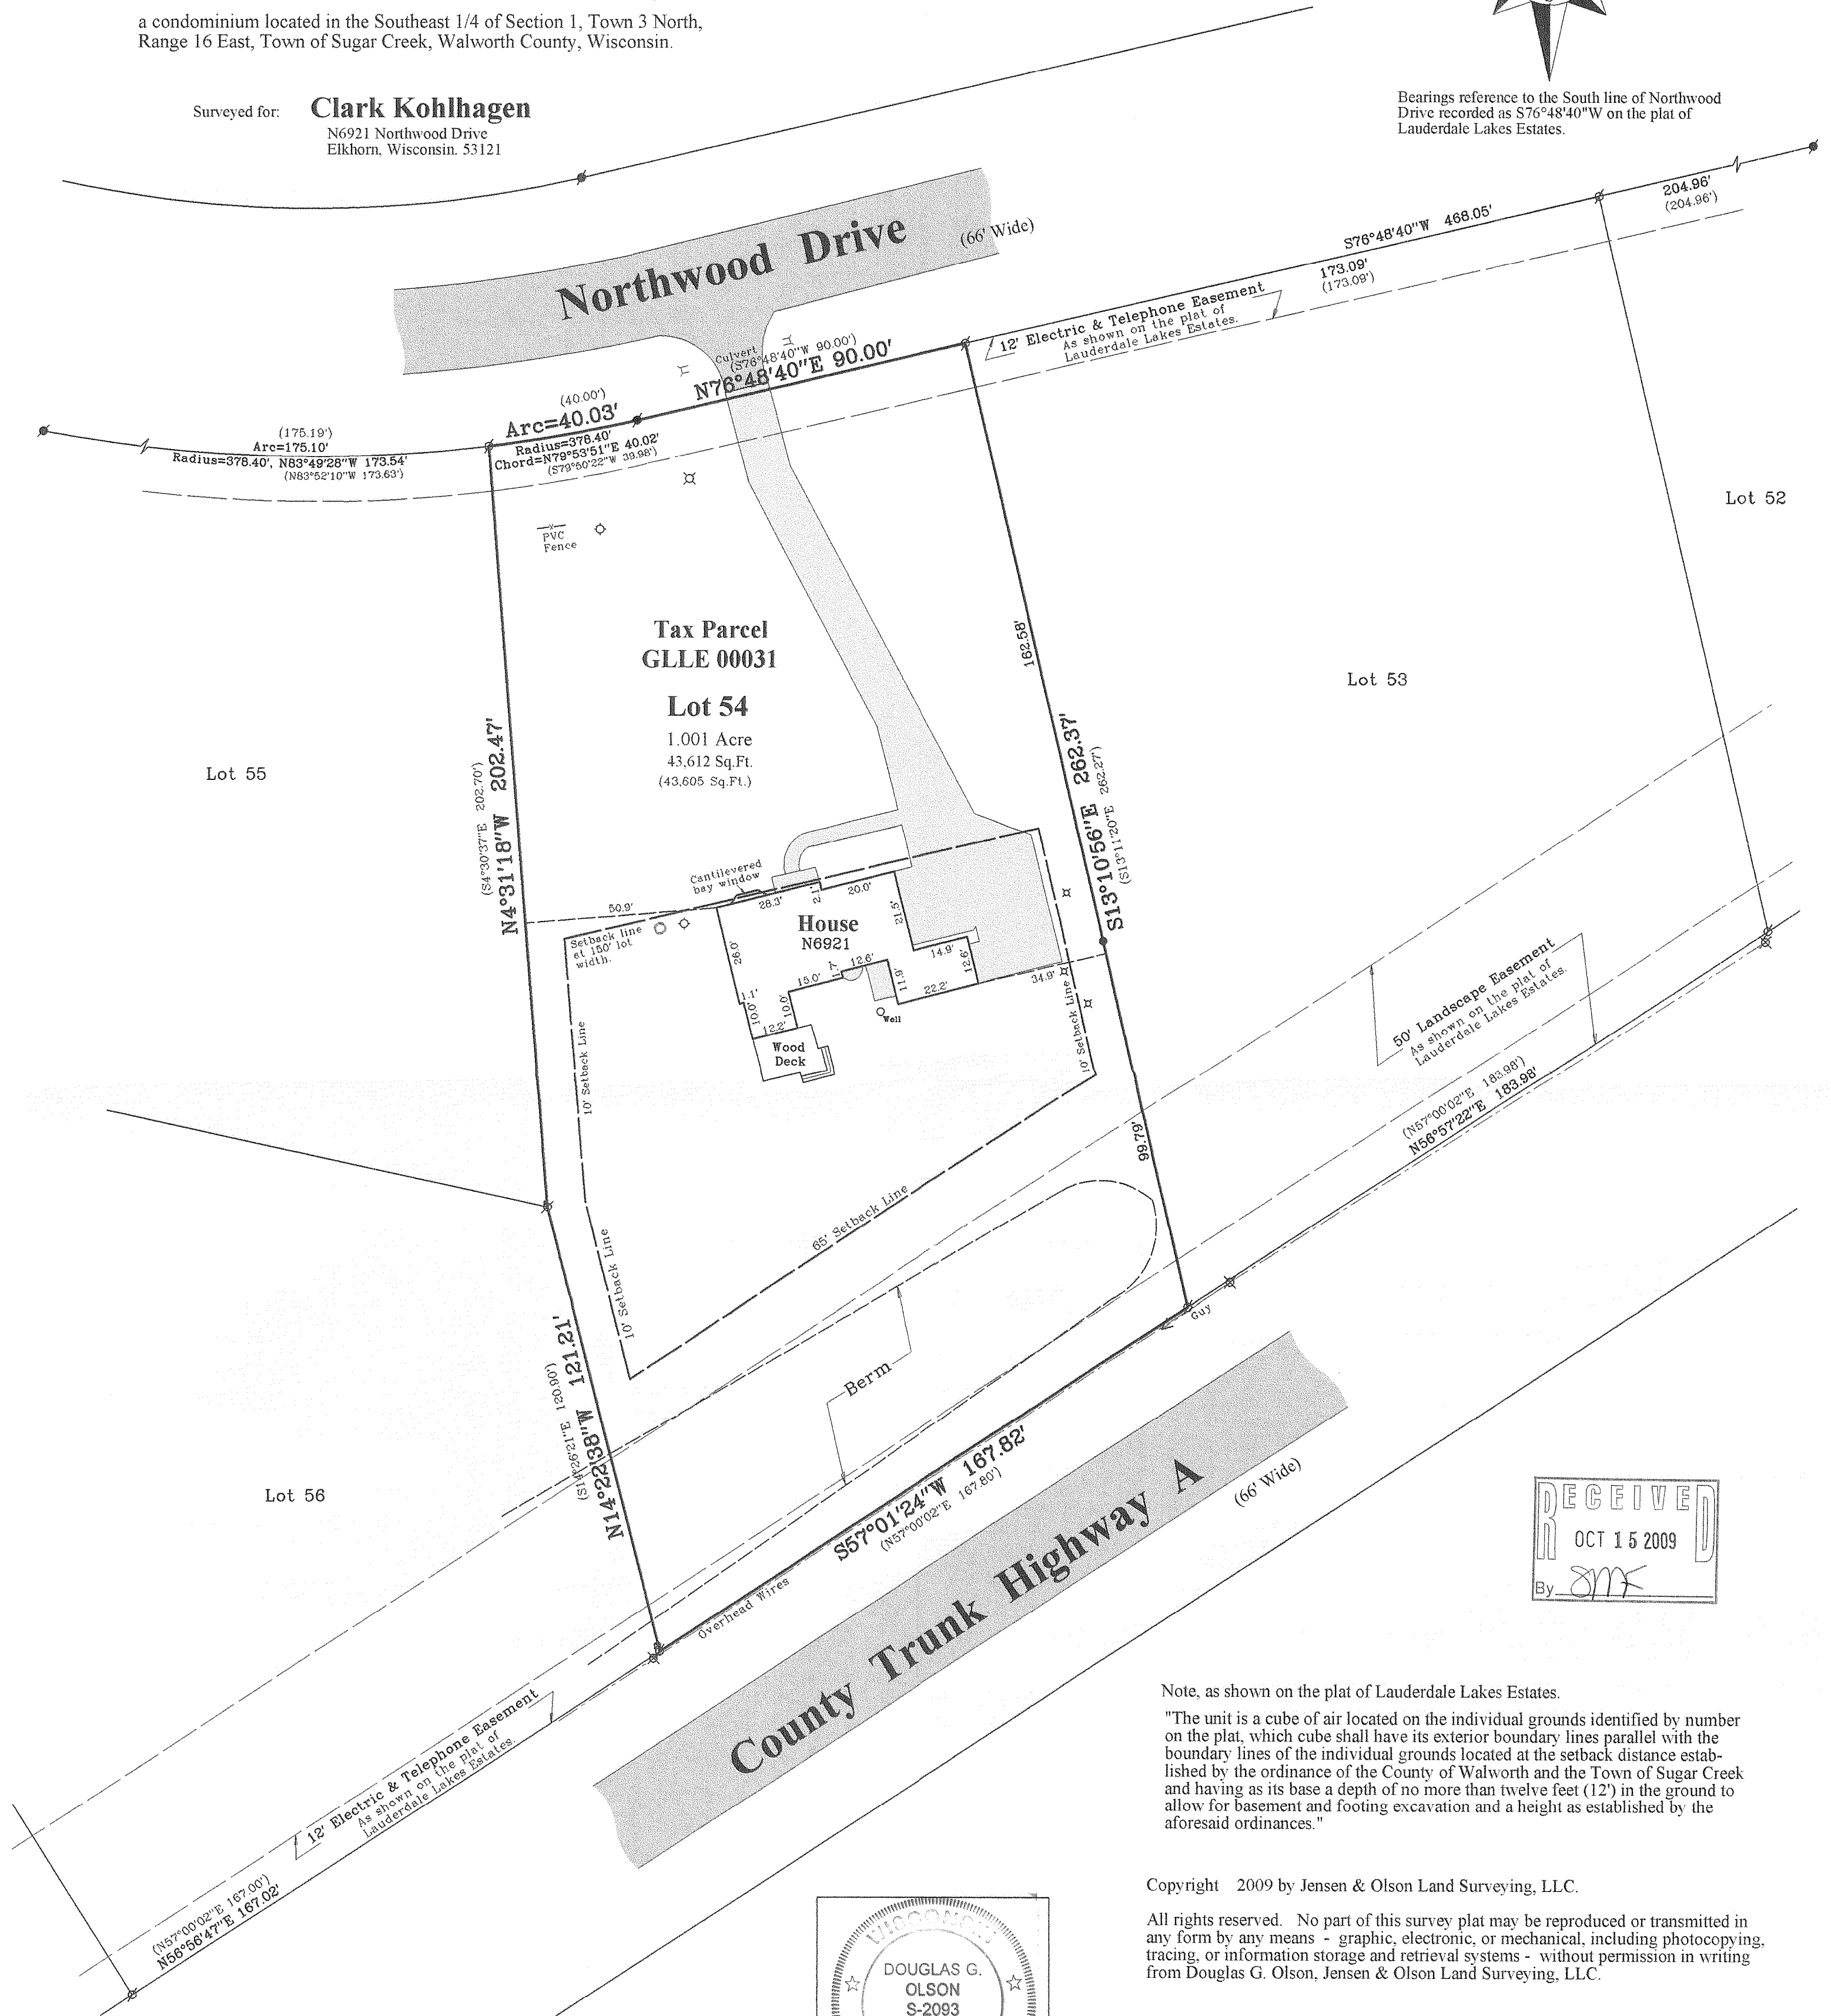

Note, as shown on the plat of Lauderdale Lakes Estates.

"The unit is a cube of air located on the individual grounds identified by number on the plat, which cube shall have its exterior boundary lines parallel with the boundary lines of the individual grounds located at the setback distance established by the ordinance of the County of Walworth and the Town of Sugar Creek and having as its base a depth of no more than twelve feet (12') in the ground to allow for basement and footing excavation and a height as established by the aforesaid ordinances."

Copyright 2009 by Jensen & Olson Land Surveying, LLC.


All rights reserved. No part of this survey plat may be reproduced or transmitted in any form by any means - graphic, electronic, or mechanical, including photocopying, tracing, or information storage and retrieval systems - without permission in writing from Douglas G. Olson, Jensen & Olson Land Surveying, LLC.

I, Douglas G. Olson, Wisconsin Registered Land Surveyor, do hereby certify that this survey was performed by me, or under my direction in full compliance with the owner's/agent's instructions and Chapter A-E 7 of the Wisconsin Administrative Code "Minimum Standards for Property Surveys"; and that this map is an accurate representation thereof to the best of my knowledge and belief.

Douglas G. Olson  
Wisconsin Registered Land Surveyor - 2093

Notes:


- 1) This survey plat is not certified unless signed and sealed in red ink.
- 2) This survey is subject to Wisconsin lien laws. This Plat of Survey is the notice of intent to file lien. Lien waiver required.

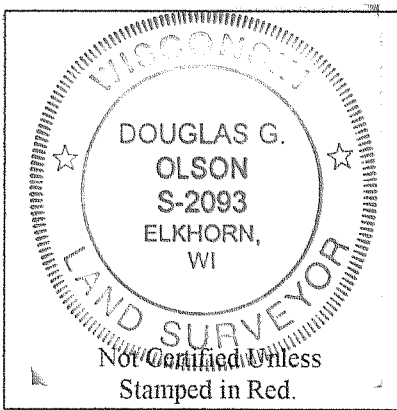

Jensen & Olson Land Surveying, LLC

45 South Wisconsin Street \* P.O. Box 322 \* Elkhorn, Wisconsin. 53121  
Telephone: (262) 723-3434 \* Facsimile: (262) 723-8044  
Email: jensen.olson@elknet.net

Scale in Feet  
1" = 30'

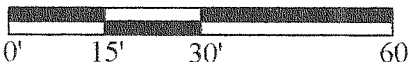

Survey Date: April 15, 2009.  
Revisions:

Sheet 1 of 1 Sheets

Drawing Name: t3nr16e-2009018-2009018 Plat.scj

Job Reference Number

2009.018

Legend

- Found Iron Pipe, 2" dia.
- Found Iron Pipe, 1" dia.
- Set Iron Rod, 3/4" dia.
- Recorded Information
- Concrete Cover
- Utility Pole
- Asphalt Surface
- Concrete Surface
- Septic Vent
- Light

2009.018

GLLE-31

316-2009