


ABELL  
 SURVEYING & MAPPING  
 1140 SEQUOIA STREET • DELAVAN, WISCONSIN 53115  
 262-728-6737




NOTE: BEARINGS ARE REFERENCED TO THE RECORDED SUBDIVISION PLAT.

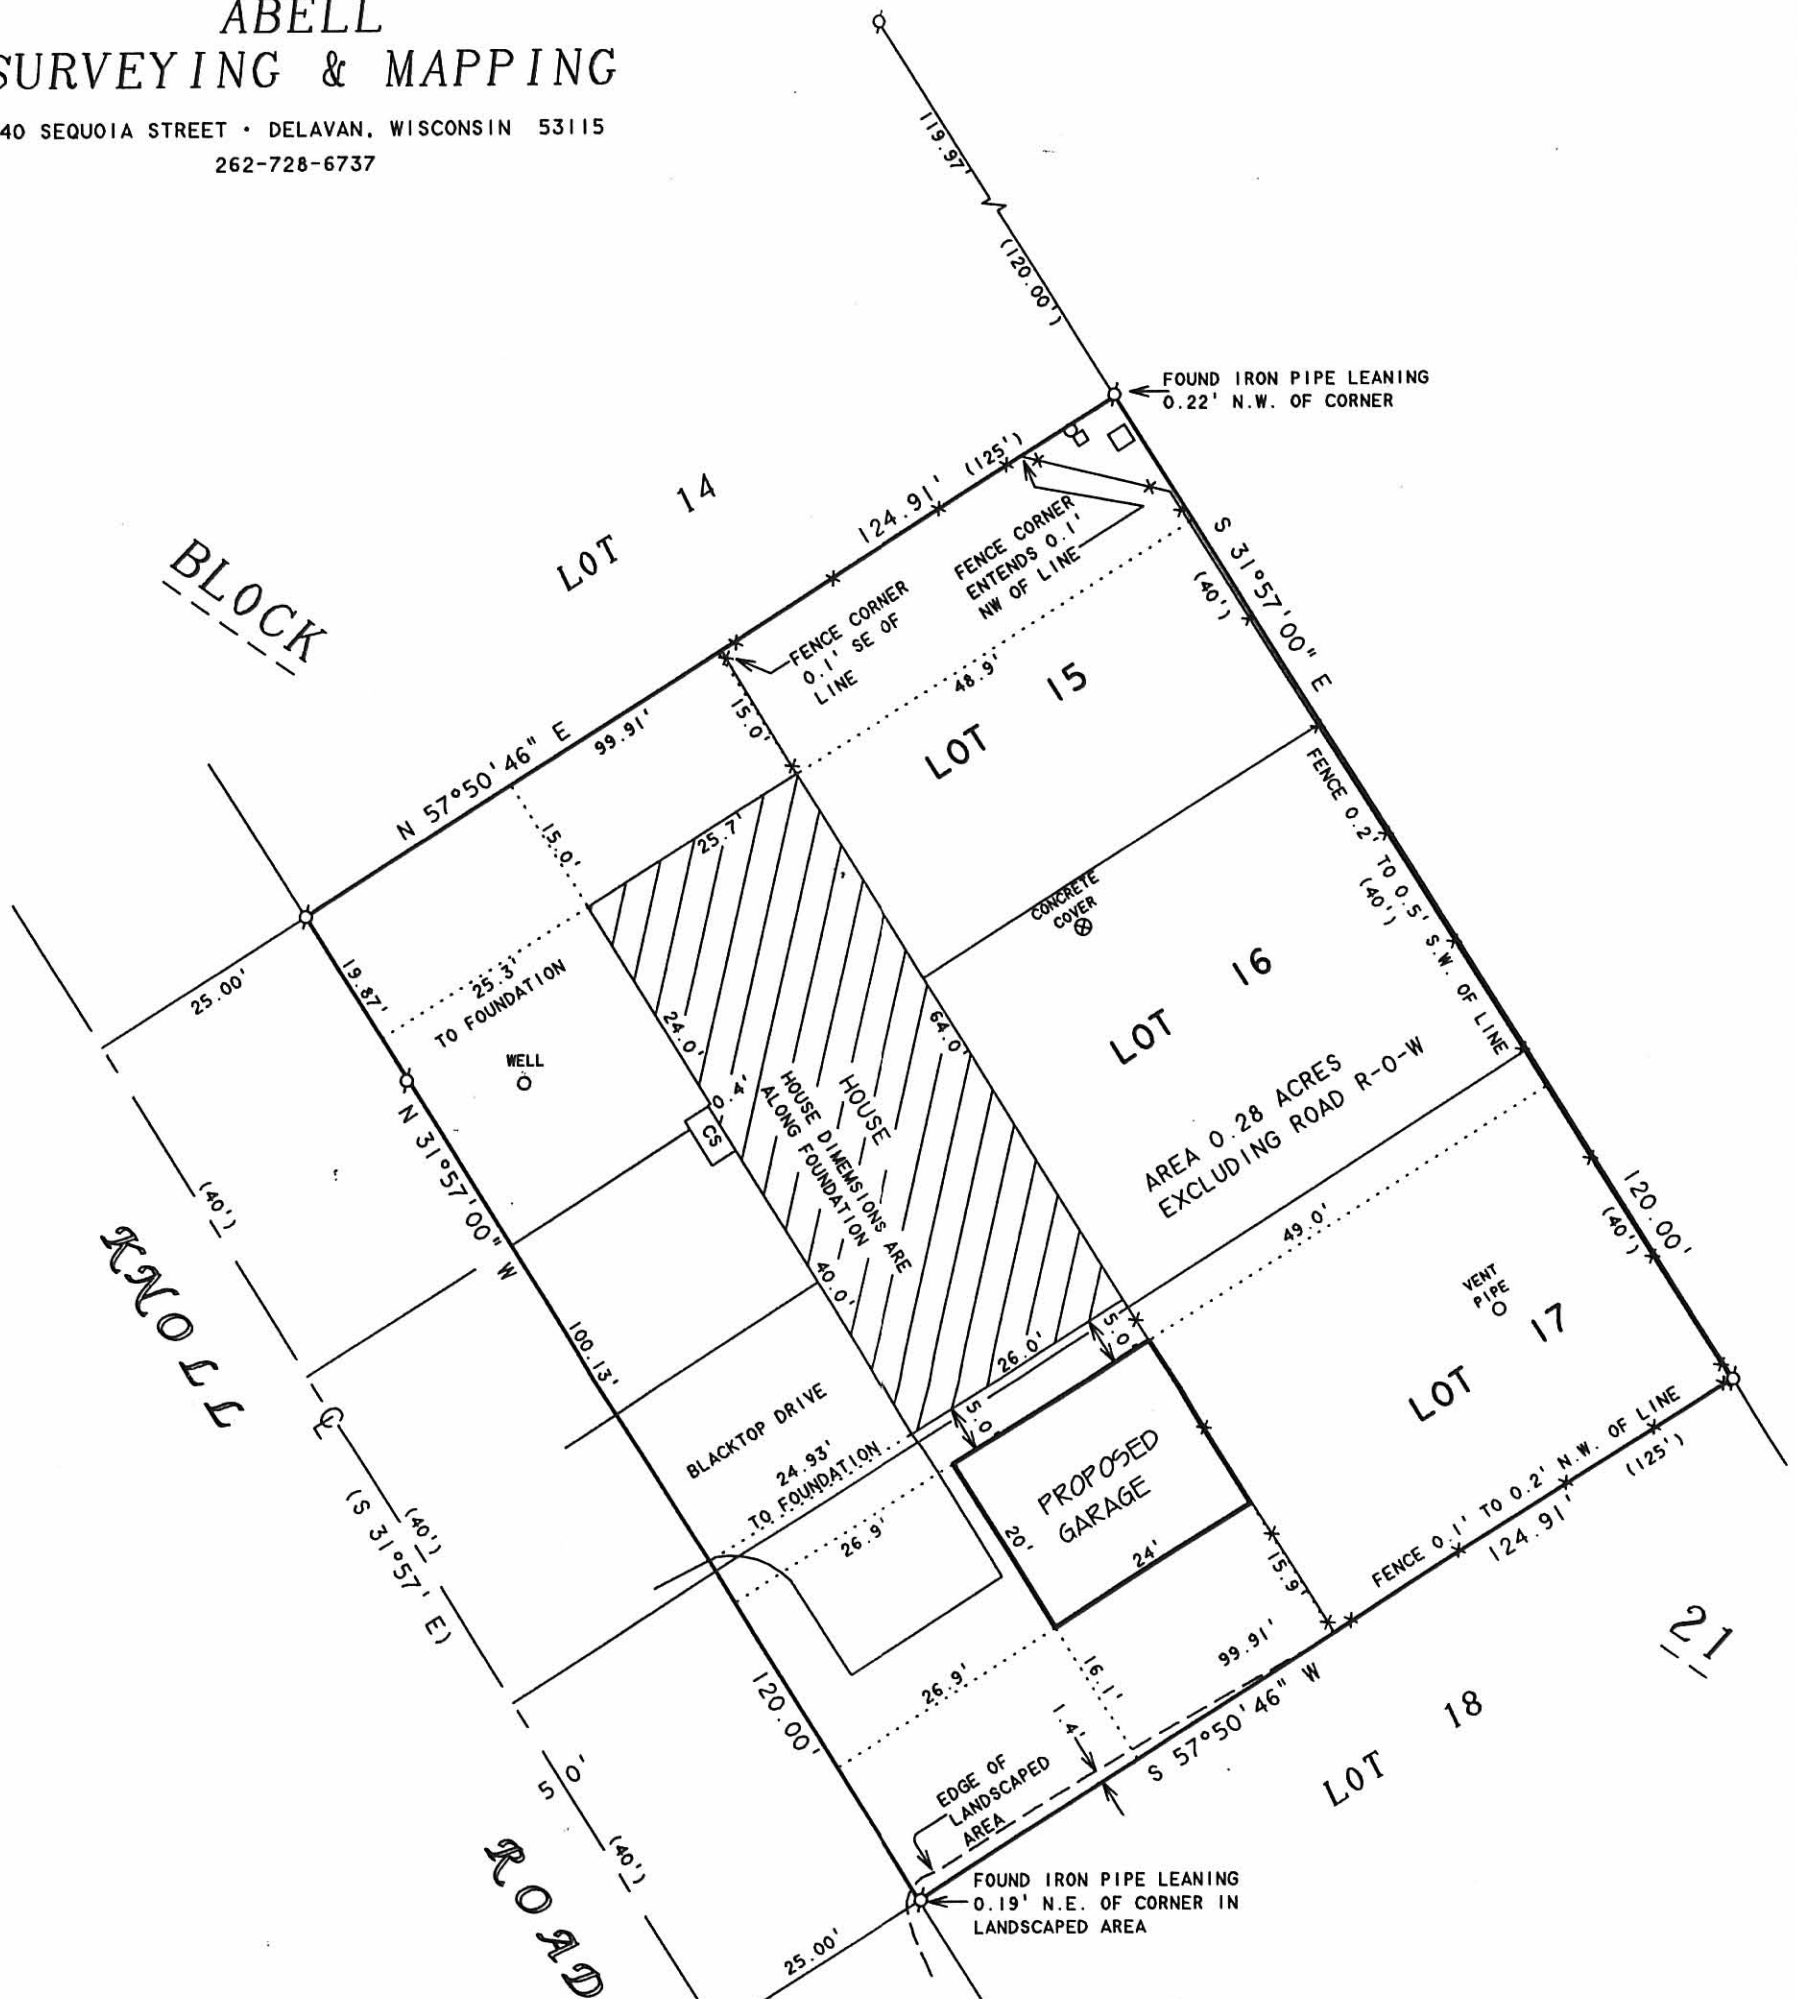

SCALE 1"=20'

LEGEND

- ⊙ - IRON PIPE FOUND
- CS - CONCRETE STOOP
- ○ - UTILITY PEDS.
- \* - CHAINLINK FENCE
- ( ) - RECORDED AS

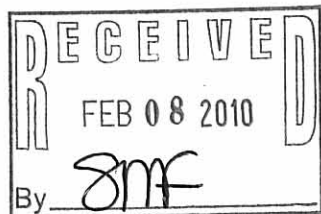

PLAT OF SURVEY OF

LOTS 15-17, BLOCK 21, INTERLAKEN SUBDIVISION,  
 LOCATED IN T3N, R16E, TOWN OF SUGAR CREEK,  
 WALWORTH COUNTY, WISCONSIN.

I, DAVID F. ABELL, DO HEREBY CERTIFY THAT I HAVE SURVEYED THE PROPERTY HEREON DESCRIBED ACCORDING TO THE OFFICAL RECORDS AND THAT THE PLAT HEREON IS A CORRECT REPRESENTATION OF THE PROPERTY LINES TO THE BEST OF MY KNOWLEDGE AND BELIEF.

*David F. Abell*

DAVID F. ABELL  
 WISCONSIN REGISTERED LAND SURVEYOR, S-1596

ORDERED BY: ED GAGE  
 N6604 KNOLL ROAD  
 ELKHORN, WISCONSIN 53121

November 5, 2009

DATE: November 5, 2009 JOB NUMBER - 92219A  
 NOTE: THIS IS NOT A CERTIFIED COPY UNLESS SEALED.

GII-258A1

316-2037