


ABELL SURVEYING & MAPPING

1140 SEQUOIA STREET • DELAVAN, WISCONSIN 53115
262-728-6737

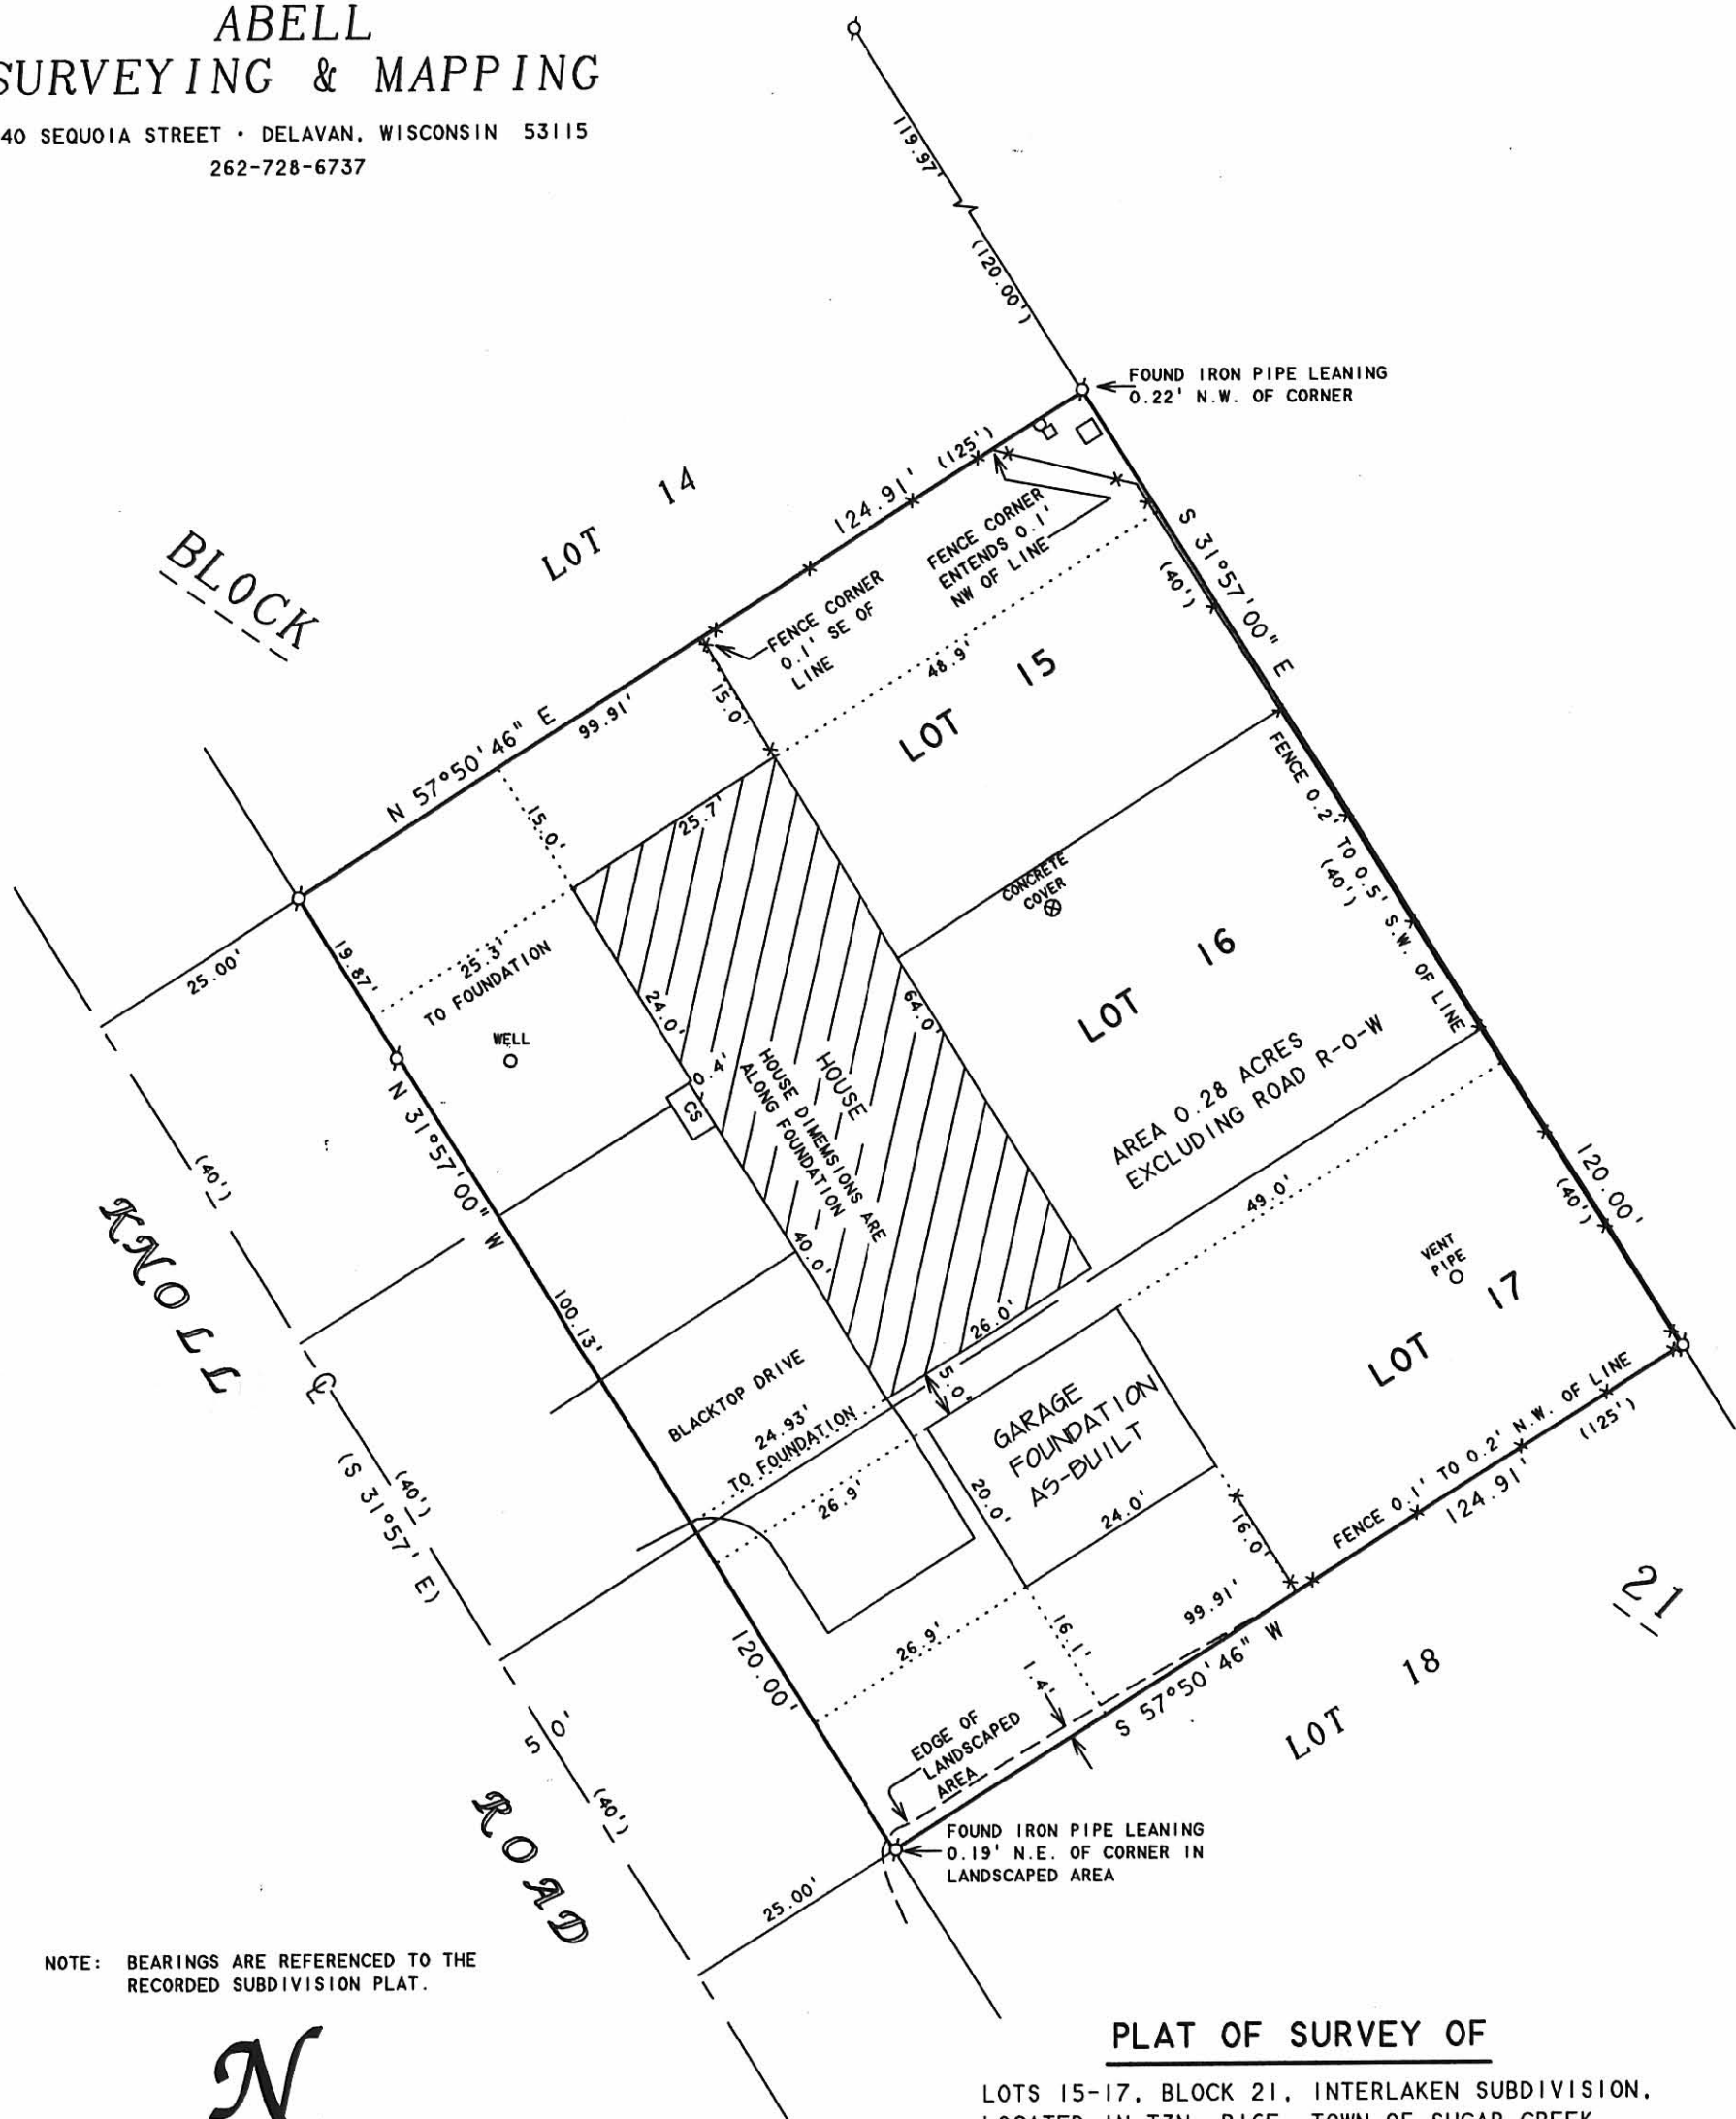

NOTE: BEARINGS ARE REFERENCED TO THE
RECORDED SUBDIVISION PLAT.


N



SCALE 1"=20'

LEGEND

- - IRON PIPE FOUND
- CS - CONCRETE STOOP
- - UTILITY PEDS.
- X— - CHAINLINK FENCE
- () - RECORDED AS

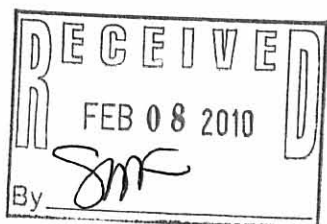

REVISED DATE: DECEMBER 14, 2009
REVISED TO SHOW LOCATION OF GARAGE
FOUNDATION AS-BUILT.

ORDERED BY: ED GAGE
N6604 KNOLL ROAD
ELKHORN, WISCONSIN 53121

PLAT OF SURVEY OF

LOTS 15-17, BLOCK 21, INTERLAKEN SUBDIVISION,
LOCATED IN T3N, R16E, TOWN OF SUGAR CREEK,
WALWORTH COUNTY, WISCONSIN.

I, DAVID F. ABELL, DO HEREBY CERTIFY THAT I HAVE SURVEYED THE PROPERTY HEREON
DESCRIBED ACCORDING TO THE OFFICIAL RECORDS AND THAT THE PLAT HEREON IS A
CORRECT REPRESENTATION OF THE PROPERTY LINES TO THE BEST OF MY KNOWLEDGE AND
BELIEF.

David F. Abell

DAVID F. ABELL
WISCONSIN REGISTERED LAND SURVEYOR, S-1596

November 5, 2009

DATE: November 5, 2009 JOB NUMBER - 92219B
NOTE: THIS IS NOT A CERTIFIED COPY UNLESS SEALED.

GI-258A1

316-2038