PREPARED FOR DALE MANGOLD N6560 ELM RD. ELKHORN WI. 53121

PLAT OF SURVEY


-OF-

LOTS 12 THRU 17 AND LOTS 23 THRU 25 AND THE SOUTH 1/2 OF LOT 26 IN BLOCK 12 OF INTERLAKEN SUBDIVISION, LOCATED IN THE TOWN OF SUGER CREEK, WALWORTH COUNTY, WISCONSIN.

KROTT SURVEYING INC.

N3705 WILLOW BEND LANE
LAKE GENEVA WI 53147

N3703 WILLOW BEND LAN LAKE GENEVA WI. 53147 PHONE # (262)248-3697 FAX # (262)249-0639

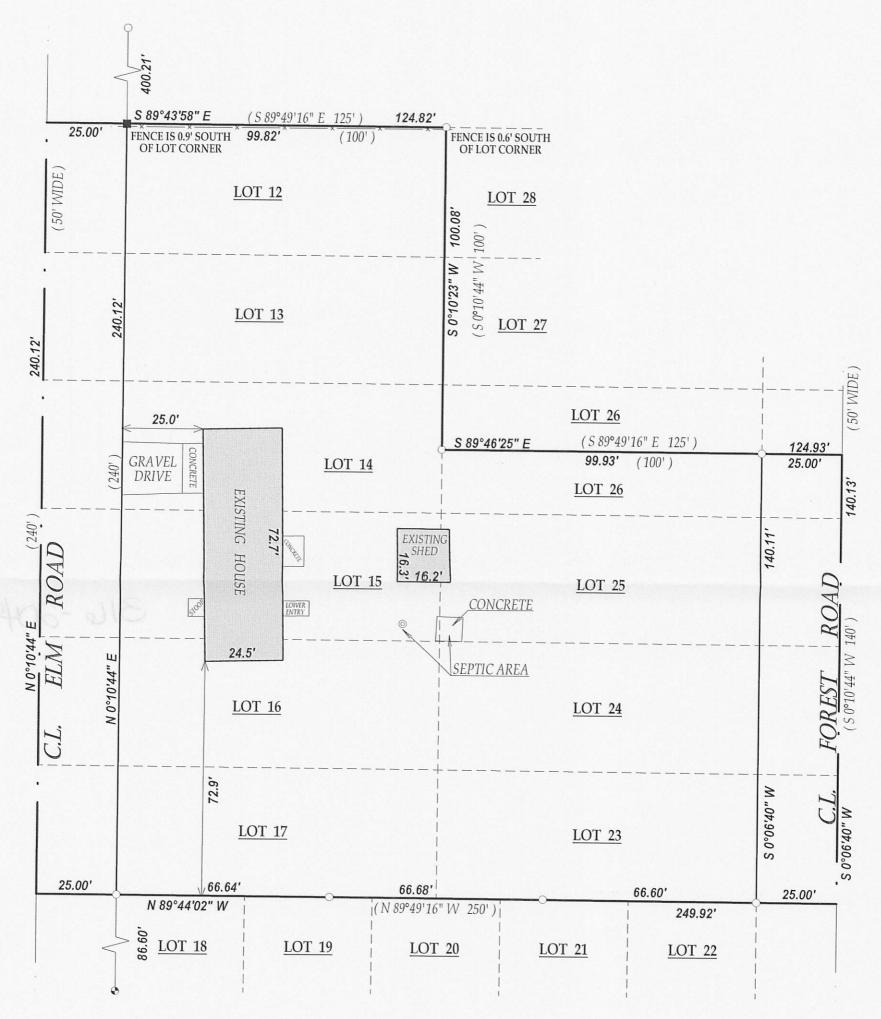




LEGEND

- O FOUND IRON PIPE
- FOUND CONCRETE MONUMENT
- SET IRON BAR

(XX) RECORDED AS TAX ID # GI000120&124 JOB # 10-078

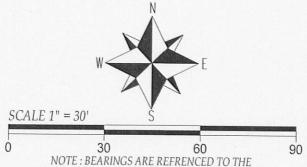

NOTE: BEARINGS ARE REFRENCED TO THE RECORD PLAT OF INTERLAKEN SUBDIVISION.

I have surveyed the above-described property and the above map is a true representation thereof and shows the size and location of the property, its exterior boundaries, the location and dimensions of all structures thereon, fences apparent easements and roadways and visible encroachments. if any.

This survey is made for the exclusive use of the present owners of the property, and also those who puchase, mortgage, or insure the title therto within one (1) year from date hereof; and as to them I warrant the accuracy of said survey map.



DATED THIS 4th DAY OF MAY 2010.

JOHN KROTT S - 2258 Wisconsin Registered Land Surveyor (original if signed in red)

211- 20.10