

# PLAT OF SURVEY

LOT 3, CERTIFIED SURVEY MAP NO. 2661, LOCATED IN THE NORTHWEST 1/4 OF SECTION 2, TOWN 3 NORTH, RANGE 16 EAST, WALWORTH COUNTY, WISCONSIN.


SURVEYED FOR: DOUG REHARD

SURVEY ADDRESS: W5567 PLANTATION ROAD




SCALE 1"=30'

MONUMENTATION WAS WAIVED BY CLIENT IN ACCORDANCE WITH A-7.01(2) OF THE WISCONSIN ADMINISTRATIVE CODE.

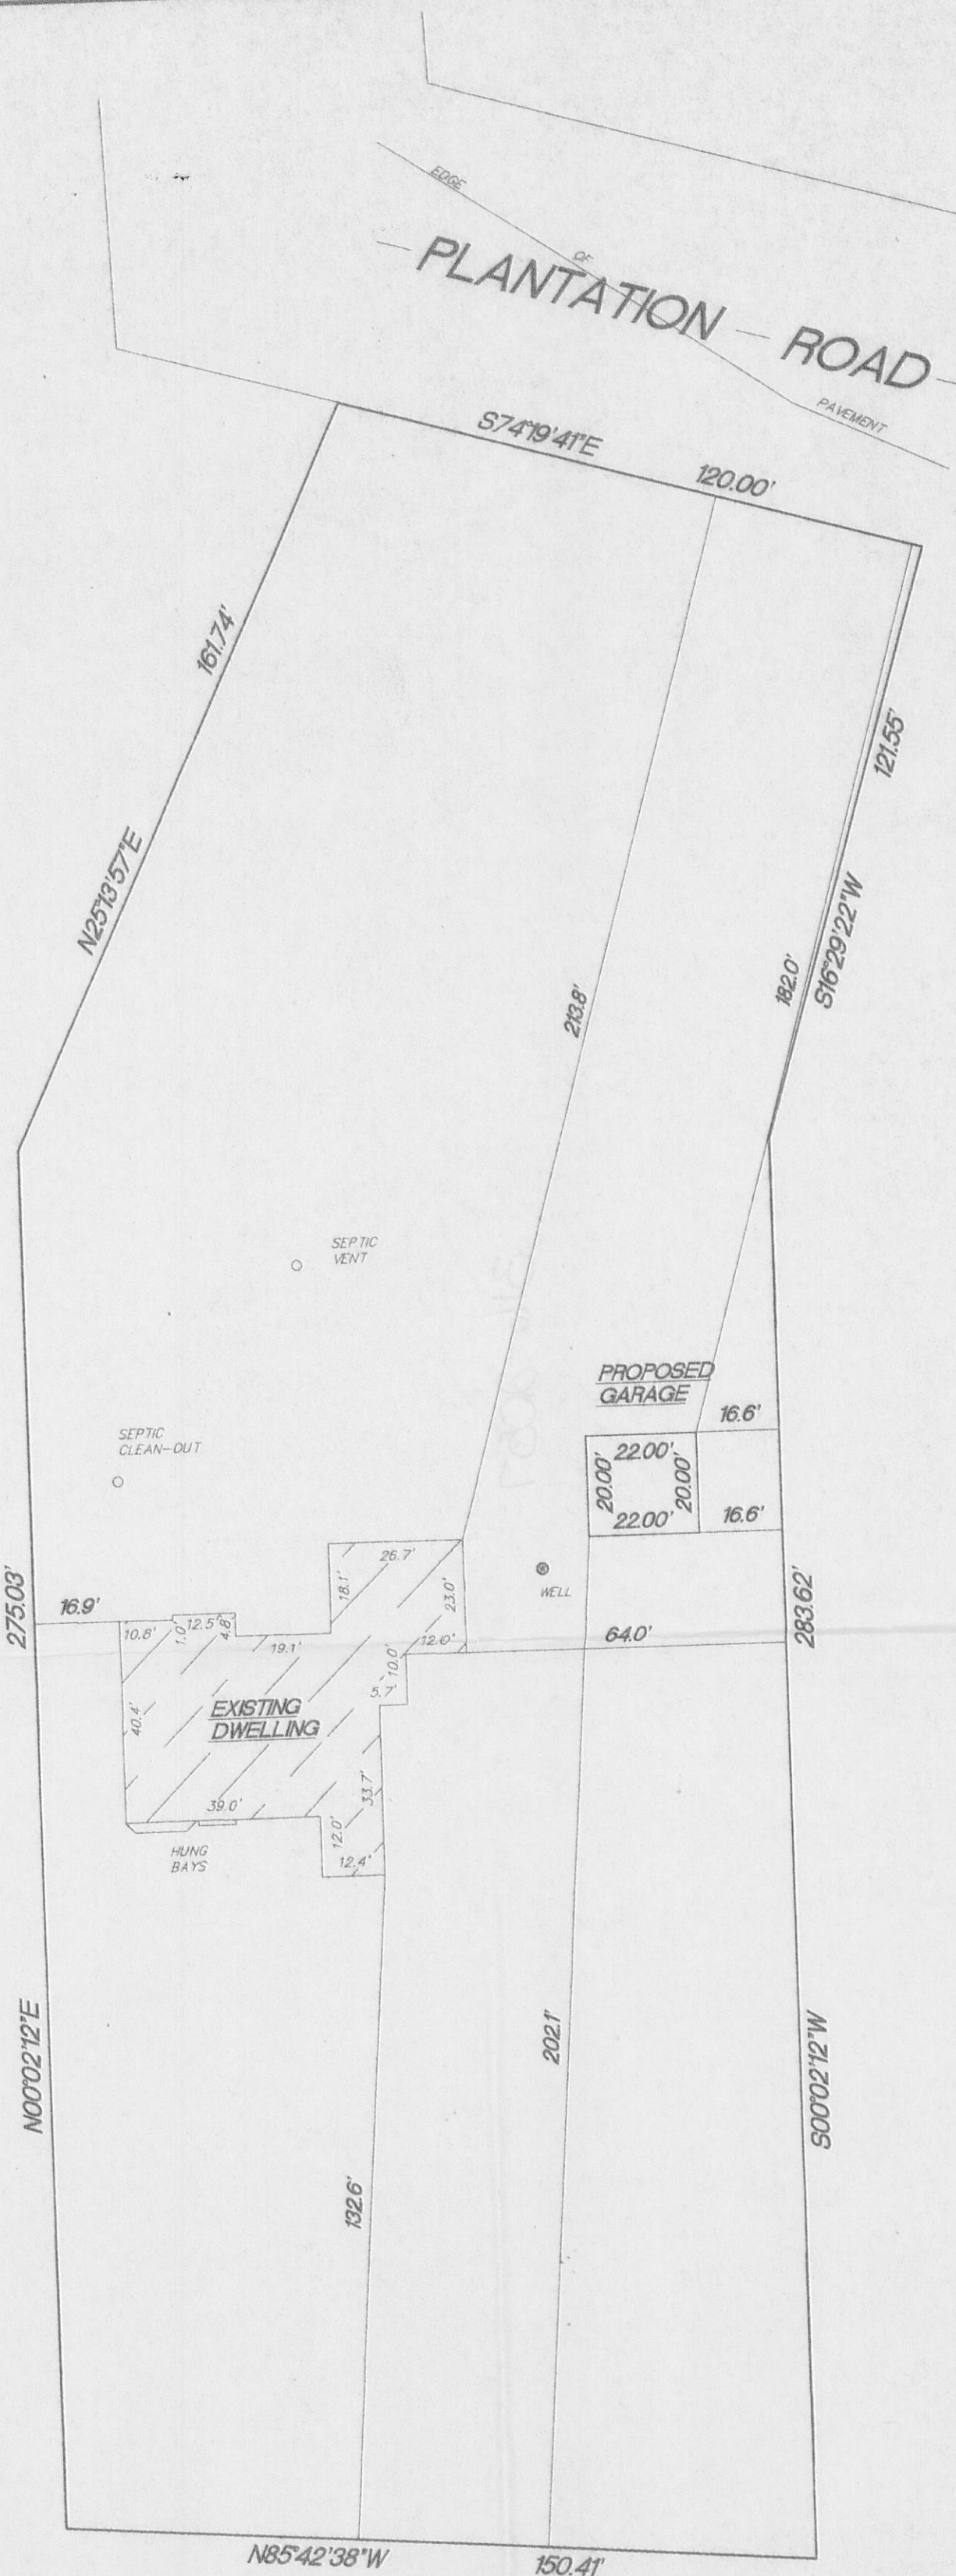

Kettle Moraine Surveying  
W562-810227 Lewin Lane  
Eagle WI. 53119  
(414)594-3484

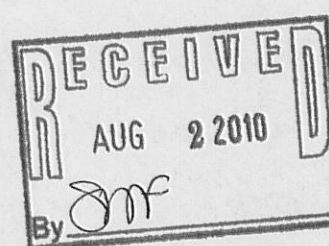

"I hereby certify that I have surveyed the above property and that the above map is a true representation thereof and shows the size and location of the property exterior boundaries, the location of all visible structures and dimensions of all principal buildings thereon, boundary fences, apparent easements, roadways and encroachments if any."  
"This survey is made for the use of the present owners of the property, and also those who purchase, mortgage or guarantee the title thereto within one year from date hereof."

THIS IS NOT AN ORIGINAL SURVEY UNLESS THE SEAL IS RED.

REV. 6/21/10  
11/11/97  
DATE

TJP/DPS  
FIELD WORK BY

TJP  
DRAWN BY

97233  
JOB NUMBER

316-2057

GA2601-3