

Plat of Survey


of

Lot 1, the Southeasterly 2/3 of Lot 2,
Lot 32 and Lot 33 all in Block 43
of the Fourth Map of Interlaken,


a subdivision located in the Northeast 1/4 of Section 11, Town
3 North, Range 16 East, Town of Sugar Creek, Walworth County,
Wisconsin.

Surveyed for: **Mary Gustafson**
3149 South Superior Street
Milwaukee, Wisconsin. 53207

Witness Corner
Section 11-3-16
(N. 273.370.17)
(E. 2.383.461.03)

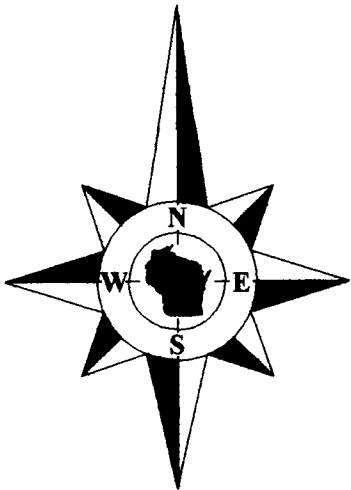

Bearings referenced to the
plat of Interlaken.

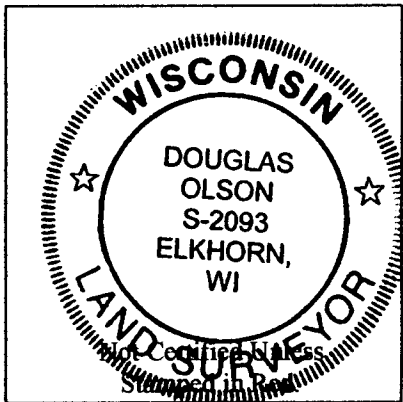

Notes:



- 1) This survey plat is not certified unless signed and sealed in red ink.
- 2) This survey is subject to Wisconsin lien laws. This Plat of Survey is the notice of intent to file lien. Lien waiver required.

Copyright 2010 by Jensen & Olson Land Surveying, LLC.

All rights reserved. No part of this survey plat may be reproduced or transmitted in any form by any means - graphic, electronic, or mechanical, including photocopying, tracing, or information storage and retrieval systems - without permission in writing from Douglas G. Olson, Jensen & Olson Land Surveying, LLC.

I, Douglas G. Olson, Wisconsin Registered Land Surveyor, do hereby certify that this survey was performed by me, or under my direction in full compliance with the owner's/agent's instructions and Chapter A-E 7 of the Wisconsin Administrative Code "Minimum Standards for Property Surveys"; and that this map is an accurate representation thereof to the best of my knowledge and belief.

Douglas G. Olson
Wisconsin Registered Land Surveyor - 2093

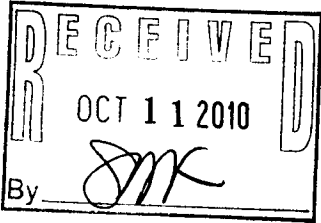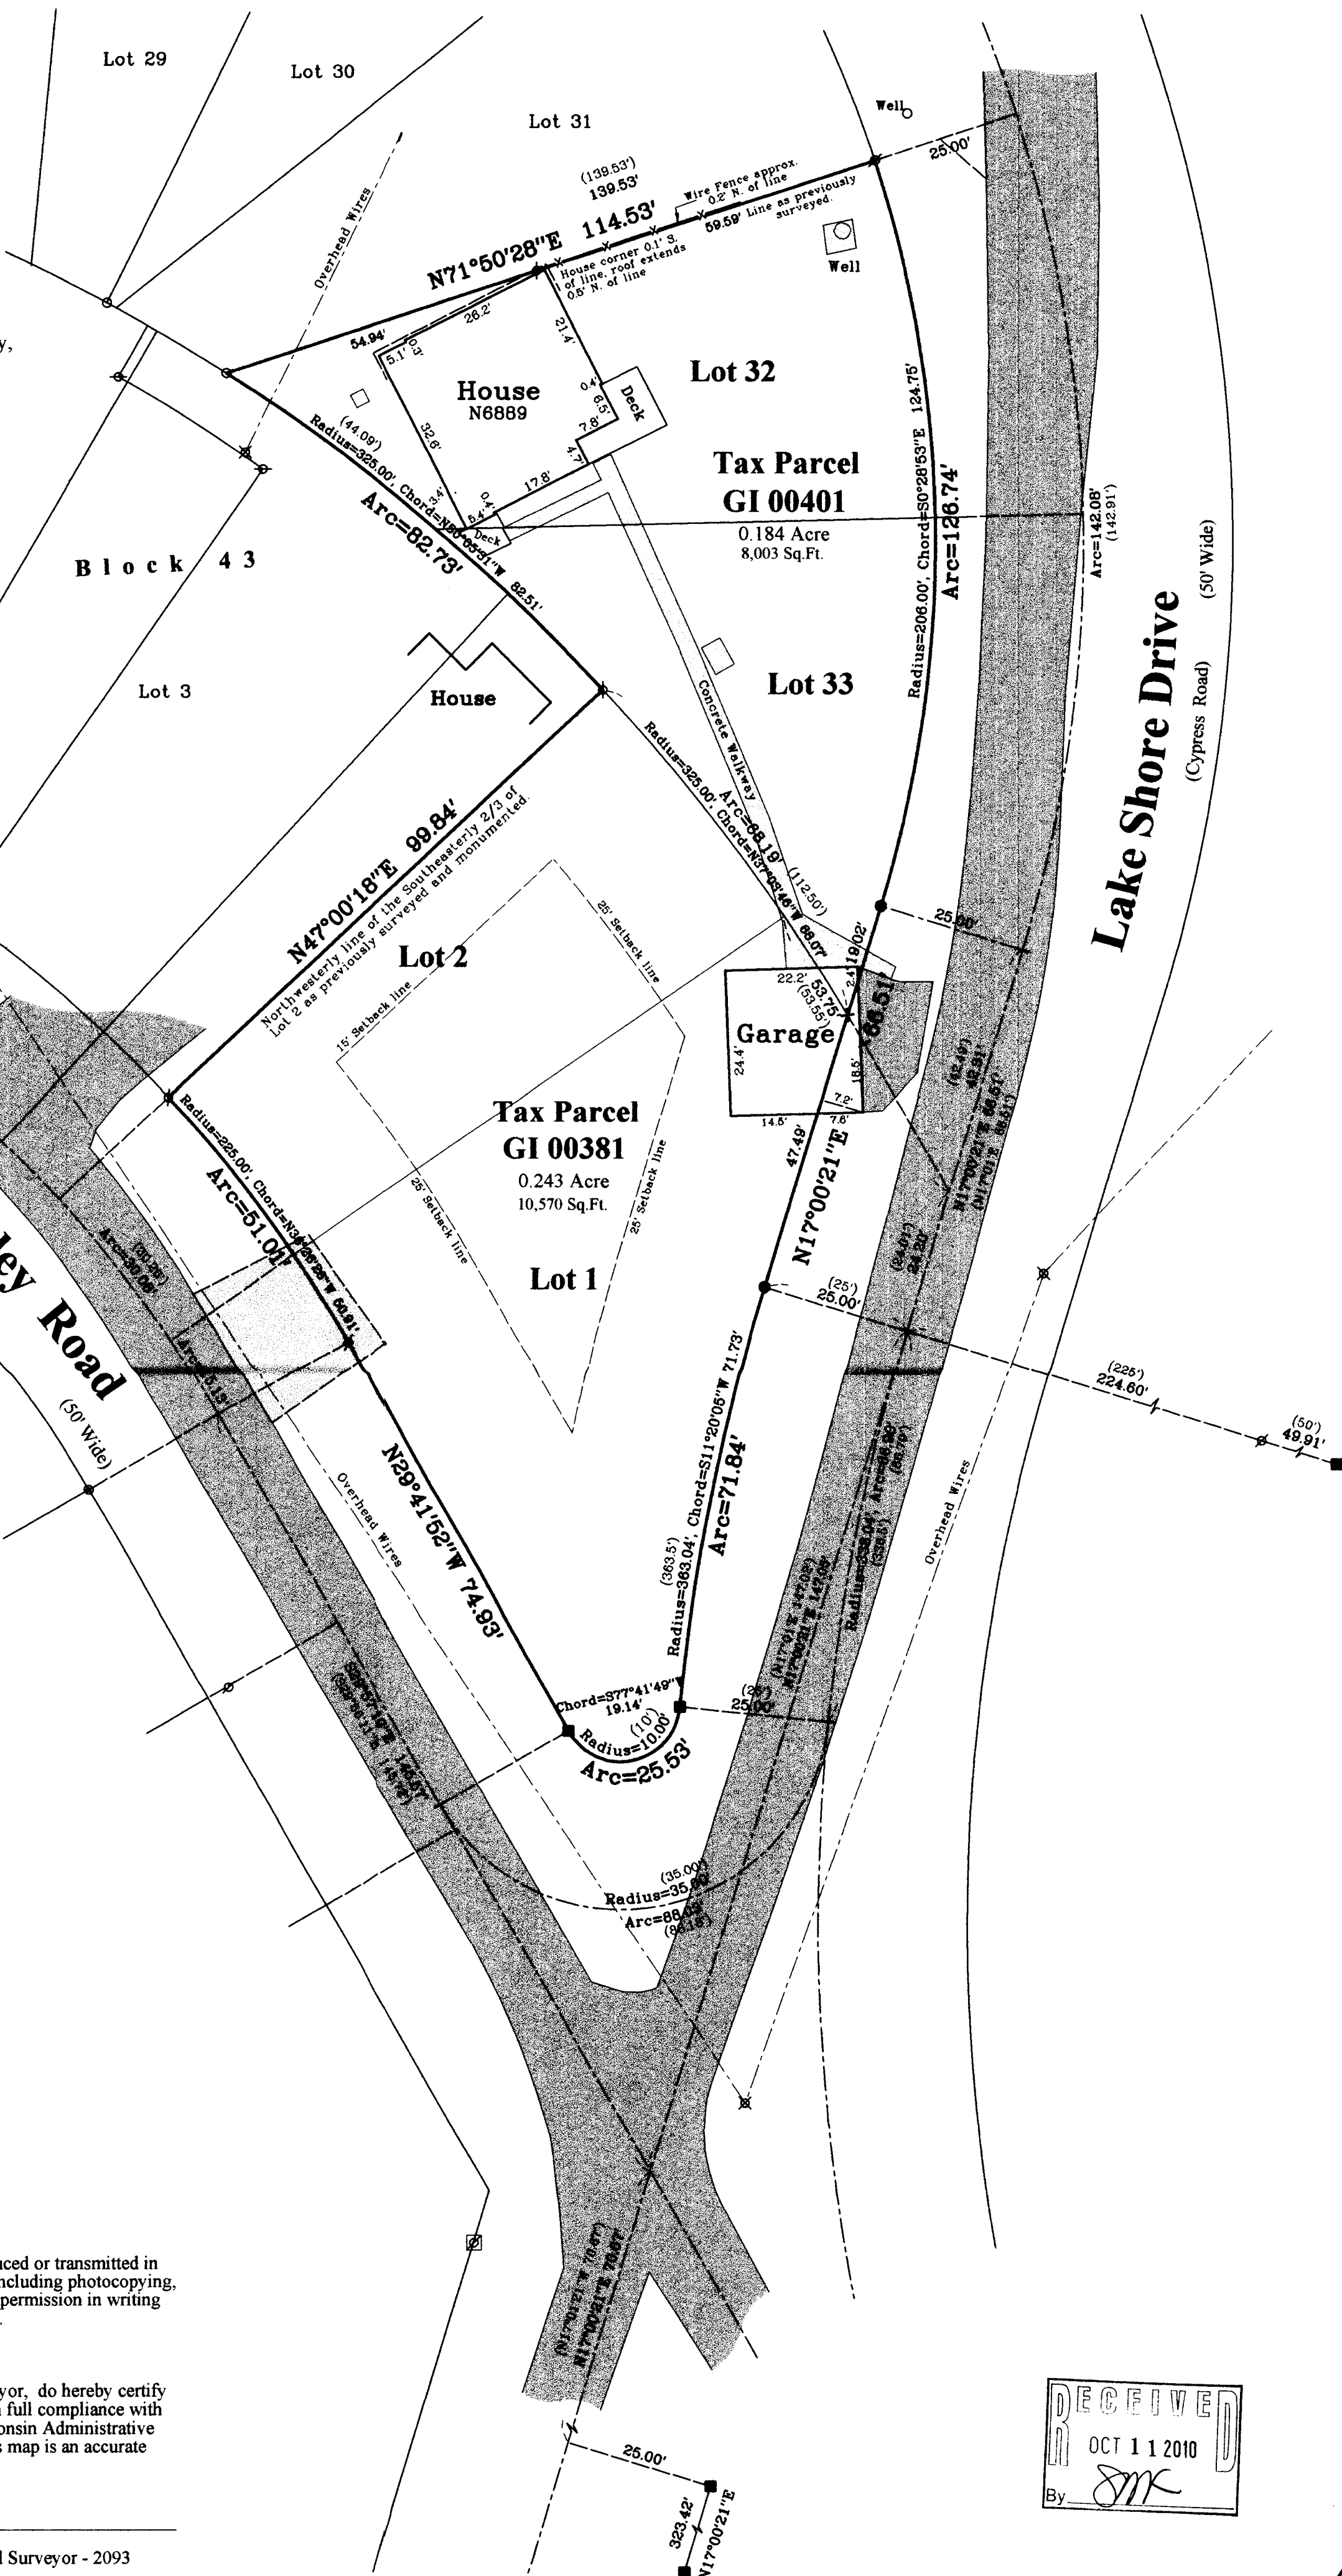

2009.092

Sheet 1 of 1 Sheets	Legend
Drawing Name: 13m16e-2009092-2009092Plat.sj	Found Concrete Monument
Job Reference Number	Found Iron Pipe
2009.092	Found Iron Rod
	Set Iron Rod 3/4" dia.
	Recorded Information
	Utility Pole
	Asphalt Surface
	Concrete Surface
	Gravel Surface

Jensen & Olson Land Surveying, LLC

45 South Wisconsin Street * P.O. Box 322 * Elkhorn, Wisconsin. 53121
Telephone: (262) 723-3434 * Facsimile: (262) 723-8044
Email: jensen.olson@elknet.net

Scale in Feet
1" = 20'

Survey Date: May 27, 2010.
Revisions: