

Plat of Survey


of

**Lot 1, the Southeasterly 2/3 of Lot 2,
Lot 32 and Lot 33 all in Block 43
of the Fourth Map of Interlaken,**


a subdivision located in the Northeast 1/4 of Section 11, Town 3 North, Range 16 East, Town of Sugar Creek, Walworth County, Wisconsin.

Surveyed for: **Mary Gustafson**
3149 South Superior Street
Milwaukee, Wisconsin. 53207

Witness Corner
Section 11-3-16
(N. 273,370.17)
(E. 2,383,461.03)

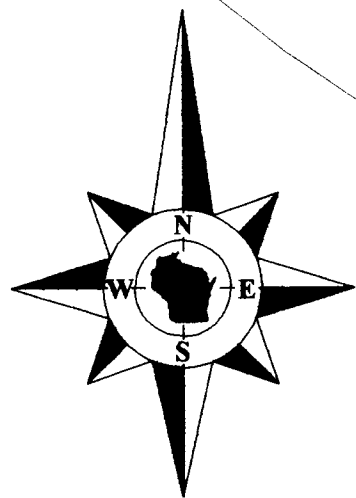

Bearings referenced to the plat of Interlaken.

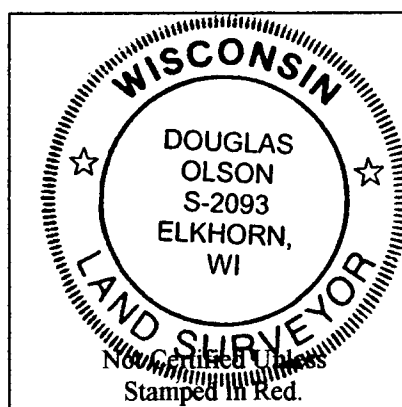

Notes:



- 1) This survey plat is not certified unless signed and sealed in red ink.
- 2) This survey is subject to Wisconsin lien laws. This Plat of Survey is the notice of intent to file lien. Lien waiver required.

Copyright 2010 by Jensen & Olson Land Surveying, LLC.

All rights reserved. No part of this survey plat may be reproduced or transmitted in any form by any means - graphic, electronic, or mechanical, including photocopying, tracing, or information storage and retrieval systems - without permission in writing from Douglas G. Olson, Jensen & Olson Land Surveying, LLC.

I, Douglas G. Olson, Wisconsin Registered Land Surveyor, do hereby certify that this survey was performed by me, or under my direction in full compliance with the owner's/agent's instructions and Chapter A-E 7 of the Wisconsin Administrative Code "Minimum Standards for Property Surveys"; and that this map is an accurate representation thereof to the best of my knowledge and belief.

Douglas G. Olson
Wisconsin Registered Land Surveyor - 2093

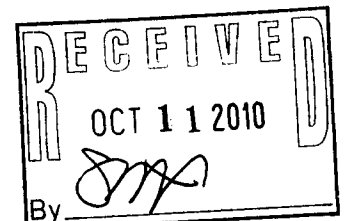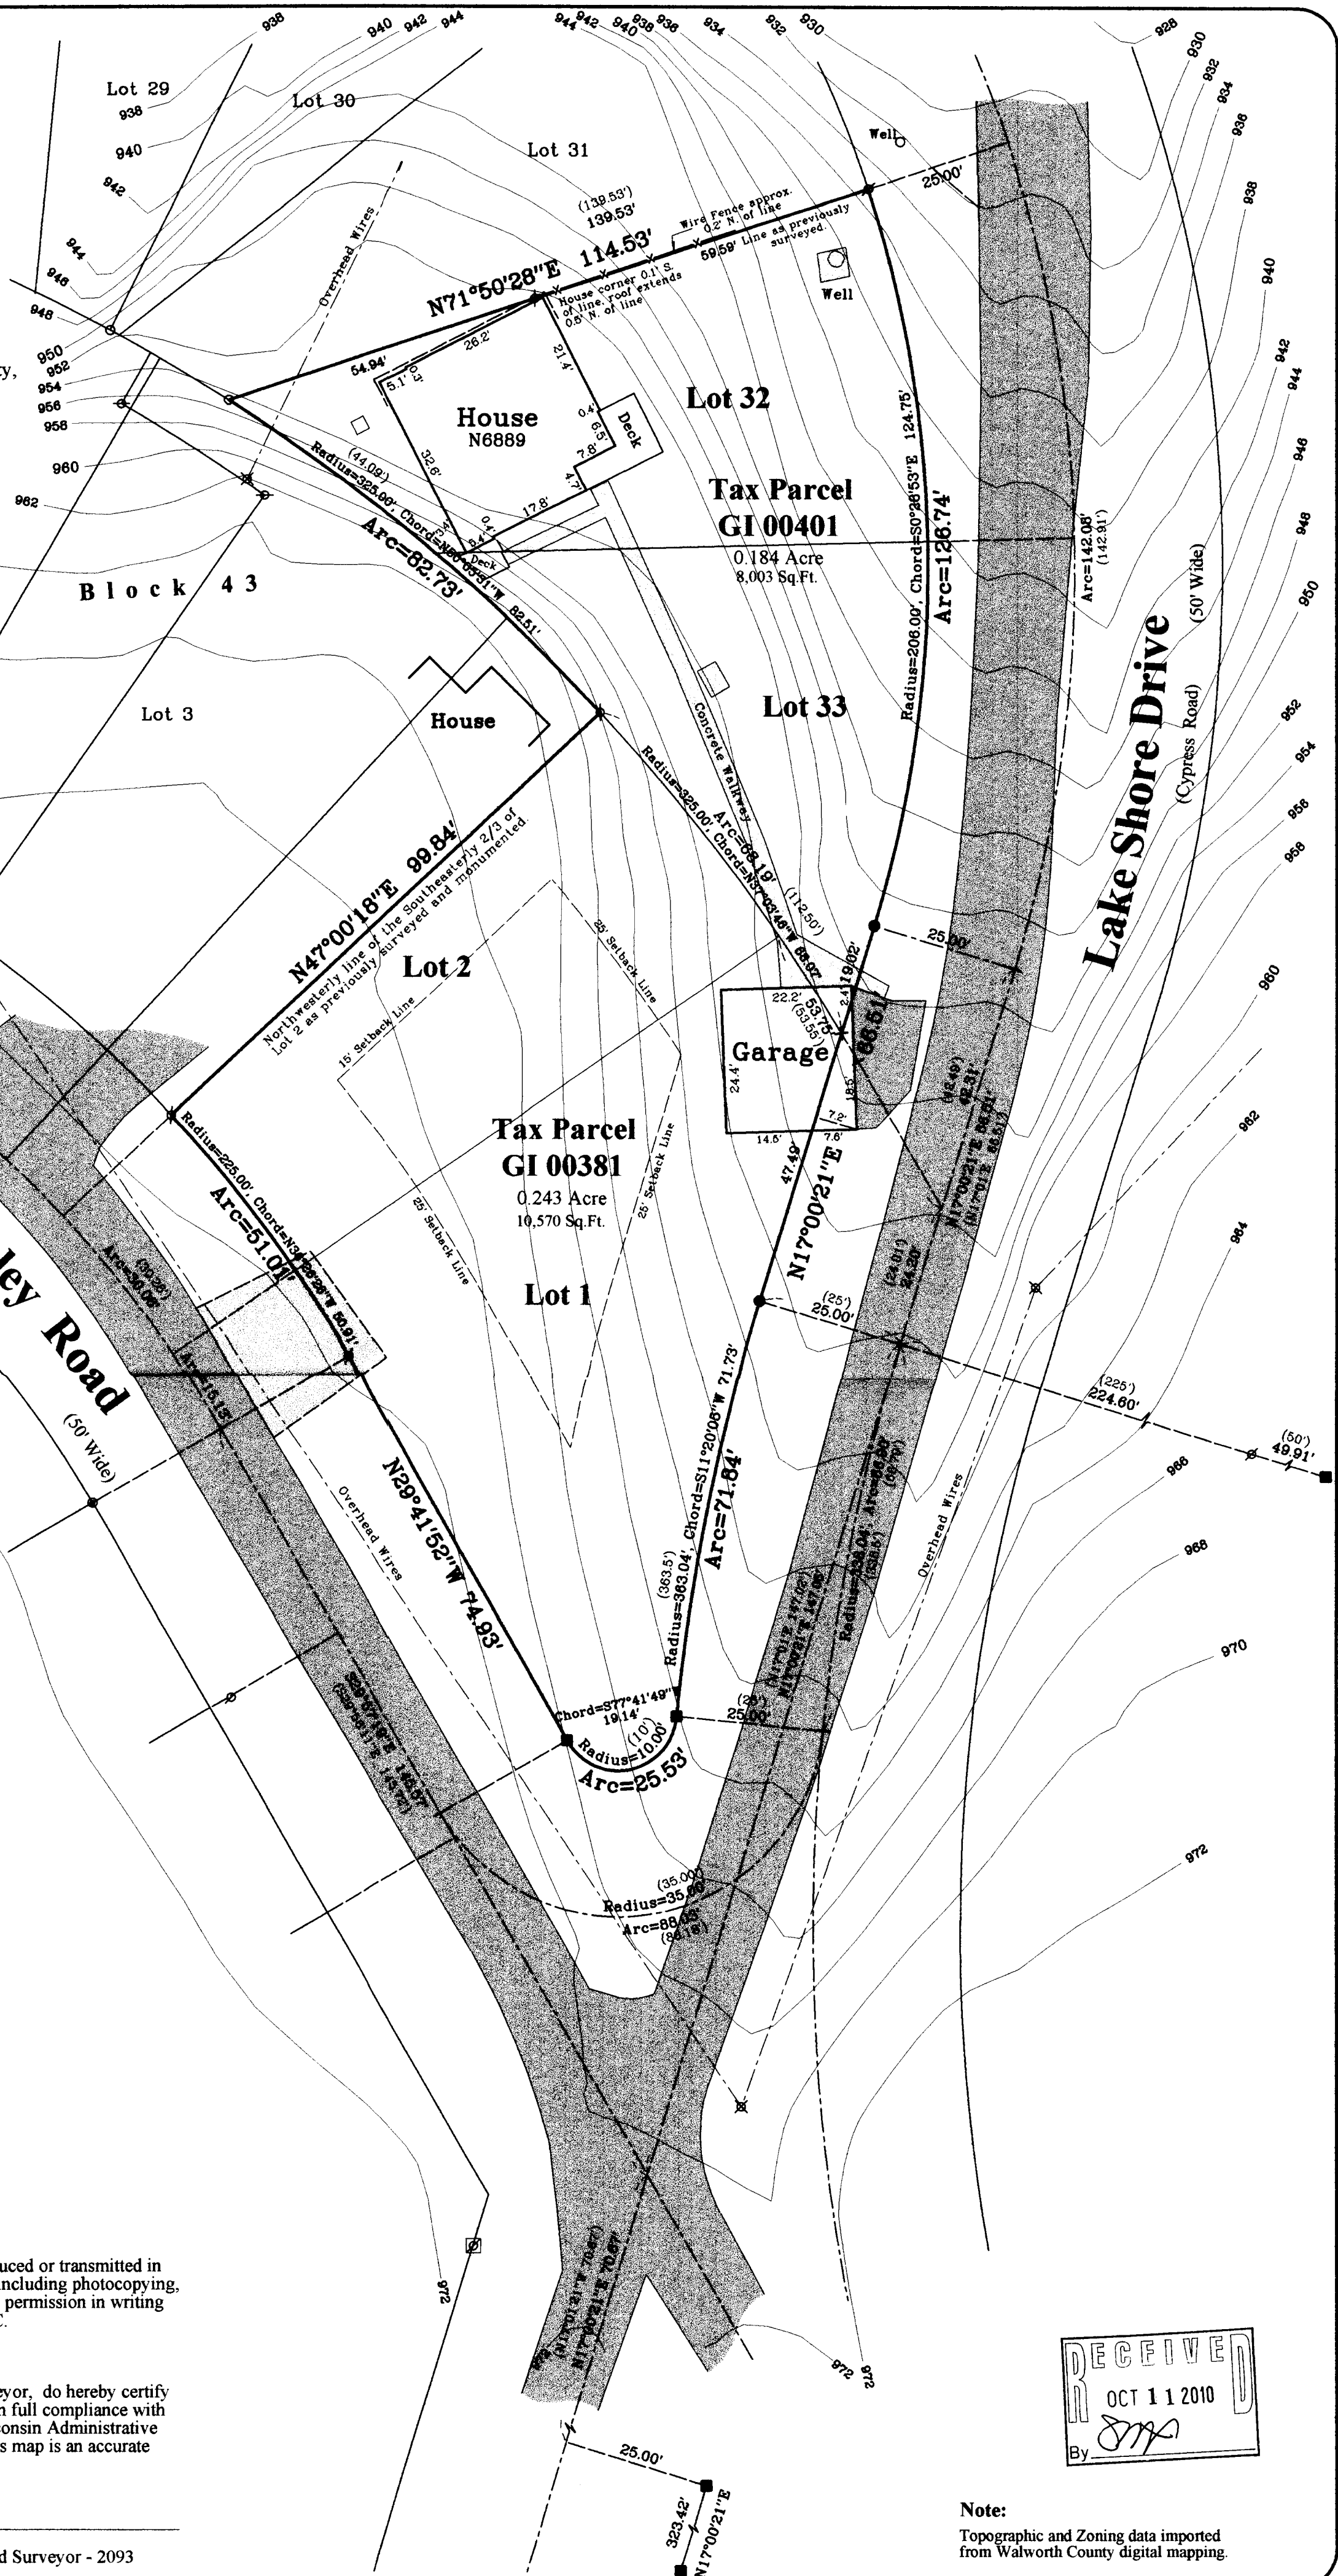

Note:
Topographic and Zoning data imported from Walworth County digital mapping.

2009.092

Sheet 1 of 1 Sheets

Drawing Name: l3nr16e-2009092-2009092Plat.scj

Job Reference Number

2009.092

Legend

- Found Concrete Monument
- Found Iron Pipe
- Found Iron Rod
- Set Iron Rod, 3/4" dia.
- Recorded Information
- Utility Pole
- Asphalt Surface
- Concrete Surface
- Ceased Surface
- Set Chisel Cross

Jensen & Olson Land Surveying, LLC


45 South Wisconsin Street * P.O. Box 322 * Elkhorn, Wisconsin. 53121

Telephone: (262) 723-3434 * Facsimile: (262) 723-8044

Email: jensen.olson@elknet.net

Scale in Feet

1" = 20'

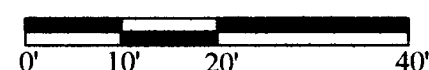

Survey Date: May 27, 2010.
Revisions: No. 1 - County Topo.