

Renamed, see Doc. No. 526337.

(Evergreen Road)

Babcock Road

(50' Wide)

Plat of Survey


of

**Lots 8, 21 and the Reserved Lot in Block 75
in the 5th Map of Interlaken,**


a subdivision located in the Northwest 1/4 of Section 14, Town 3 North,
Range 16 East, Town of Sugar Creek, Walworth County, Wisconsin.

EXCEPTING therefrom the North 8 feet.

Surveyed for: **Lance & Tracy Cromeey**
W1301 County Road L
East Troy, Wisconsin. 53120

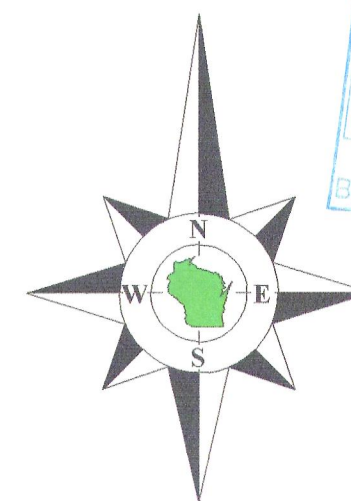

Bearings reference to previous
surveys of record.

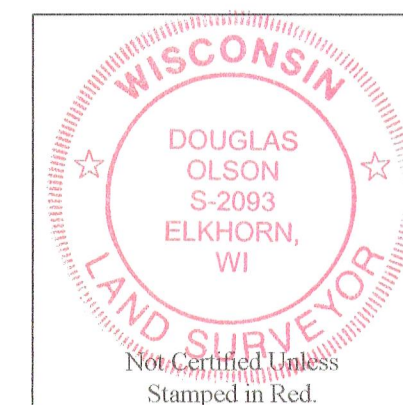

Notes:

- 1) This survey plat is not certified unless signed and sealed in red ink.
- 2) This survey is subject to Wisconsin lien laws. This Plat of Survey is the notice of intent to file lien. Lien waiver required.

Copyright 2011 by Jensen & Olson Land Surveying, LLC.


All rights reserved. No part of this survey plat may be reproduced or transmitted in any form by any means - graphic, electronic, or mechanical, including photocopying, tracing, or information storage and retrieval systems - without permission in writing from Douglas G. Olson, Jensen & Olson Land Surveying, LLC.

I hereby certify that I have surveyed the above described property and the map hereon is correct to the best of my professional knowledge and belief and shows the size and location of the property, its exterior boundaries, the location and dimensions of all visible structures thereon, boundary fences, apparent easements and roadways and visible encroachments, if any.

This survey is made for the exclusive use of the present owners of the property, and also those who purchase, mortgage or guarantee title thereto, within one year from the date hereof.

Douglas G. Olson
Wisconsin Registered Land Surveyor - 2093

Survey Date: Sept. 16, 2011.
Revisions:

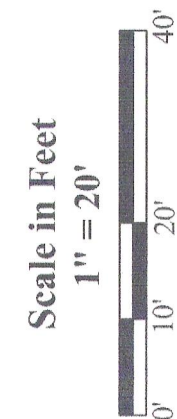

Jensen & Olson Land Surveying, LLC

45 South Wisconsin Street * P.O. Box 322 * Elkhorn, Wisconsin. 53121
Telephone: (262) 723-3434 * Facsimile: (262) 723-8044
Email: jensen.olson@elknet.net

Legend

- Found Iron Rod
- () Recorded Information
- ▣ Utility Box or Pedestal
- ◇ PVC Vent or Cap
- ▨ Asphalt Surface
- ▩ Concrete Surface


Sheet 1 of 1 Sheets

Drawing Name: G:\16-2011\01-2011\01\Plat.swg

Job Reference Number

2011.101

2011.101

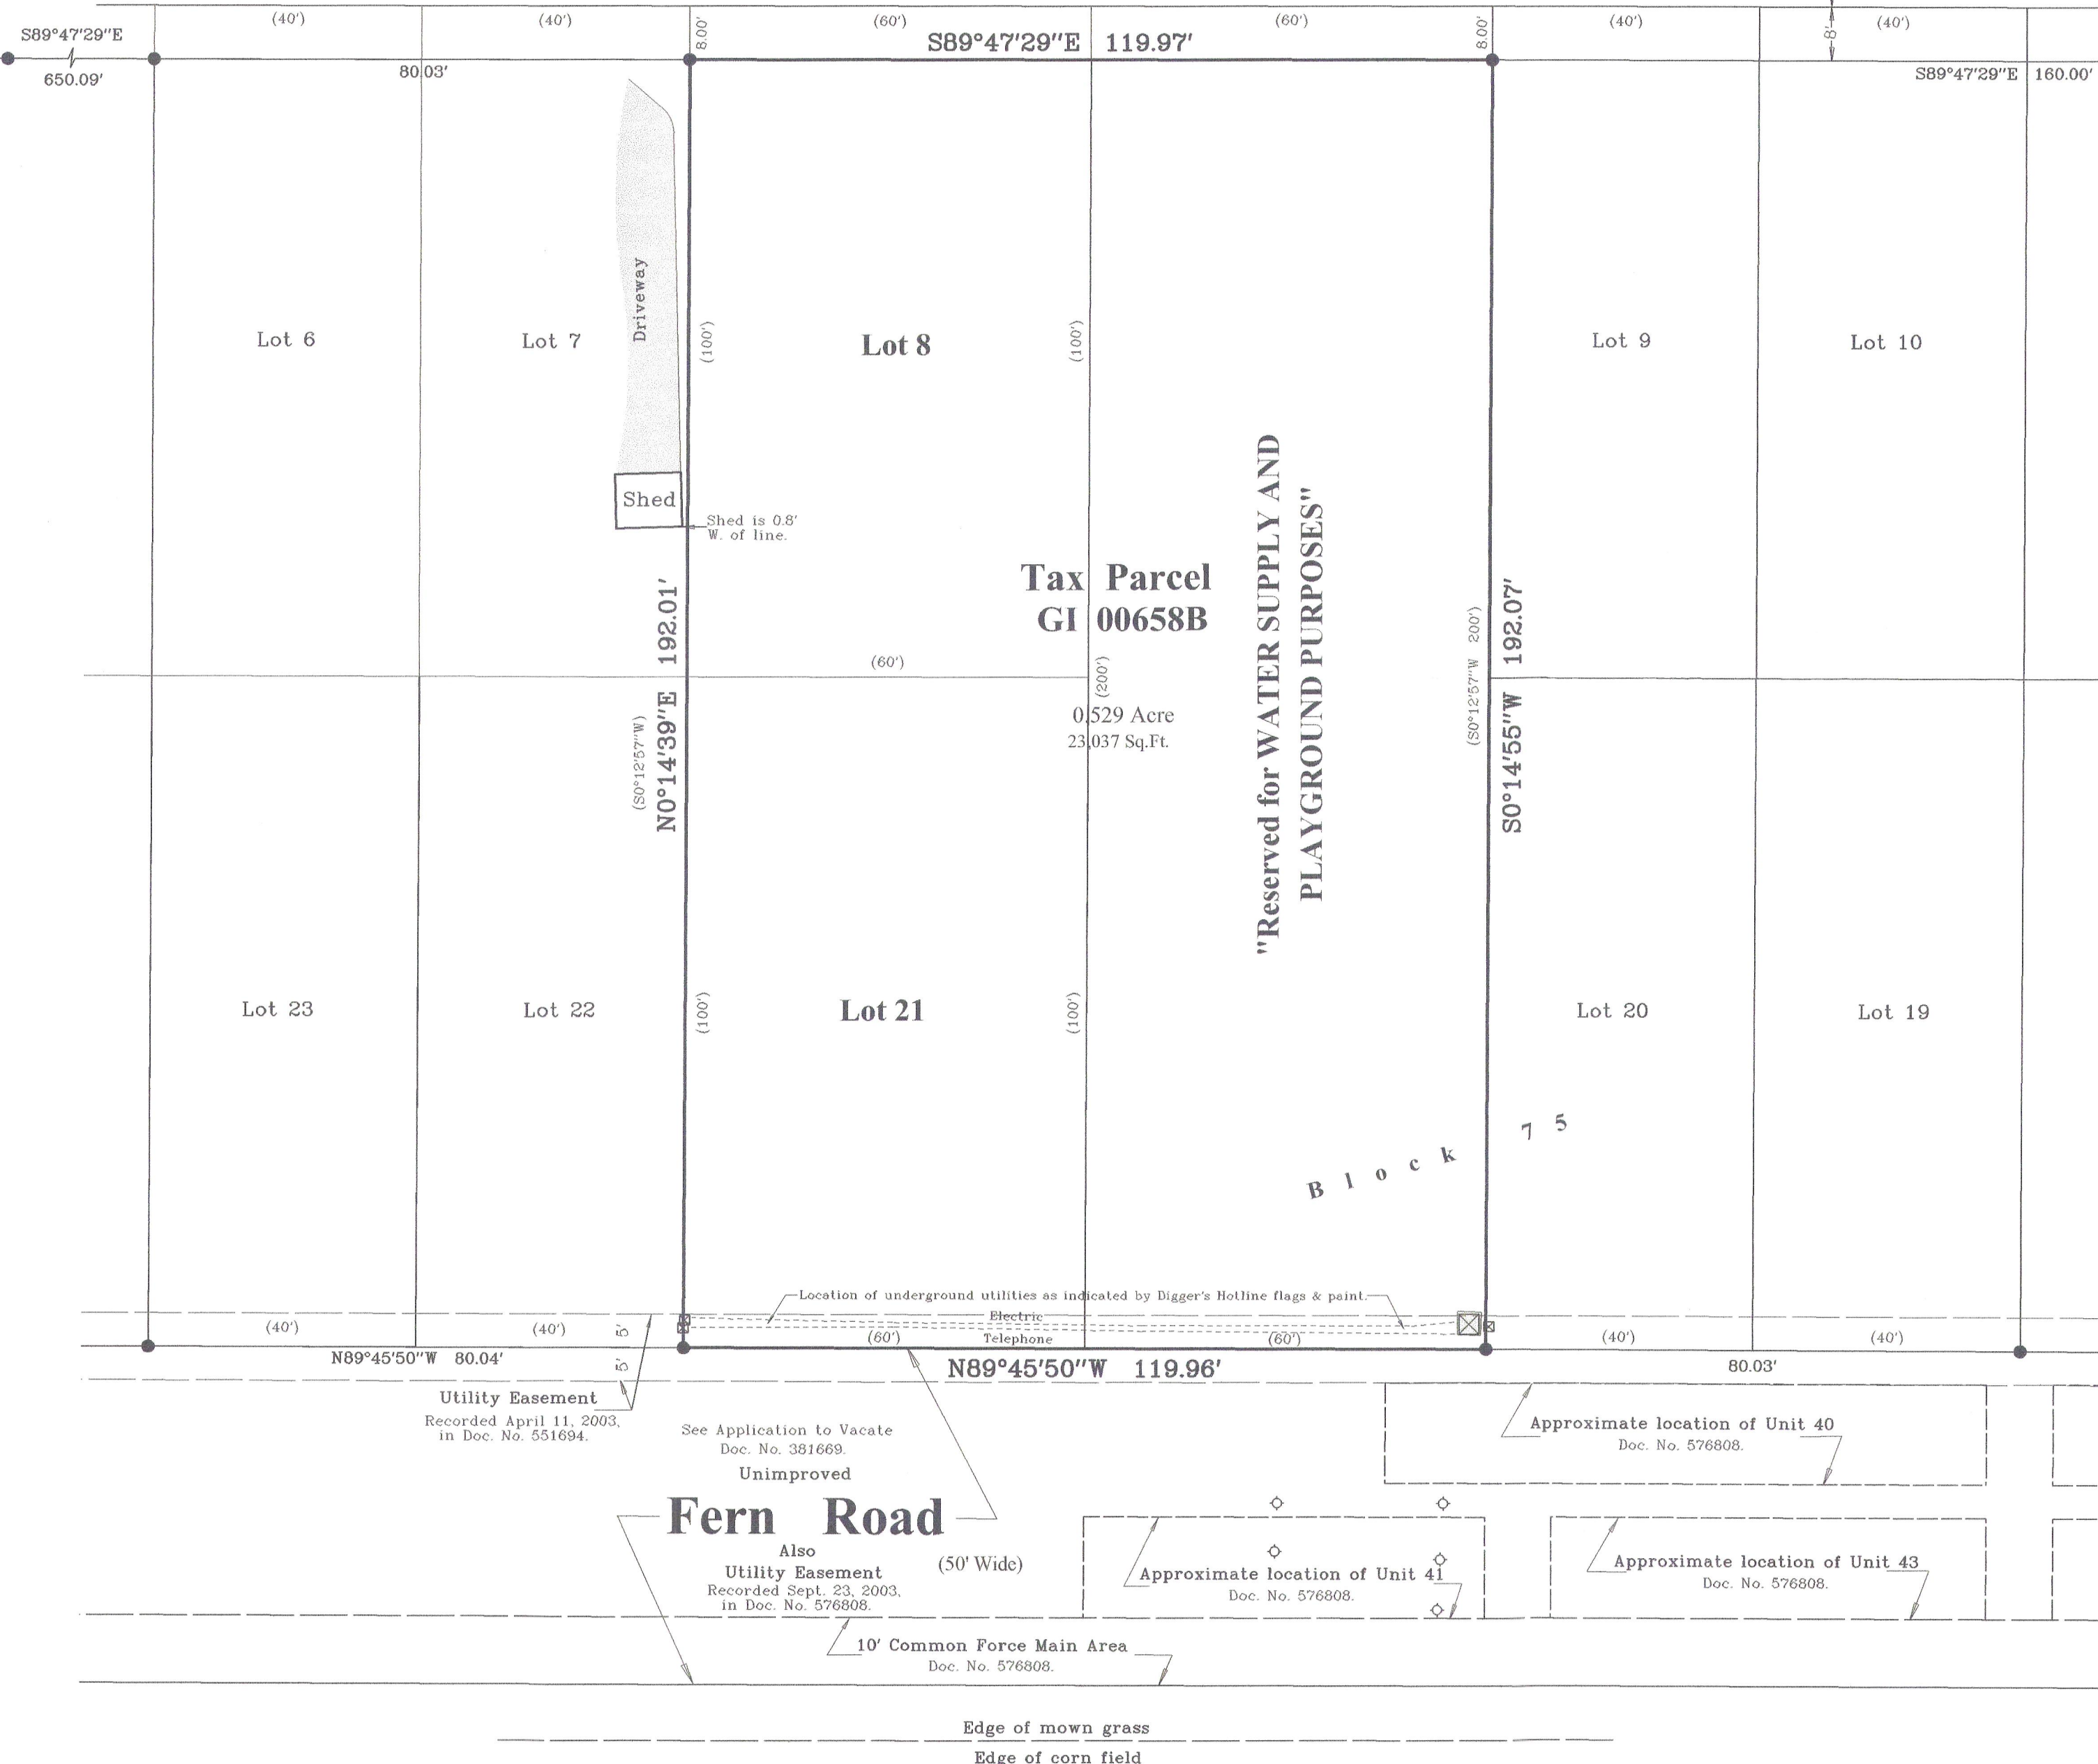

GI 658B

316-2106