

PREPARED FOR:  
LISA VORPAGEL  
N6780 TIPPECANOE TRAIL  
ELKHORN, WI 53121


# PLAT OF SURVEY

-OF-

KROTT SURVEYING INC.

N3705 WILLOW BEND LANE  
LAKE GENEVA WI. 53147  
PHONE # (262)248-3697  
FAX # (262)249-0639

LOTS 5,6,7,8,9,24,25,26,27 AND 28 IN BLOCK 53 ALL IN INTERLAKEN SUBDIVISION  
4th, MAP, TOWN OF SUGAR CREEK, WALWORTH COUNTY, WISCONSIN.

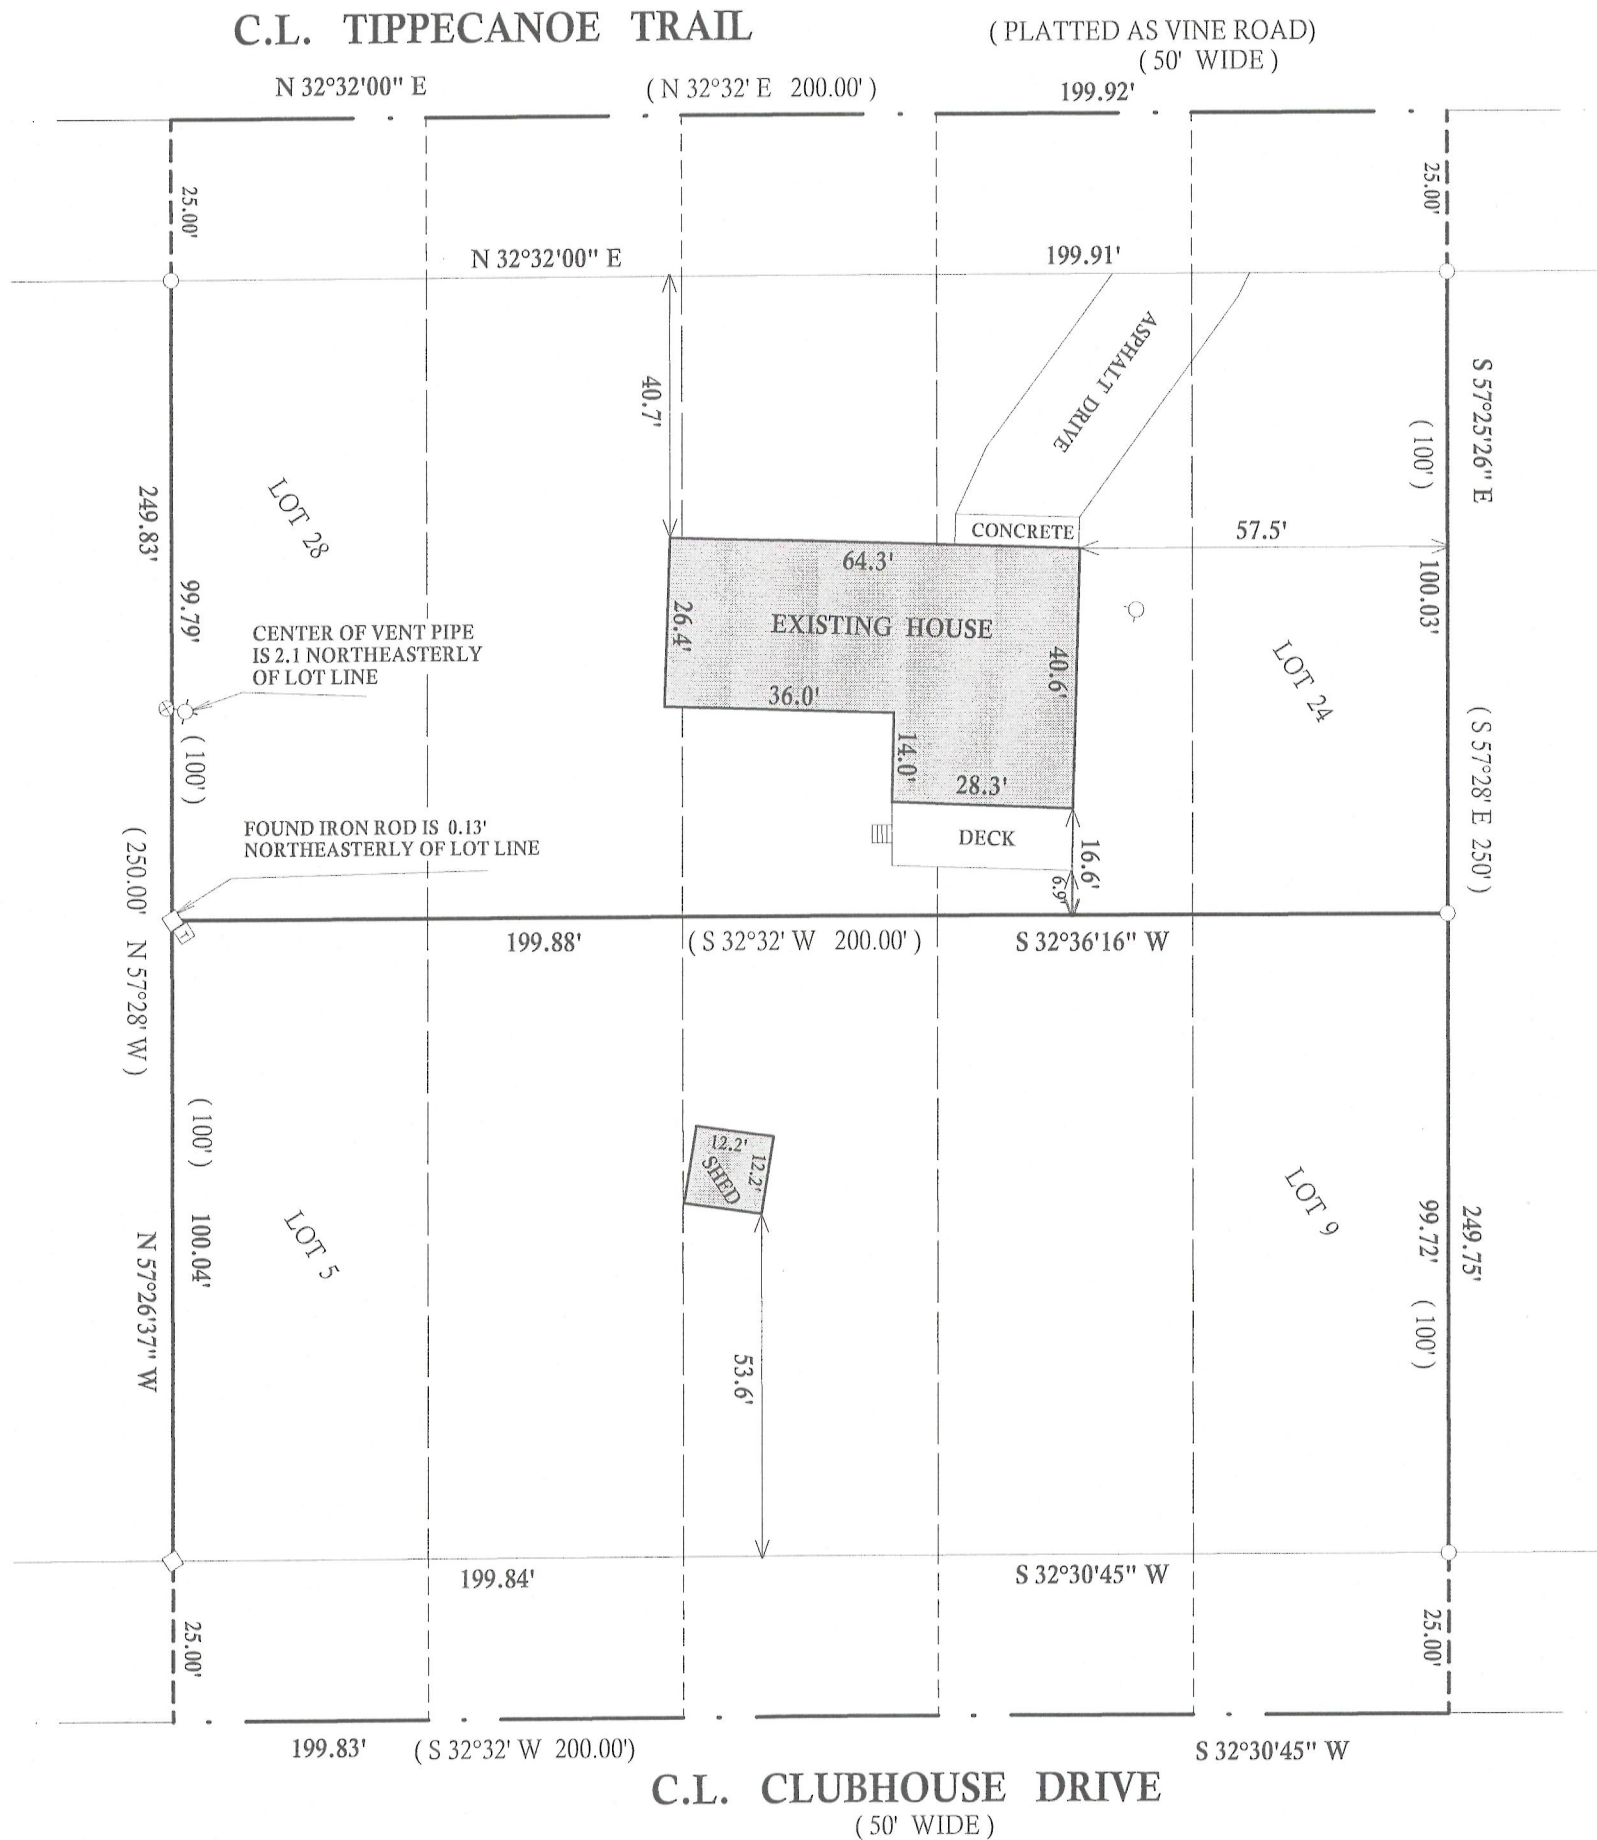


## LEGEND

- WELL
- ⊗ VENT
- ⊕ CONCRETE ACCESS COVER
- FOUND IRON PIPE
- ◇ FOUND IRON BAR
- ◆ TRANSFORMER

(XX) RECORDED AS

JOB # 12-103 TAX ID # GI 478A & GI00483A


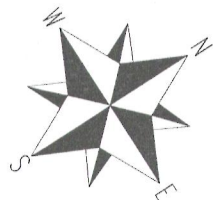


SCALE 1" = 30'

BEARINGS REFERENCED TO THE RECORD PLAT

I have surveyed the above-described property and the above map is a true representation thereof and shows the size and location of the property, its exterior boundaries, the location and dimensions of all structures thereon, fences apparent easements and roadways and visible encroachments, if any.

This survey is made for the exclusive use of the present owners of the property, and also those who purchase, mortgage, or insure the title thereto within one (1) year from date hereof; and as to them I warrant the accuracy of said survey map.

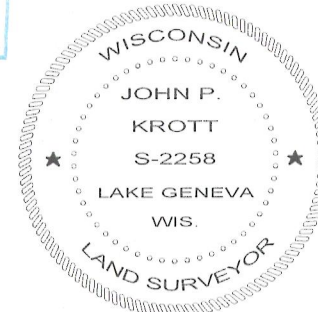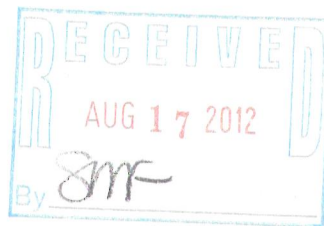

DATED THIS 2nd, DAY OF AUGUST, 2012

*John P. Krott*

JOHN KROTT S - 2258  
Wisconsin Registered Land Surveyor  
(original if signed in red)

316-2122