

PREPARED FOR:
LISA VORPAGEL
N6780 TIPPECANOE TRAIL
ELKHORN, WI 53121


PLAT OF SURVEY

-OF-

KROTT SURVEYING INC.


N3705 WILLOW BEND LANE
LAKE GENEVA WI. 53147
PHONE # (262)248-3697
FAX # (262)249-0639

LOTS 5,6,7,8,9,24,25,26,27 AND 28 IN BLOCK 53 ALL IN INTERLAKEN SUBDIVISION
4th, MAP, TOWN OF SUGAR CREEK, WALWORTH COUNTY, WISCONSIN.

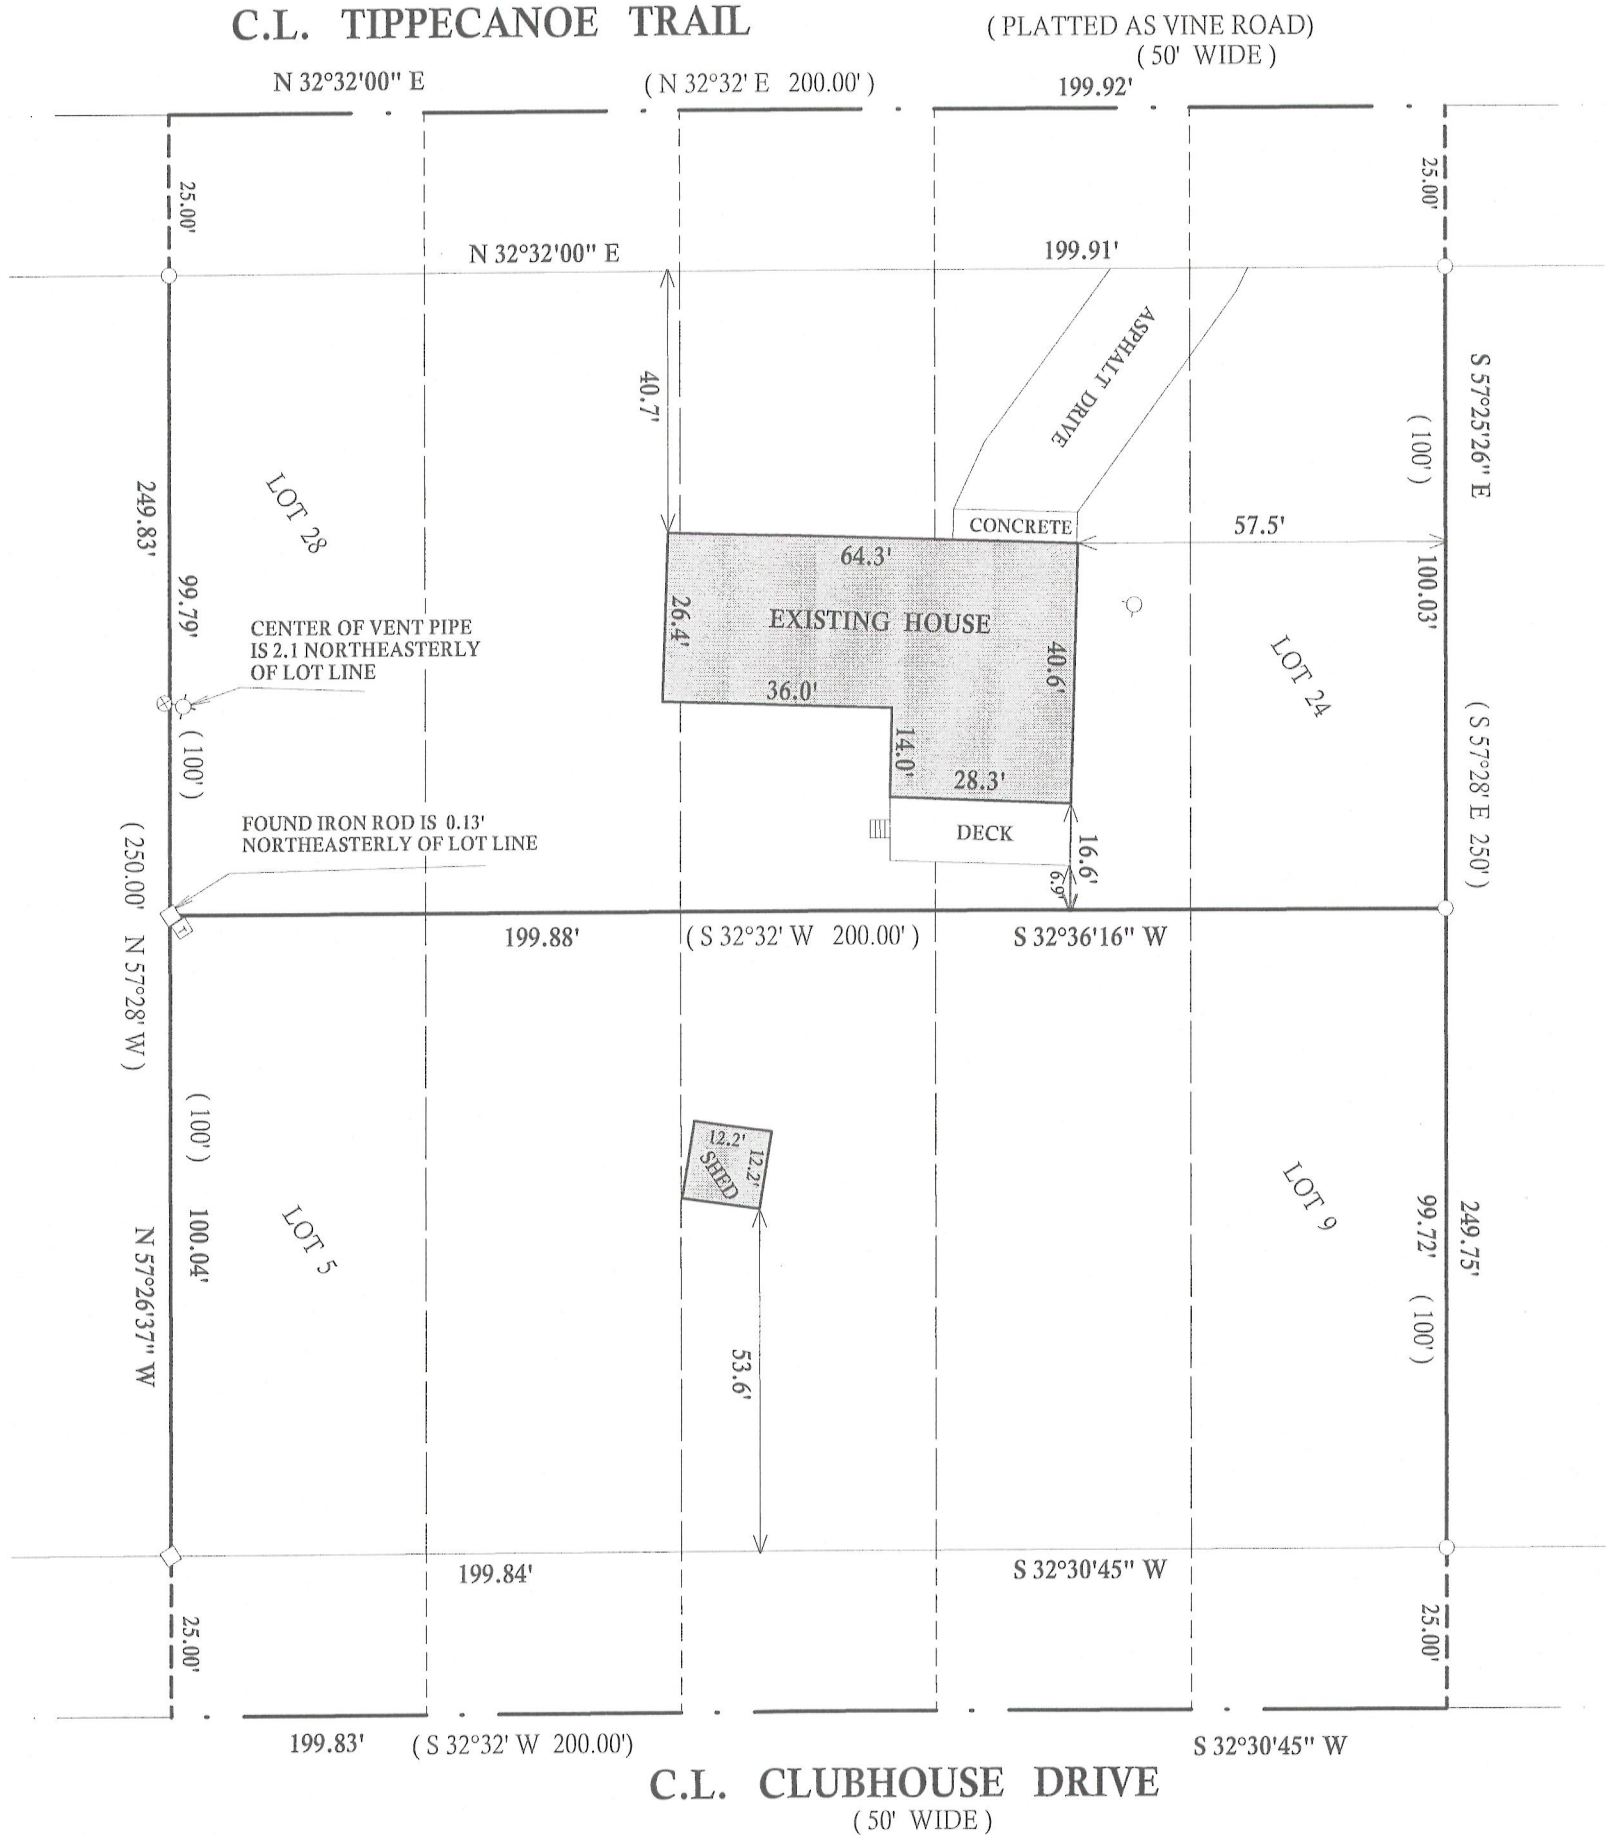

LEGEND

- WELL
- ⊗ VENT
- ⊕ CONCRETE ACCESS COVER
- FOUND IRON PIPE
- ◇ FOUND IRON BAR
- ◆ TRANSFORMER
- (XX) RECORDED AS

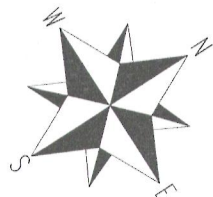


SCALE 1" = 30'

BEARINGS REFERENCED TO THE RECORD PLAT

I have surveyed the above-described property and the above map is a true representation thereof and shows the size and location of the property, its exterior boundaries, the location and dimensions of all structures thereon, fences apparent easements and roadways and visible encroachments, if any.

This survey is made for the exclusive use of the present owners of the property, and also those who purchase, mortgage, or insure the title thereto within one (1) year from date hereof; and as to them I warrant the accuracy of said survey map.

JOB # 12-103 TAX ID # GI 478A & GI00483A

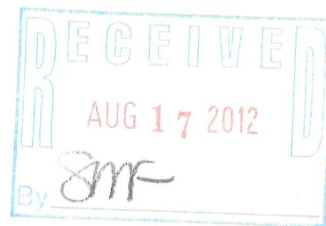

DATED THIS 2nd, DAY OF AUGUST, 2012

John P. Krott

JOHN KROTT S - 2258
Wisconsin Registered Land Surveyor
(original if signed in red)

316-2122