


Geneva Road

North Lake Drive

Tax Parcel
GNLB2 00292A

Width Varies

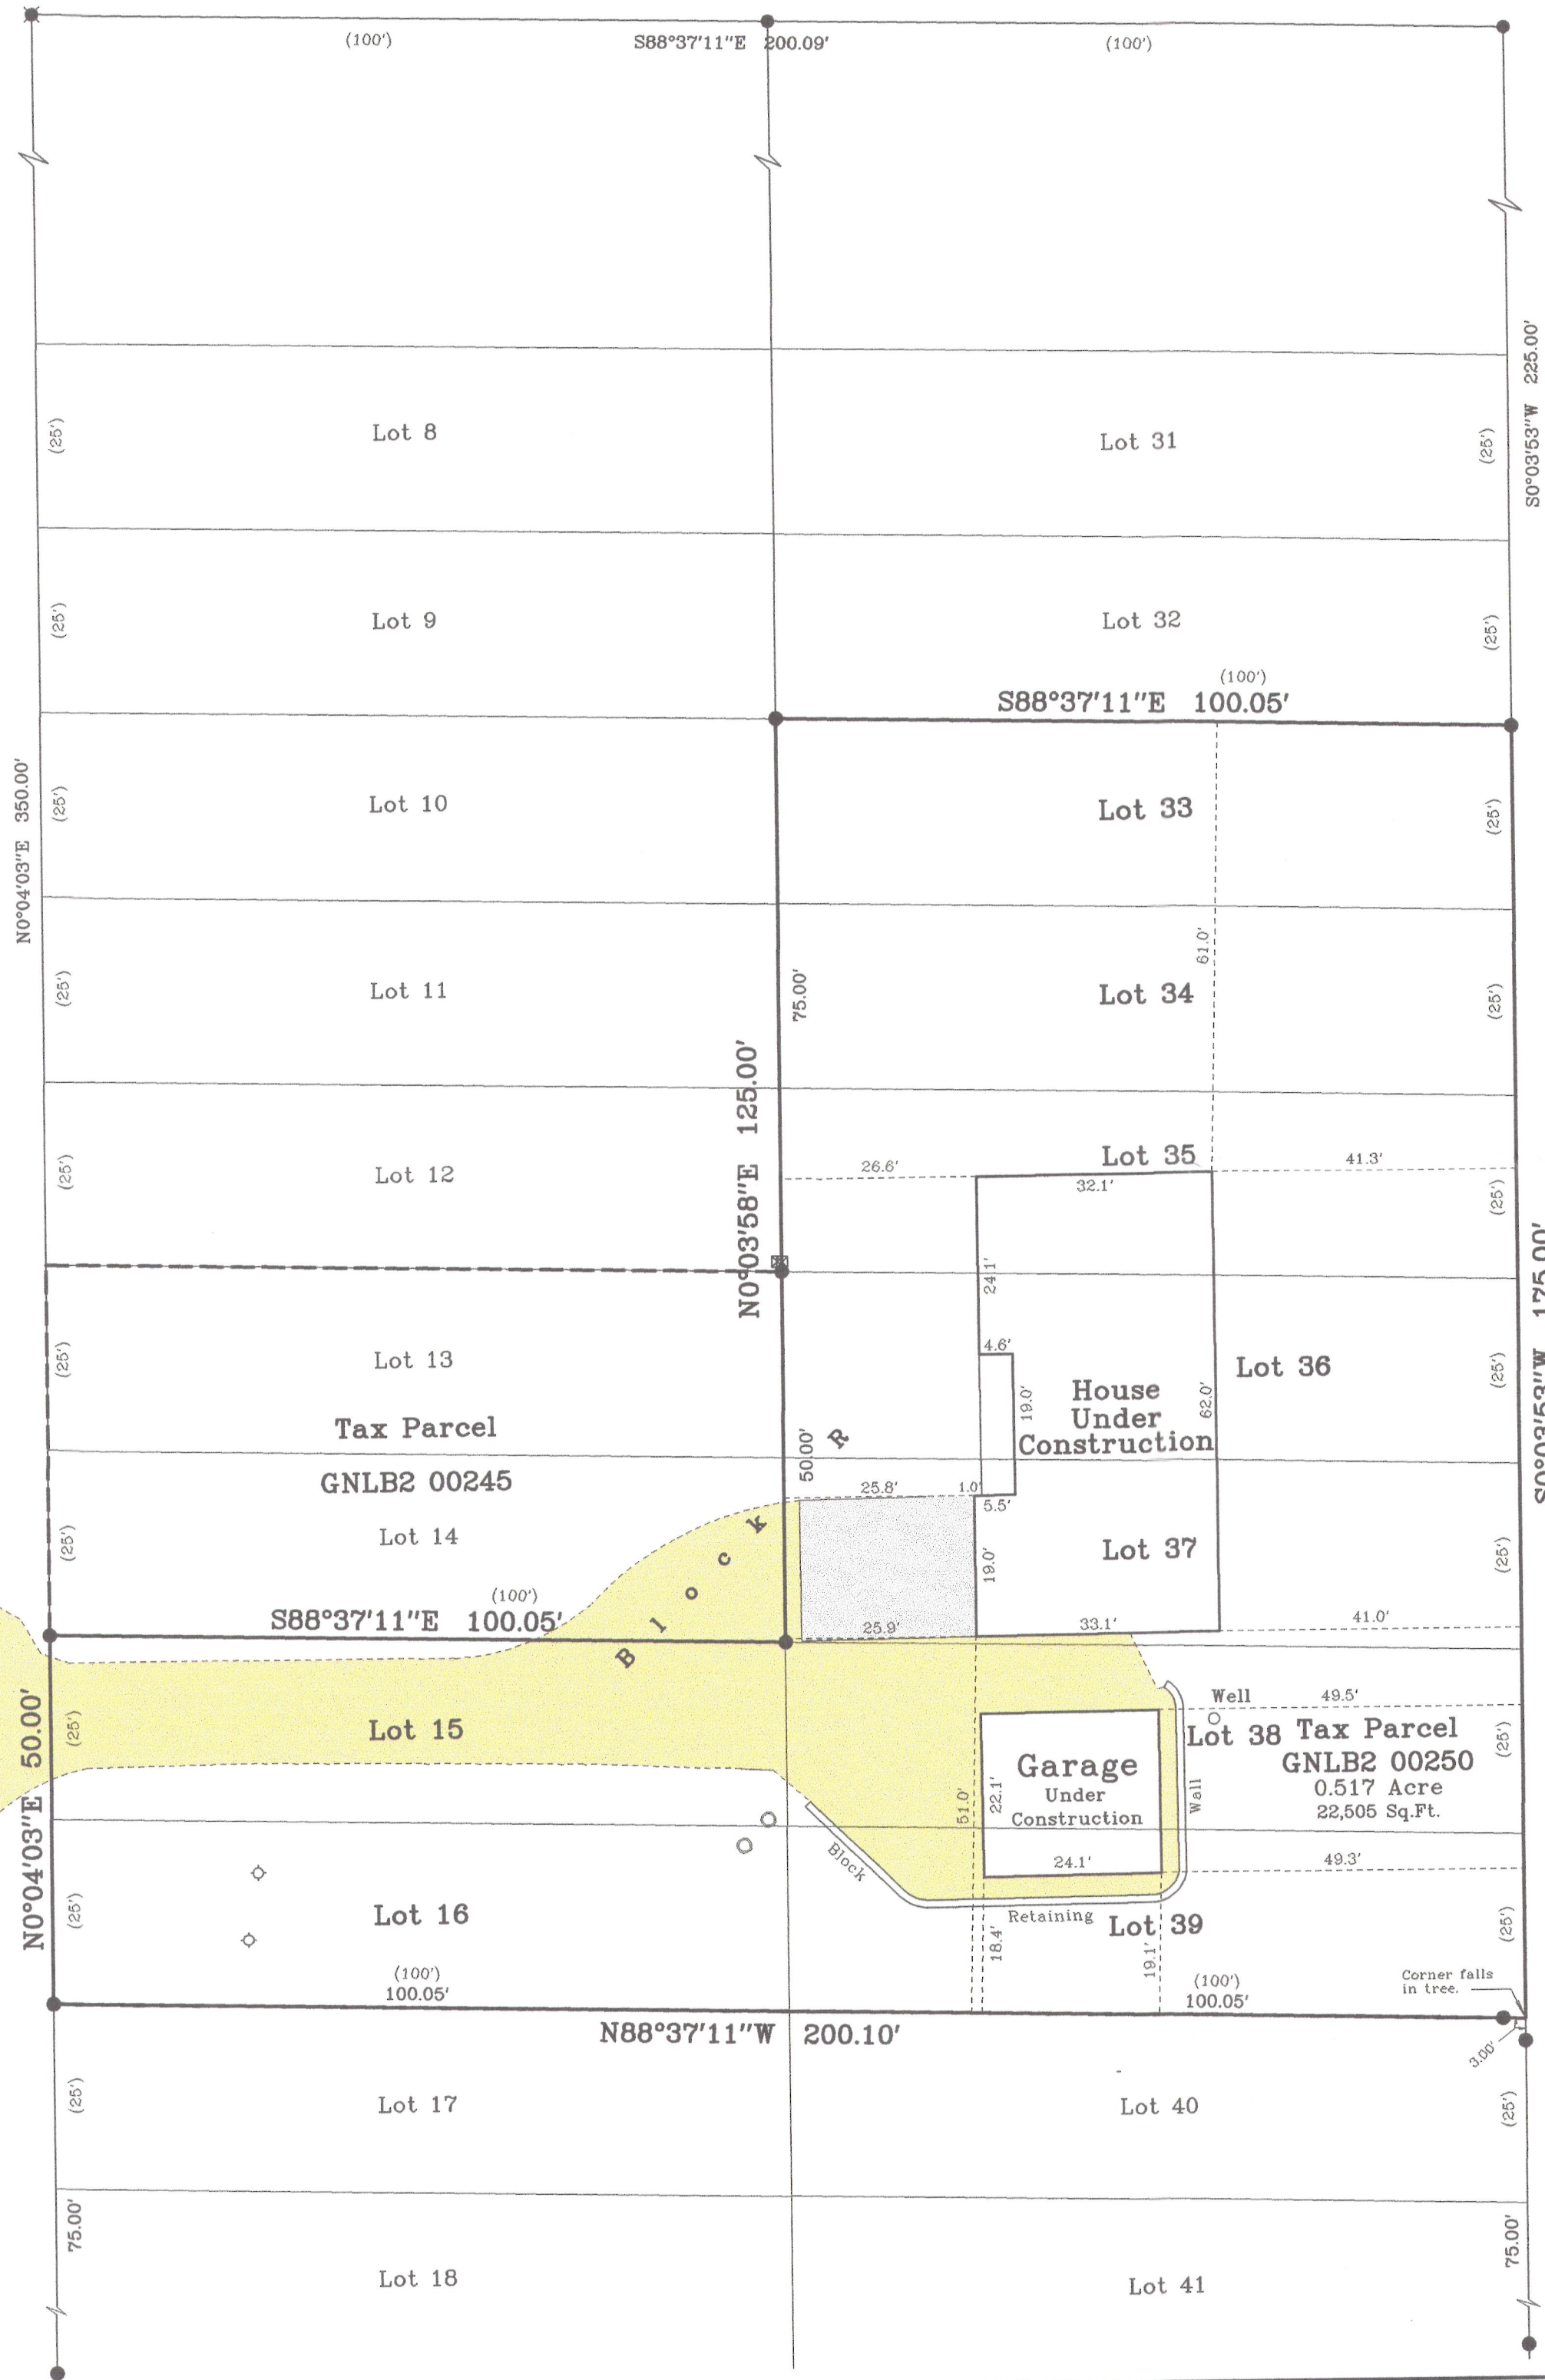


Plat of Survey

of



**Lots 15 and 16 and Lots 33 through 39 of
Block R of North Lake Beach, Tract No. 2,**

located in the Northwest 1/4 of Section 8, Town 3 North, Range
16 East, Town of Sugar Creek, Walworth County, Wisconsin.

Surveyed for: **Mark Polazzo**
N6842 North Lake Drive
Elkhorn, Wisconsin. 53121

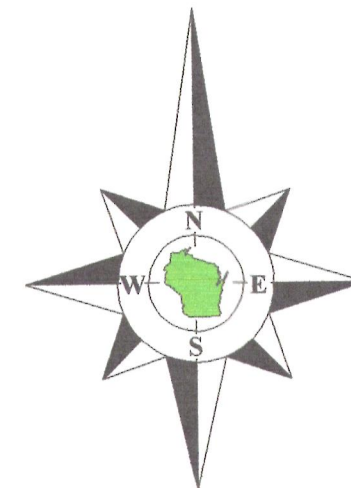

Bearings reference to previous
surveys of record.

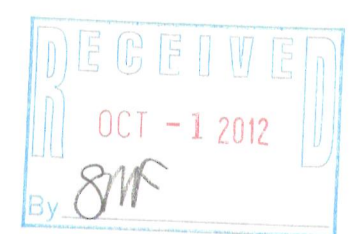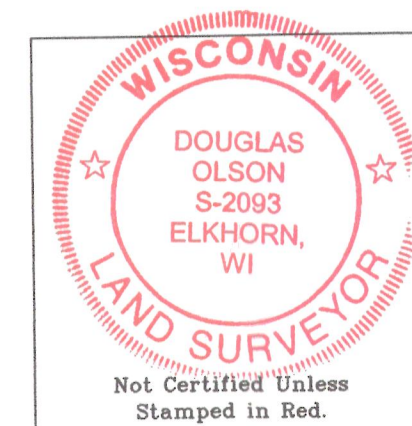

- Notes: 1) This survey plat is not
certified unless signed
and sealed in red ink.
- 2) This survey is subject to Wisconsin lien laws.
This Plat of Survey is the notice of intent
to file lien. Lien waiver required.

Copyright 2007 by Jensen & Olson Land Surveying, LLC.

All rights reserved. No part of this survey plat may be reproduced
or transmitted in any form by any means - graphic, electronic, or
mechanical, including photocopying, tracing, or information storage
and retrieval systems - without permission in writing from Douglas
G. Olson, Jensen & Olson Land Surveying, LLC.

I, Douglas G. Olson, Wisconsin Registered Land Surveyor,
do hereby certify that this survey was performed by me or under my
direction in full compliance with the owner's/agent's instructions
and Chapter A-E 7 of the Wisconsin Administrative Code "Minimum
Standards for Property Surveys"; and that this map is an accurate
representation thereof to the best of my knowledge and belief.

Douglas G. Olson
Wisconsin Registered Land Surveyor - 2093

Jensen & Olson Land Surveying, LLC

45 South Wisconsin Street
P.O. Box 322
Elkhorn, Wisconsin. 53121
Telephone (262) 723-8434
Facsimile (262) 723-8044

Legend

- Found Iron Rod, 3/4" dia.
- Found Spindle
- Recorded Information
- Concrete Cover, Septic Vent
- Utility Box or Pedestal
- Diggers Hotline Flag, Gravel
- Asphalt Surface
- Concrete

Sheet 1 of 1 Sheets

Job Reference Number

2011.094

2011.094

Survey Date: November 13, 2007.

Revisions: No. 1 - Proposed House
No. 2 - Foundation
No. 3 - Proposed Garage
No. 4 - Septic tank, well
Septic & driveway

Scale in Feet

1" = 20'

0' 10' 20' 40'

GNLB2 250

316.2125