

N 01°43'38" W
ASSIGNED WEST LINE LOT 4

Lot 4 Certified Survey Map No. 2656 according to the recorded plat thereof, recorded in Volume 13 of Certified Surveys on page 235 as Document No. 317206 located in the NE 1/4 of Section 6, T3N, R16E, Walworth County, Wisconsin together with an easement for ingress and egress over and across a 66' wide private road as shown on said Certified Survey Map No. 2656.

LOT 3 Tax Key No: GA265600004

(N 88°16'22" E)
N 88°16'09" E

560.98' (561.00')

TC BOX

—66' WDE PRIVATE ROAD TO TERRITORIAL ROAD

(S 01°43'38" E)
S 01°44'26" E
417.18' (417.25'


Δ WELL
85.5'

TRANSFORMER
TC BOX

LOT 4
234,070 S.F.
5.37 ACRES

417.24' (417.25')
N 01°43'38" W

561.08' (561.00')
S 88°15'46" W
(S 88°16'22" W)

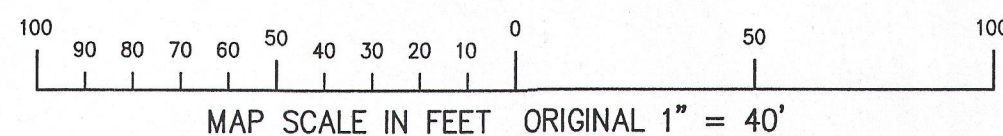

● = FOUND IRON REBAR STAKE
(XXX) = RECORDED AS


NOTE: COPIES OF THIS MAP TO WHICH THE FOLLOWING CERTIFICATE WILL APPLY SHOW THE SURVEYOR'S ORIGINAL SEAL AND SIGNATURE IN RED INK. COPIES BY ANY OTHER MEANS MAY HAVE ALTERATIONS WHICH DO NOT REPRESENT THE SURVEYOR'S WORK PRODUCT.

I HEREBY CERTIFY THAT THE ABOVE DESCRIBED PROPERTY HAS BEEN SURVEYED UNDER MY DIRECTION AND THAT THE ABOVE MAP IS A TRUE REPRESENTATION THEREOF AND SHOWS THE SIZE AND THE PROPERTY, ITS EXTERIOR BOUNDARIES, THE LOCATION OF ALL VISIBLE STRUCTURES AND DIMENSIONS OF PRINCIPAL BUILDINGS THEREON, BOUNDARY FENCES, APPARENT EASEMENTS, ROADWAYS, AND VISIBLE ENCROACHMENTS, IF ANY. THIS SURVEY IS MADE FOR THE USE OF THE PRESENT OWNERS OF THE PROPERTY, AND ALSO THOSE WHO PURCHASE, MORTGAGE, OR GUARANTEE THE TITLE THERETO WITHIN ONE YEAR FROM THE DATE HEREOF.

DATED: JUNE 13, 2013

PETER S. GORDON RLS 2101

RECEIVED
JUN 18 2013
By gle

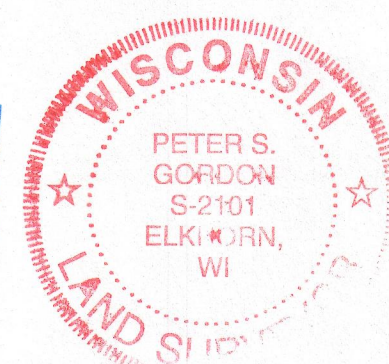

WORK ORDERED FOR
RICK & LISA BRAMMER
C/O THE RAULAND AGENCY
PO BOX 159
WALWORTH, WI. 53184

FARRIS, HANSEN & ASSOCIATES, INC.
ENGINEERING — ARCHITECTURE — SURVEYING
7 RIDGWAY COURT P.O. BOX 437
ELKHORN, WISCONSIN 53121
OFFICE: (262) 723-2098 FAX: (262) 723-5686

REVISIONS

PROJECT NO.	8814
DATE:	06-05-2013
SHEET NO.	1 OF 1

GA 2656-4

316-2143

5/14/2013 X:\Projects\8814\DCAD\SURVEY

Jul 14 2013