



PREPARED FOR
SHERRY GROSSMAN
W5189 WISCONSIN DR.
ELKHORN WI. 53121



KROTT SURVEYING INC.
(262) 248-3697
N 3705 WILLOW BEND LANE
LAKE GENEVA WI. 53147

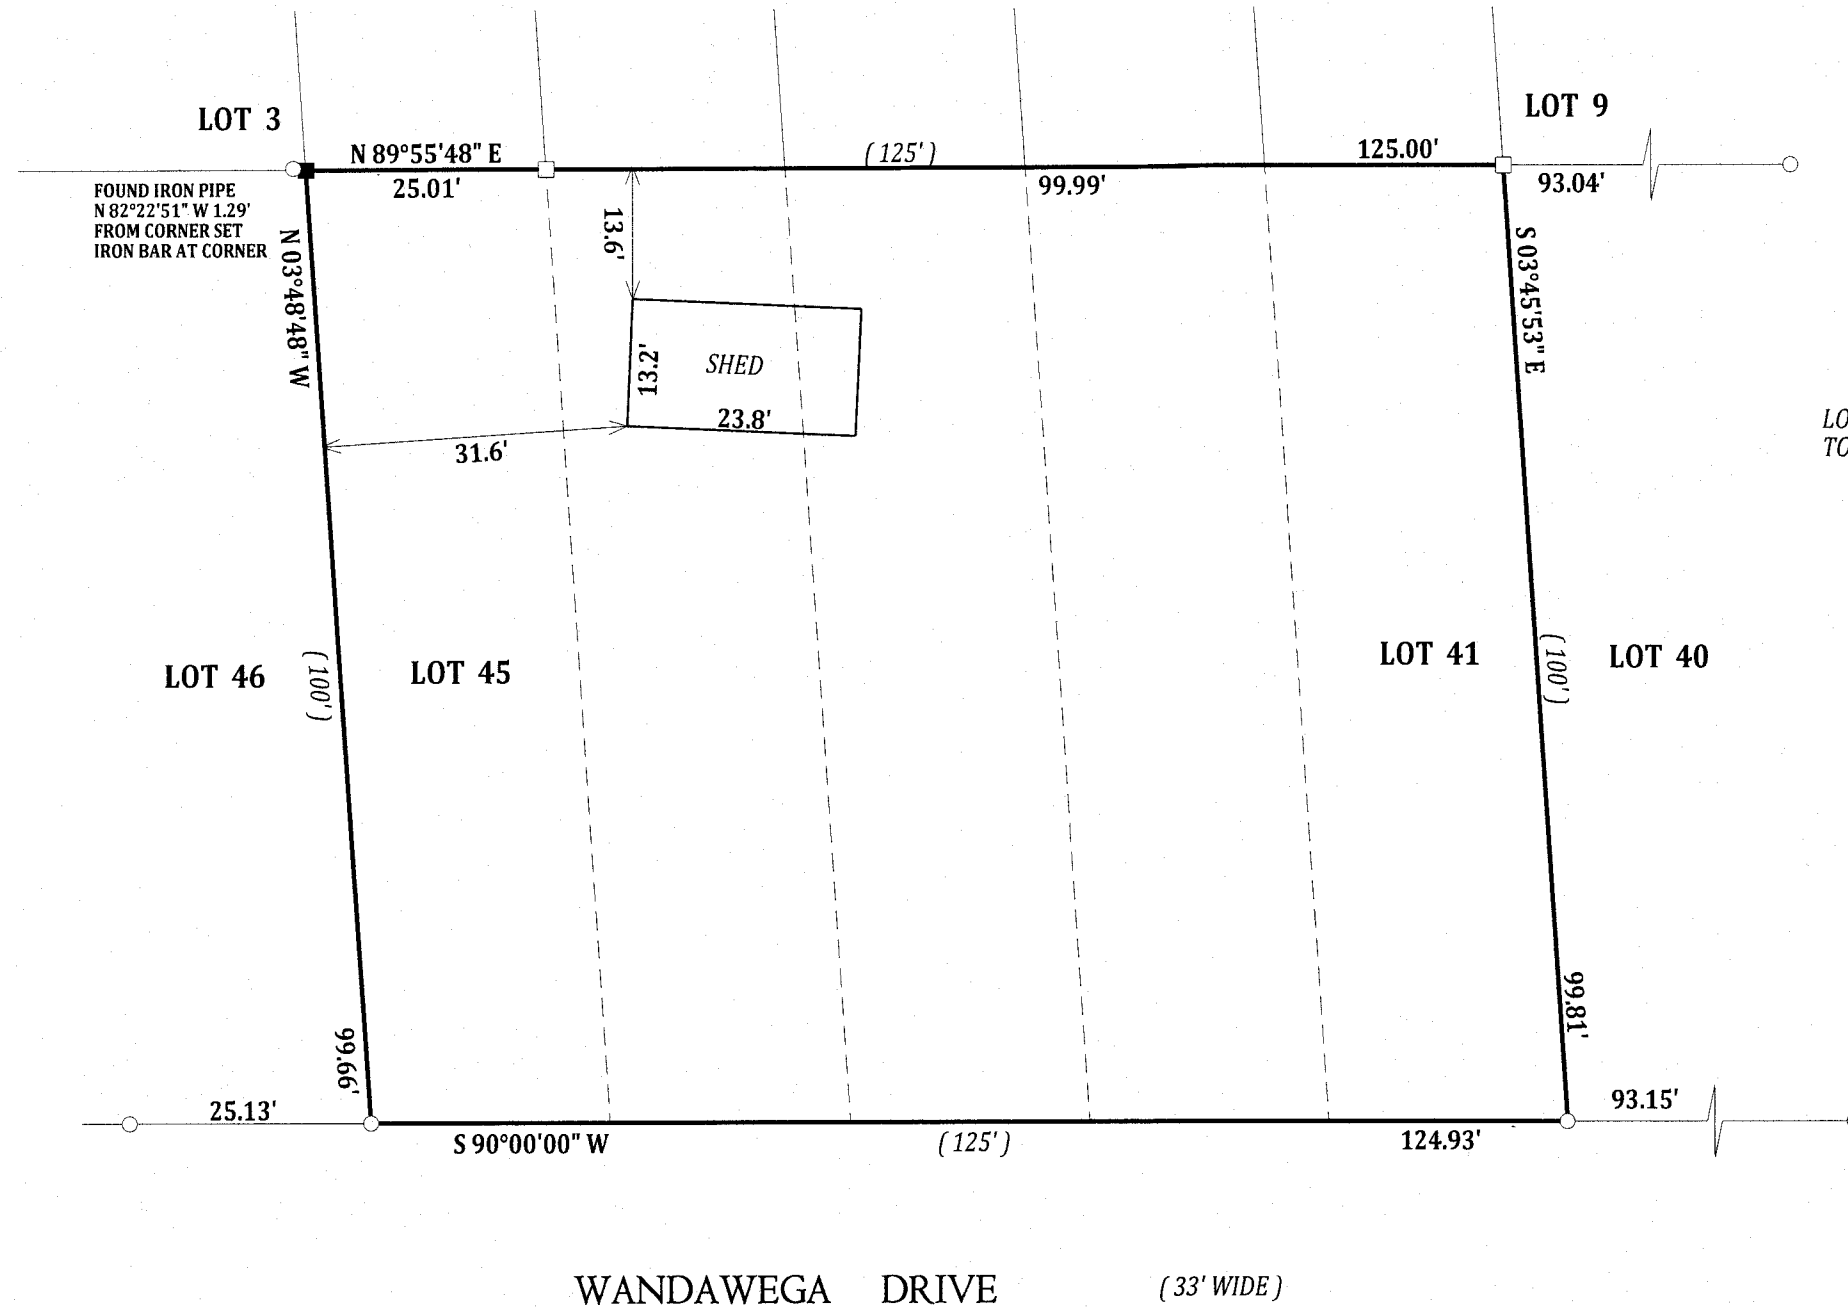

PLAT OF SURVEY OF
LOTS 41, 42, 43, 44 AND 45 ALL IN BLOCK 99, LAKE WANDAWEGA SUBDIVISION
TOWN OF SUGAR CREEK WALWORTH COUNTY, WISCONSIN.

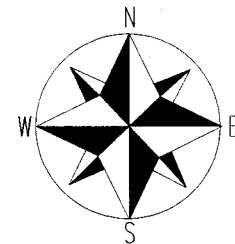

NOTE: BEARINGS ARE REFERENCED TO PREVIOUS SURVEYS OF RECORD

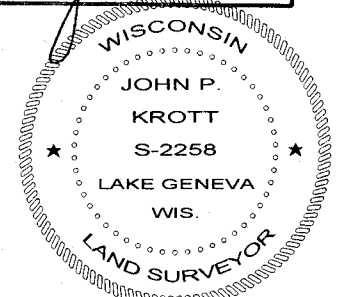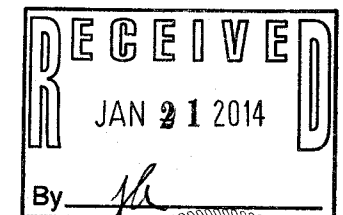

DATED THIS 25th DAY OF OCTOBER 2013

John P. Krott
JOHN P. KROTT S-2258
WISCONSIN REGISTERED LAND SURVEYOR
(NOTE: THIS IS NOT A CERTIFIED COPY
UNLESS SIGNED IN RED INK)

LEGEND

- FOUND IRON PIPE
- FOUND IRON BAR
- SET IRON BAR

(XX) RECORDED AS


TAX ID # GLW00200

JOB # 13-160

I have surveyed the above-described property and the above map is a true representation thereof and shows the size and location of the property, its exterior boundaries, the location and dimensions of all structures thereon, fences apparent easements and roadways and visible encroachments, if any.

This survey is made for the exclusive use of the present owners of the property, and also those who purchase, mortgage, or insure the title thereto within one (1) year from date hereof; and as to them I warrant the accuracy of said survey map.

SCALE 1" = 20'

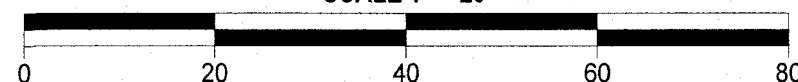

GLW-191

316-2172