



PREPARED FOR
STEVE & PAIGE SAWAR
KEEFE REAL ESTATE
ELKHORN, WI.

PLAT OF SURVEY

- OF -

LOTS 15 - 17 and 23 - 25, BLOCK 3 MAP OF INTERLAKEN A SUBDIVISION, LOCATED IN THE
TOWN OF SUGAR CREEK, WALWORTH COUNTY, WISCONSIN.

PATHFINDER SURVEYING INC.
(formerly)
J.K. SURVEYING INC.
P.O BOX 322
LAKE GENEVA, WI. 53147
WWW.PATHFINDERSURVEYING.NET
262-248-8303

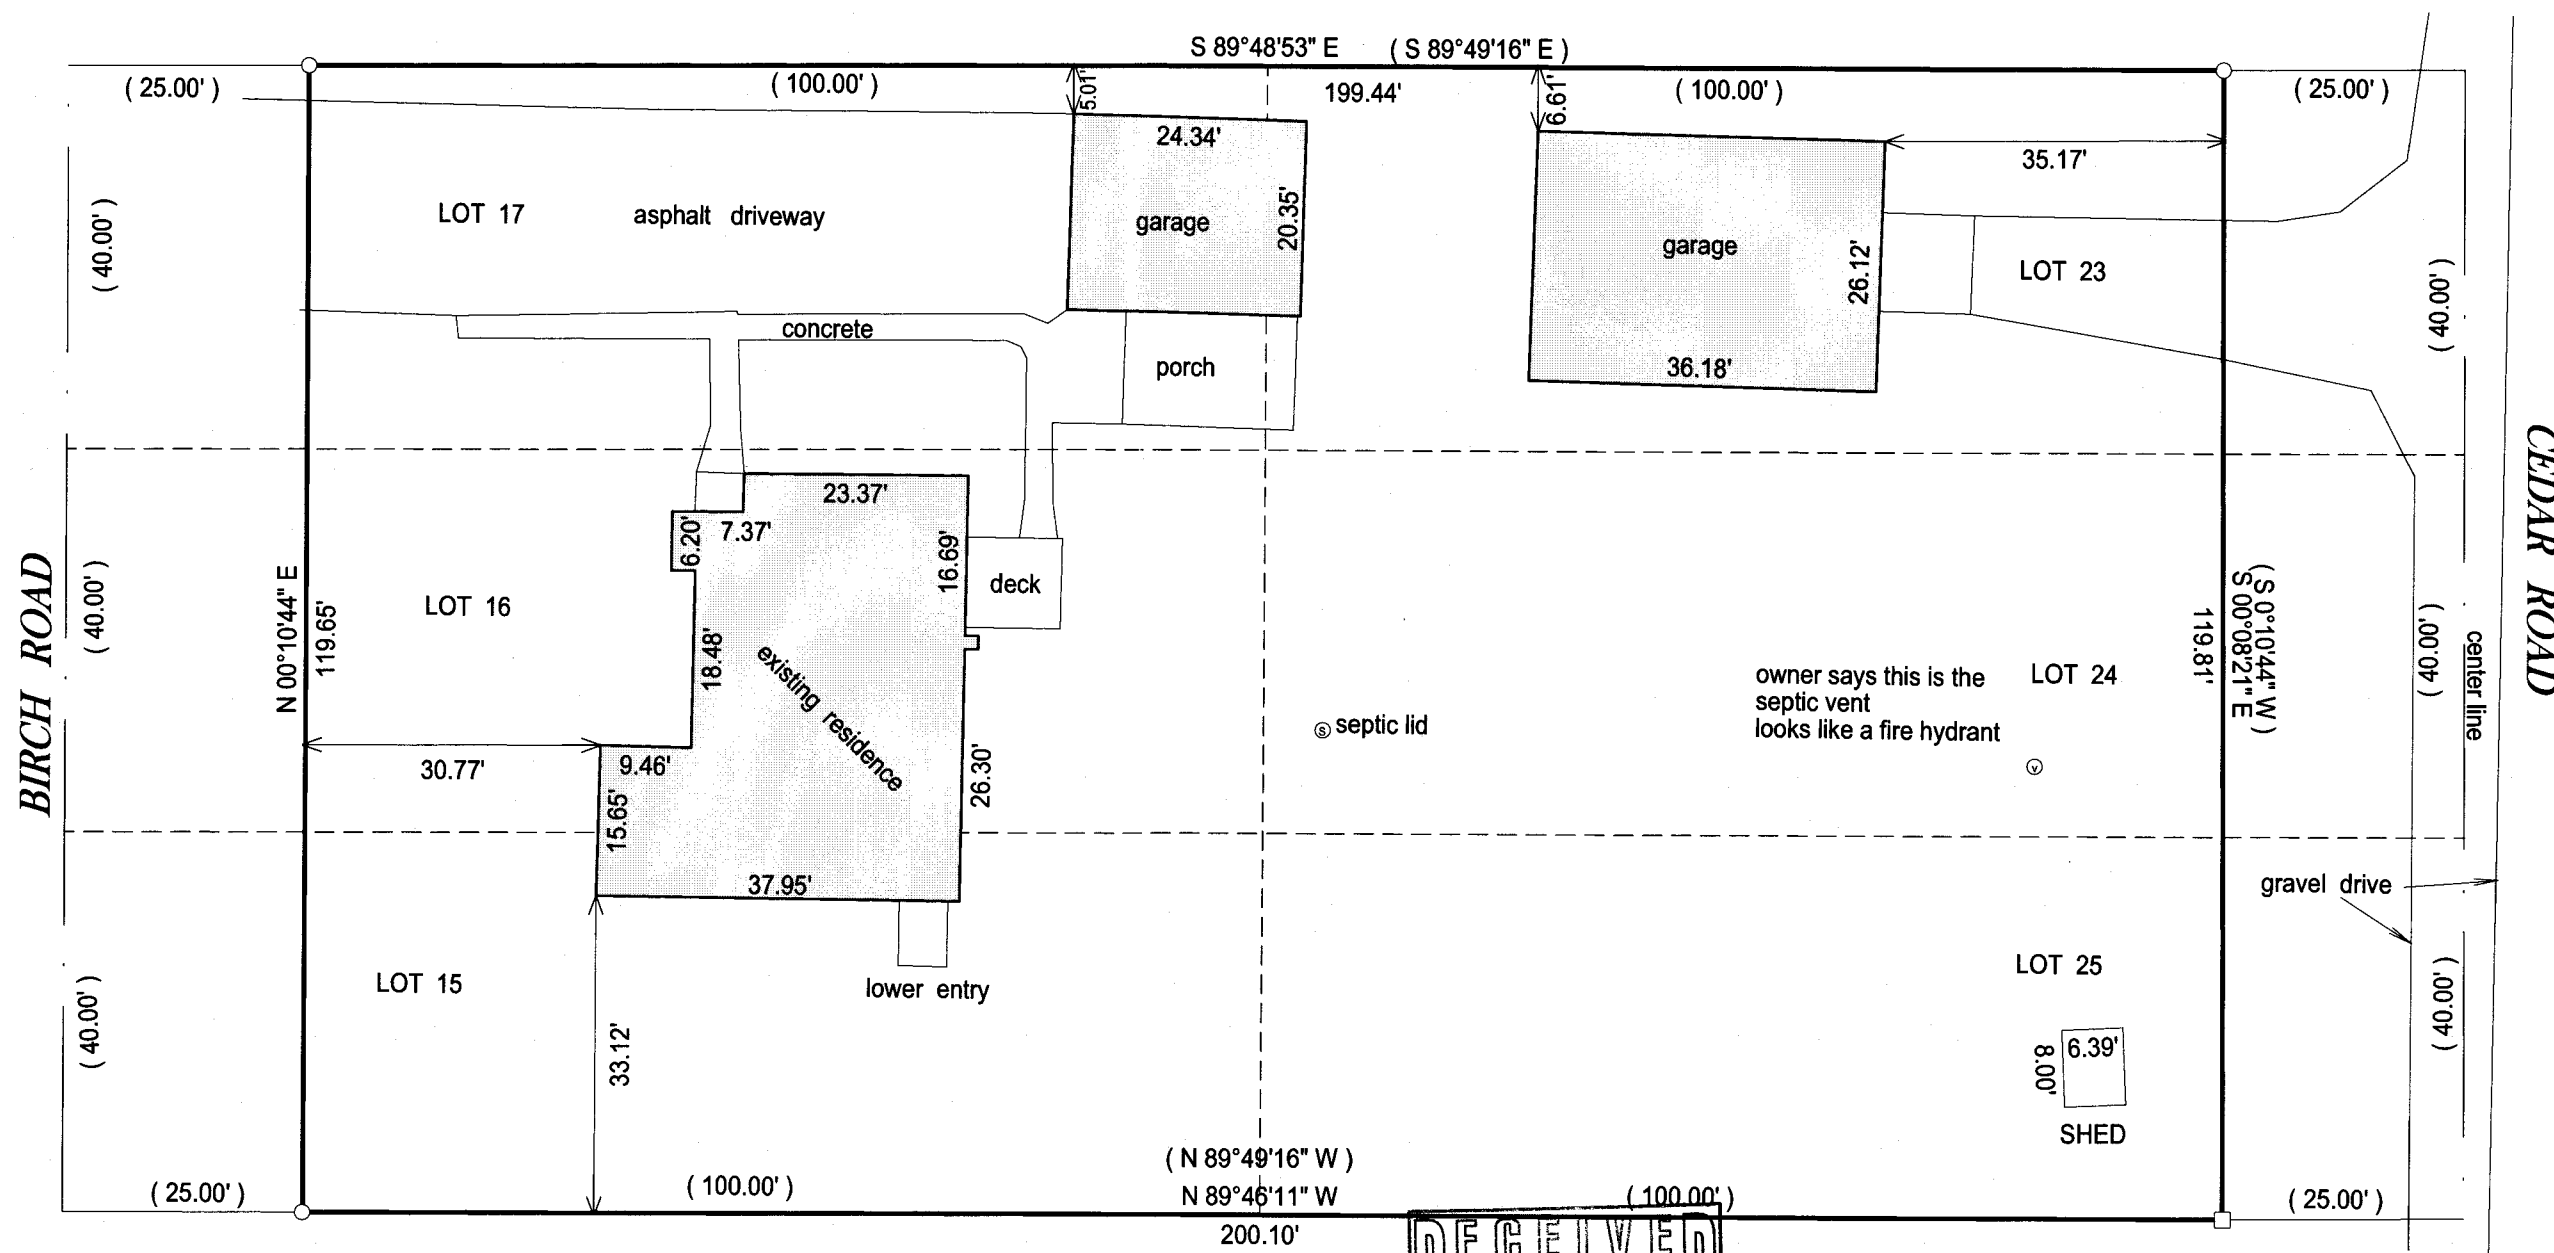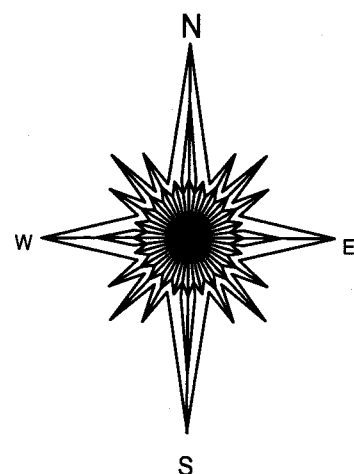

- () = recorded as
□ = found iron bar
○ = found iron pipe
● = set iron pipe
■ = set iron bar

SCALE 1" = 20'

JOB # 14-173

TAX ID # GI00013 & GI00015





BASIS OF BEARING OF THIS PLAT: THE EAST LINE OF BIRCH ROAD
WAS ASSUMED TO BEAR N 00°10'44" E AS RECORDED ON THE RECORD PLAT.

I hereby certify that I have surveyed the above- described property and the
above map is a true representation thereof and shows the size and
location of the property, its exterior boundaries, the location and
dimensions of all structures thereon, fences, apparrant easements and
roadways and visible encroachments if any.

This survey is made for the present owners of the property, and those who
purchase, mortgage, or guarantee the title thereto, within one year from
the date hereof.

DATED THIS 31ST DAY OF JULY, 2014.

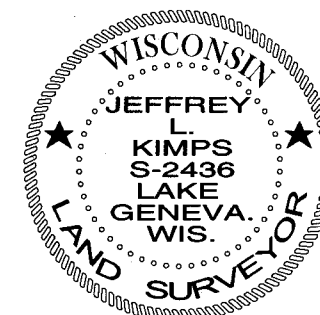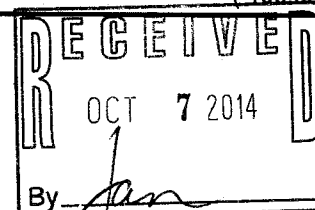

JEFFREY L. KIMPS S - 2436
Wisconsin Registered Land Surveyor
(original if signed in red)

GI - 13
GI - 15

316-2195