## FARRIS, HANSEN & ASSOC. INC.

## PLAT OF SURVEY

LOT 1 OF CSM 3619


LOCATED IN THE NE 1/4 OF THE SW 1/4 SEC. 2 TOWN 3 NORTH, RANGE 16 EAST WALWORTH COUNTY, WI.

7 RIDGWAY COURT- P.O. BOX 437 ELKHORN, WISCONSIN 53121 PHONE (262) 723-2098 FAX (262) 723-5886 ORDERED BY: CHAD ZEPEZAUER N6601 ASPEN ROAD ELKHORN, WI. 53121

LEGEND

O = FOUND IRON PIPE STAKE = FOUND IRON REBAR STAKE

KENOSHA DRIVE

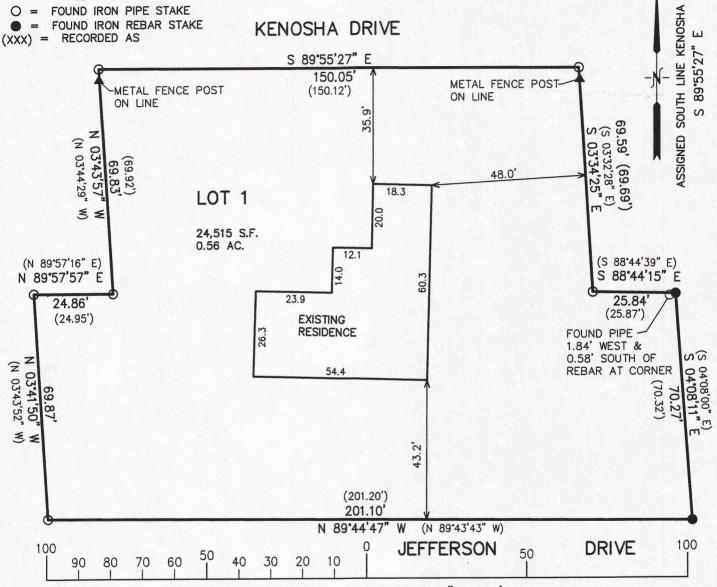

MAP SCALE IN FEET ORIGINAL 1'' = 30'

NOTE: COPIES OF THIS MAP TO WHICH THE FOLLOWING CERTIFICATE WILL APPLY SHOW SURVEYOR'S ORIGINAL SEAL AND SIGNATURE IN RED INK. COPIES BY ANY OTHER MEANS MAY HAVE ALTERATIONS WHICH DO NOT REPRESENT THE SURVEYOR'S WORK PRODUCT.

I HEREBY CERTIFY THAT THE ABOVE DESCRIBED PROPERTY HAS BEEN SURVEYED UNDER MY DIRECTION AND THAT THE ABOVE MAP IS A TRUE REPRESENTATION THEREOF AND SHOWS THE SIZE AND LOCATION OF THE PROPERTY AND ITS EXTERIOR BOUNDARIES. THIS SURVEY IS MADE FOR THE USE OF THE PRESENT OWNERS OF THE PROPERTY, AND ALSO THOSE WHO PURCHASE, MORTGAGE, OR GUARANTEE THE TITLE THERETO WITHIN ONE YEAR FROM THE DATE HEREOF.

DATED: SEPTEMBER 16, 2014

R.L.S. 2101 GORDON PETER S. 16

GA3619-

**6** 2015

316-2200



DRIVE

PROJECT NO. 9141 DATED: 09-16-2014 SHEET 1 OF 1 SHEETS